


220-03


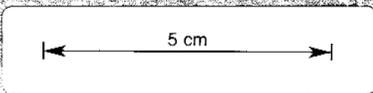


# NORTH SECTIONS

## PLAN

Showing Work done during Year 1910

Scale 25 ft = One inch

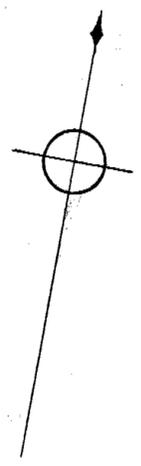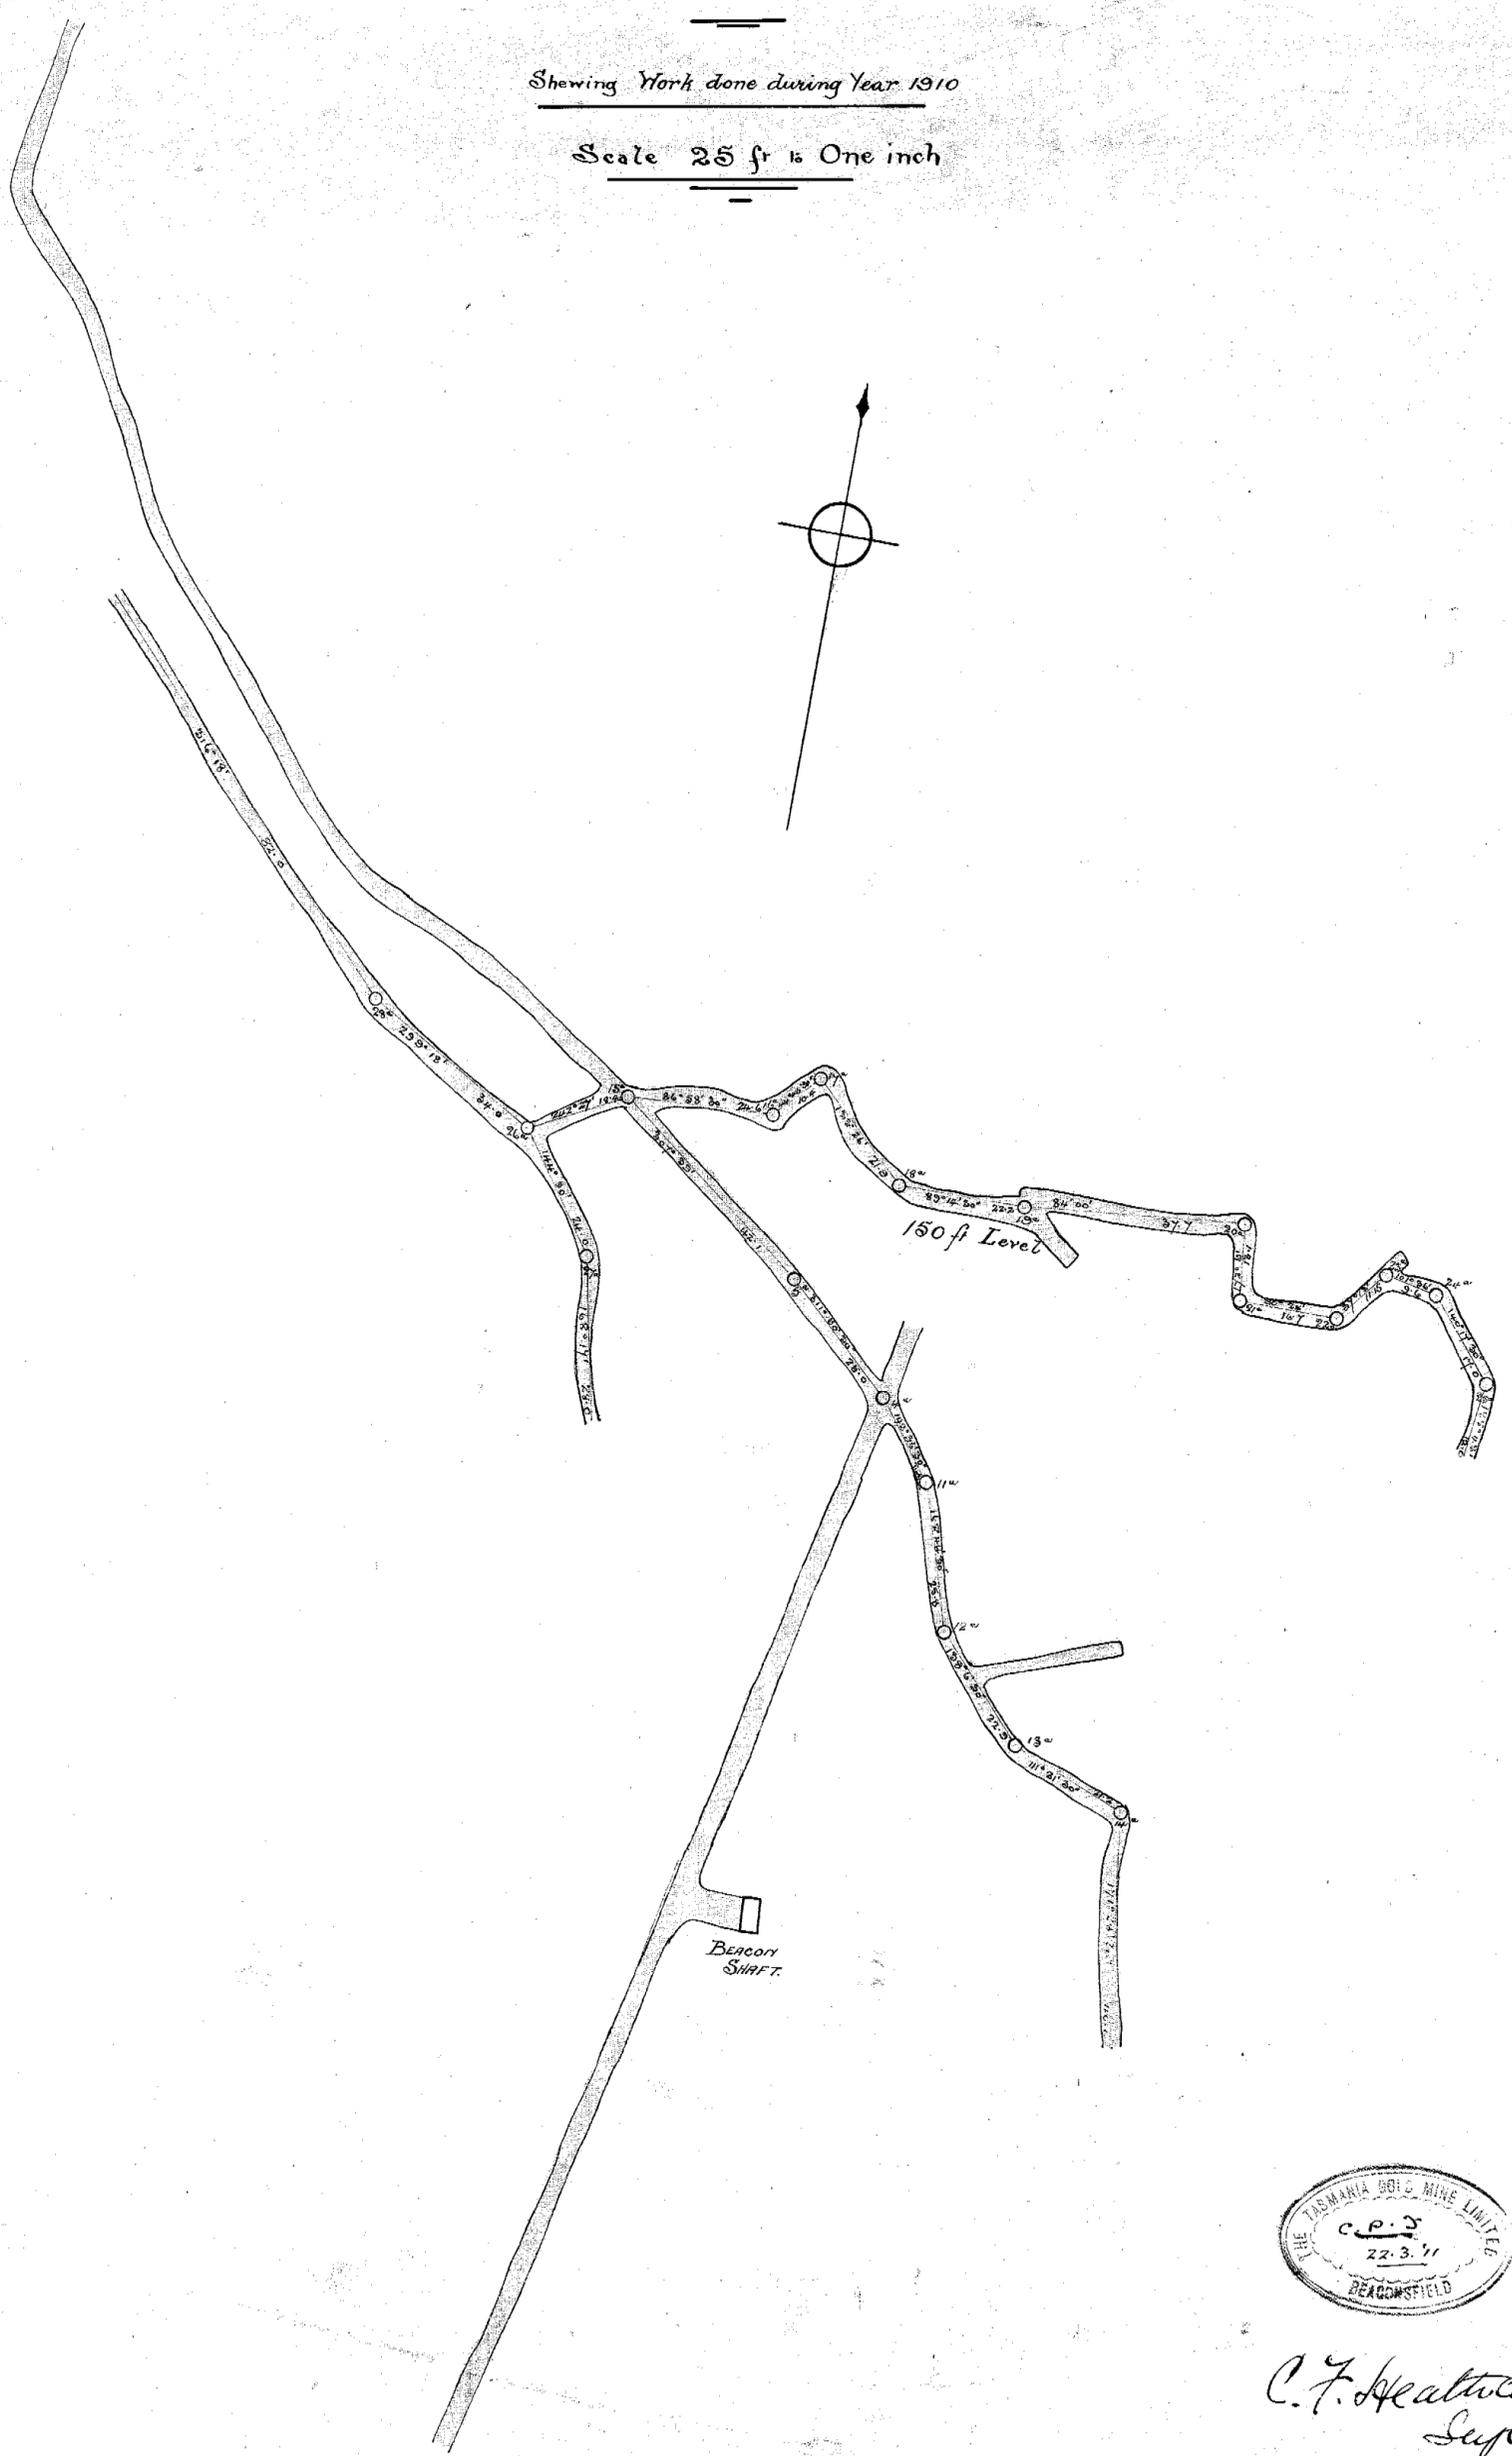

C. F. Heathcote  
Supt.