
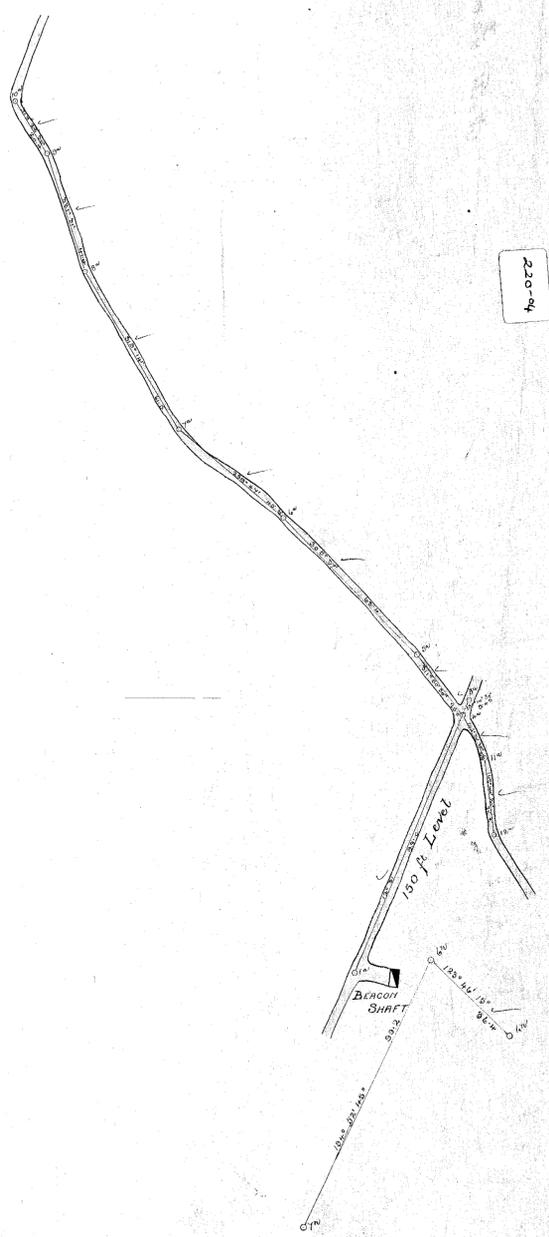


NORTH SECTIONS

PLAN

Scale 25 ft to One inch

Main Shaft

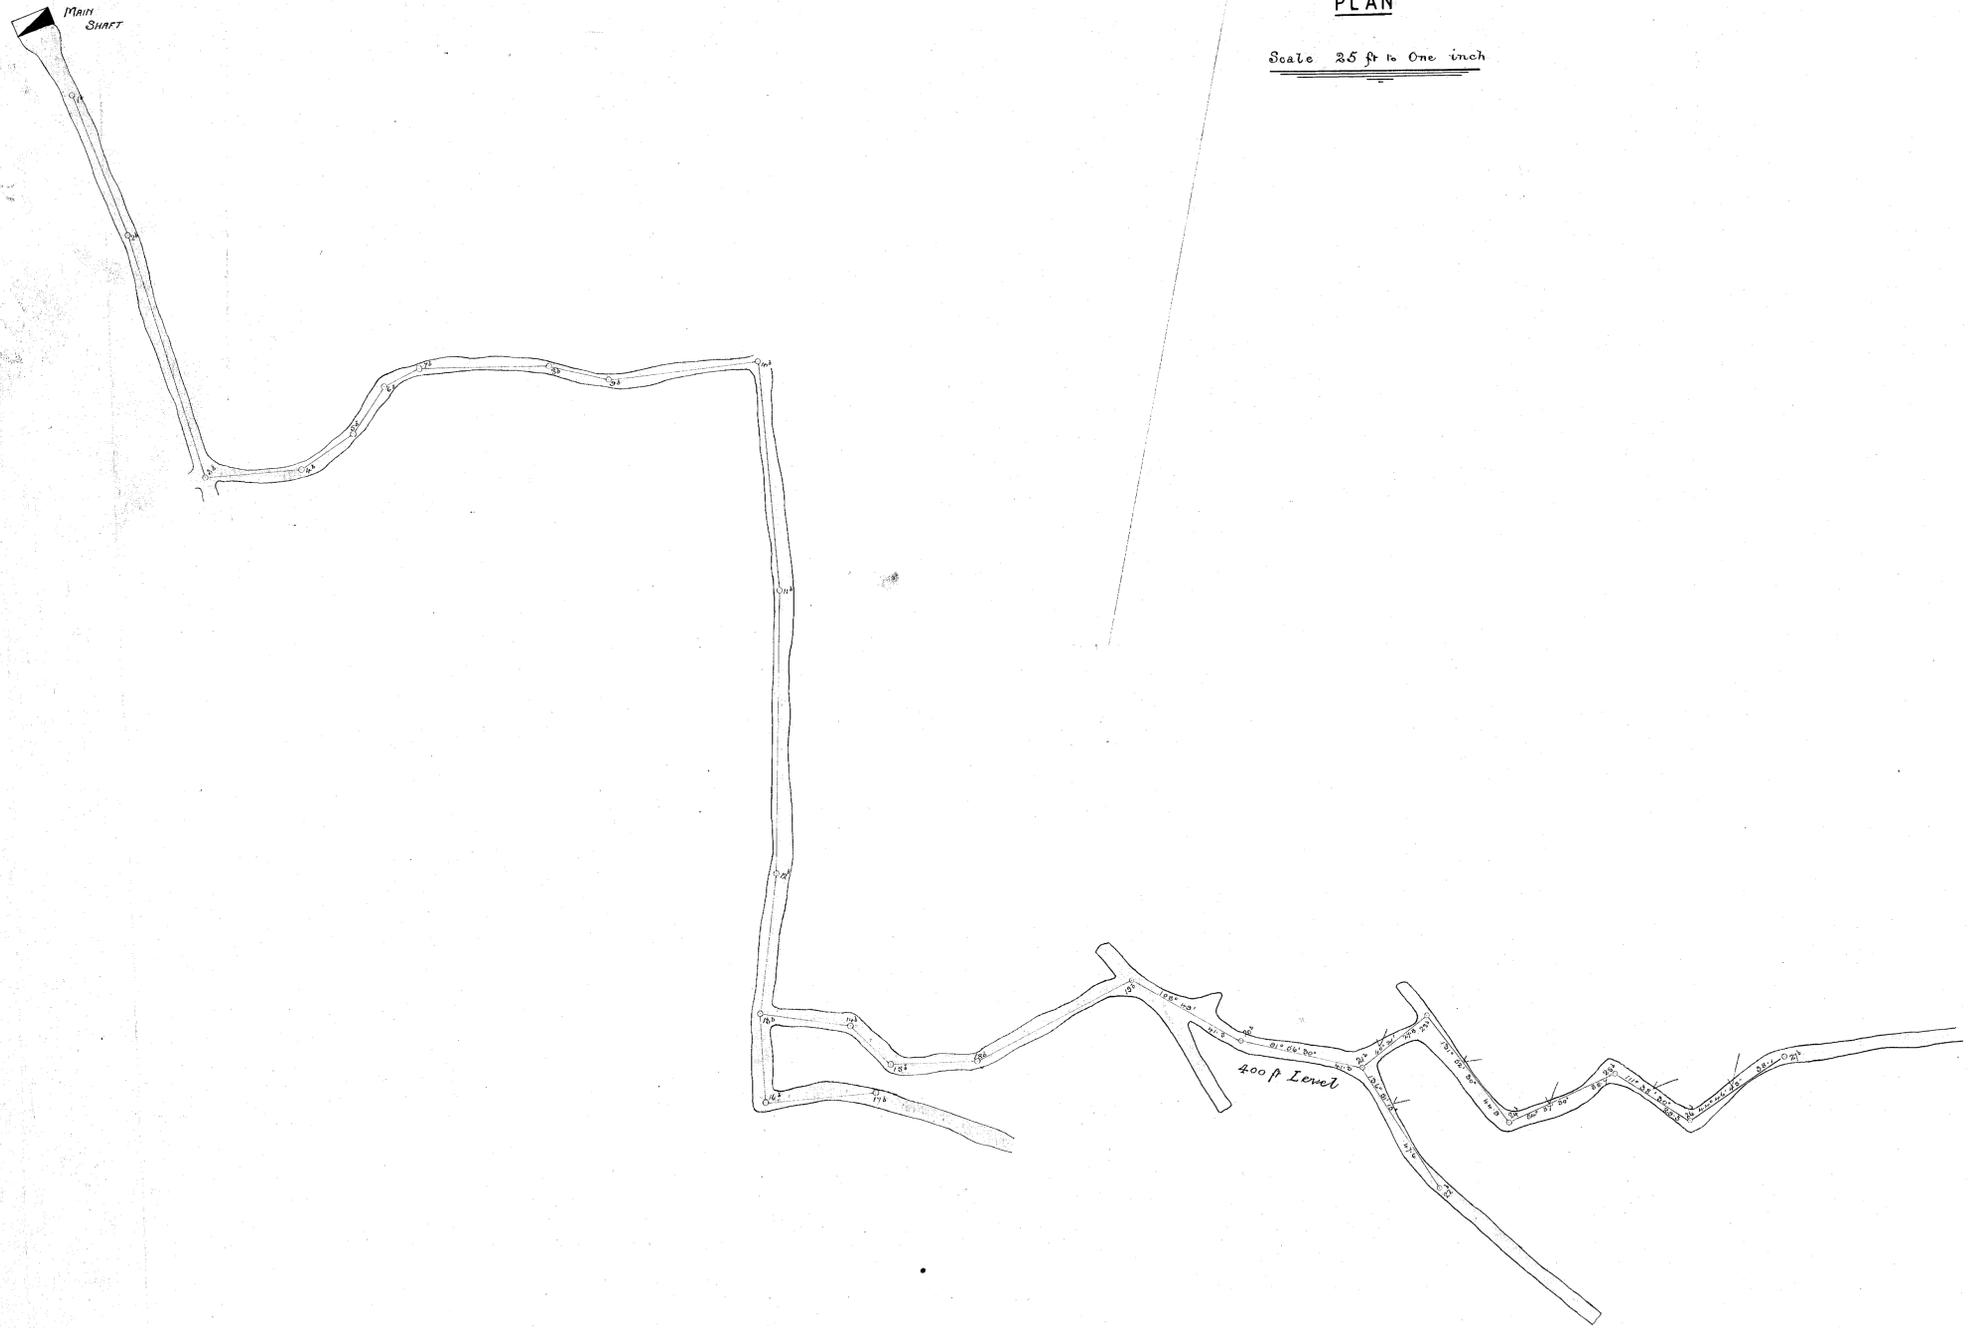

220-4



C. F. Heathcote
Supt
Mine Manager