


S. 56° 50' W.

N. 56° 50' E.

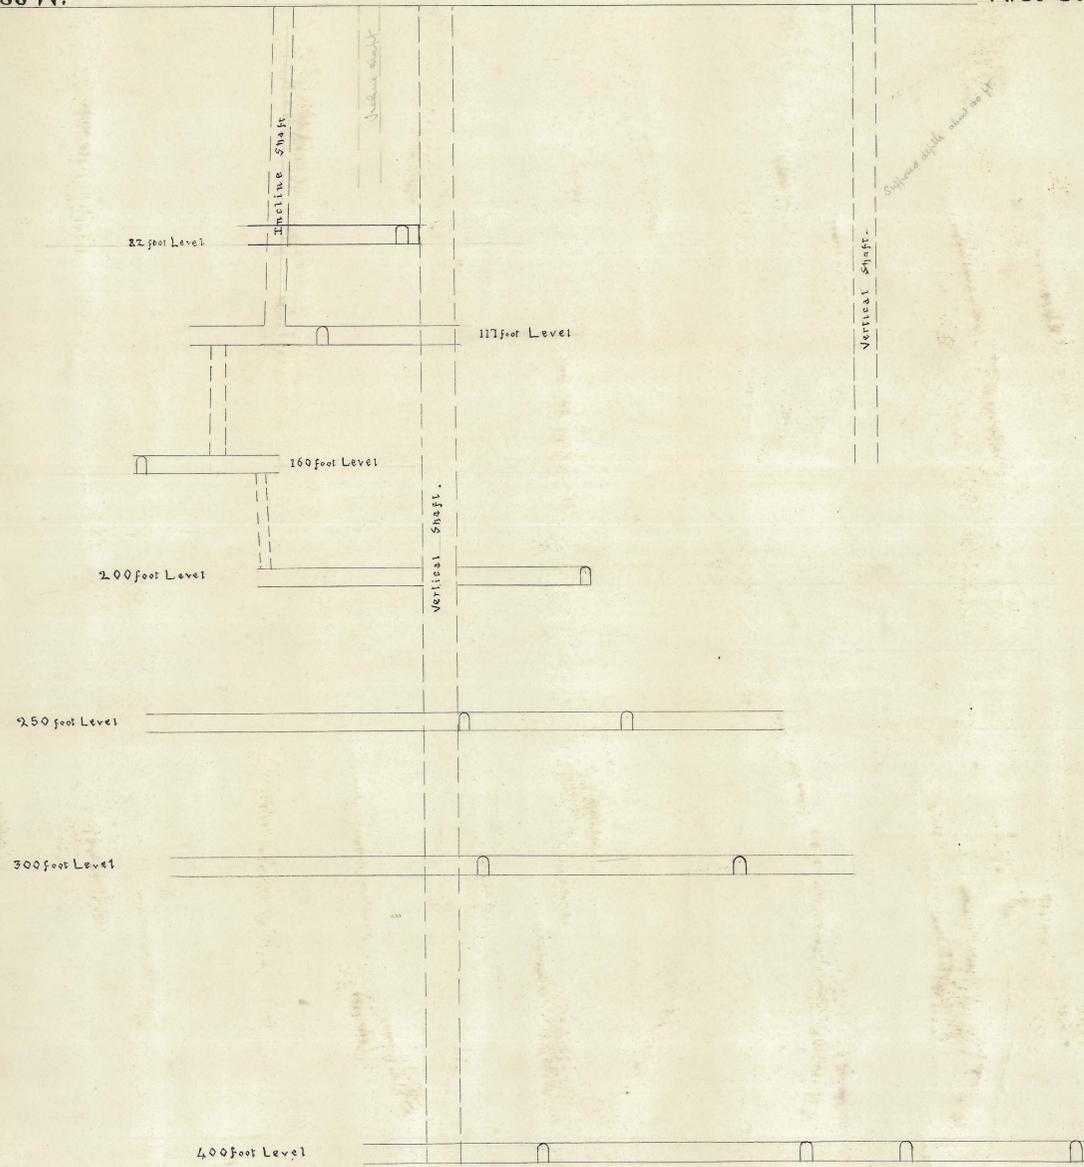

NORTH TASMANIA

MINE .

P342

5m

220-05