


S. 56° 50' W.

N. 56° 50' E.

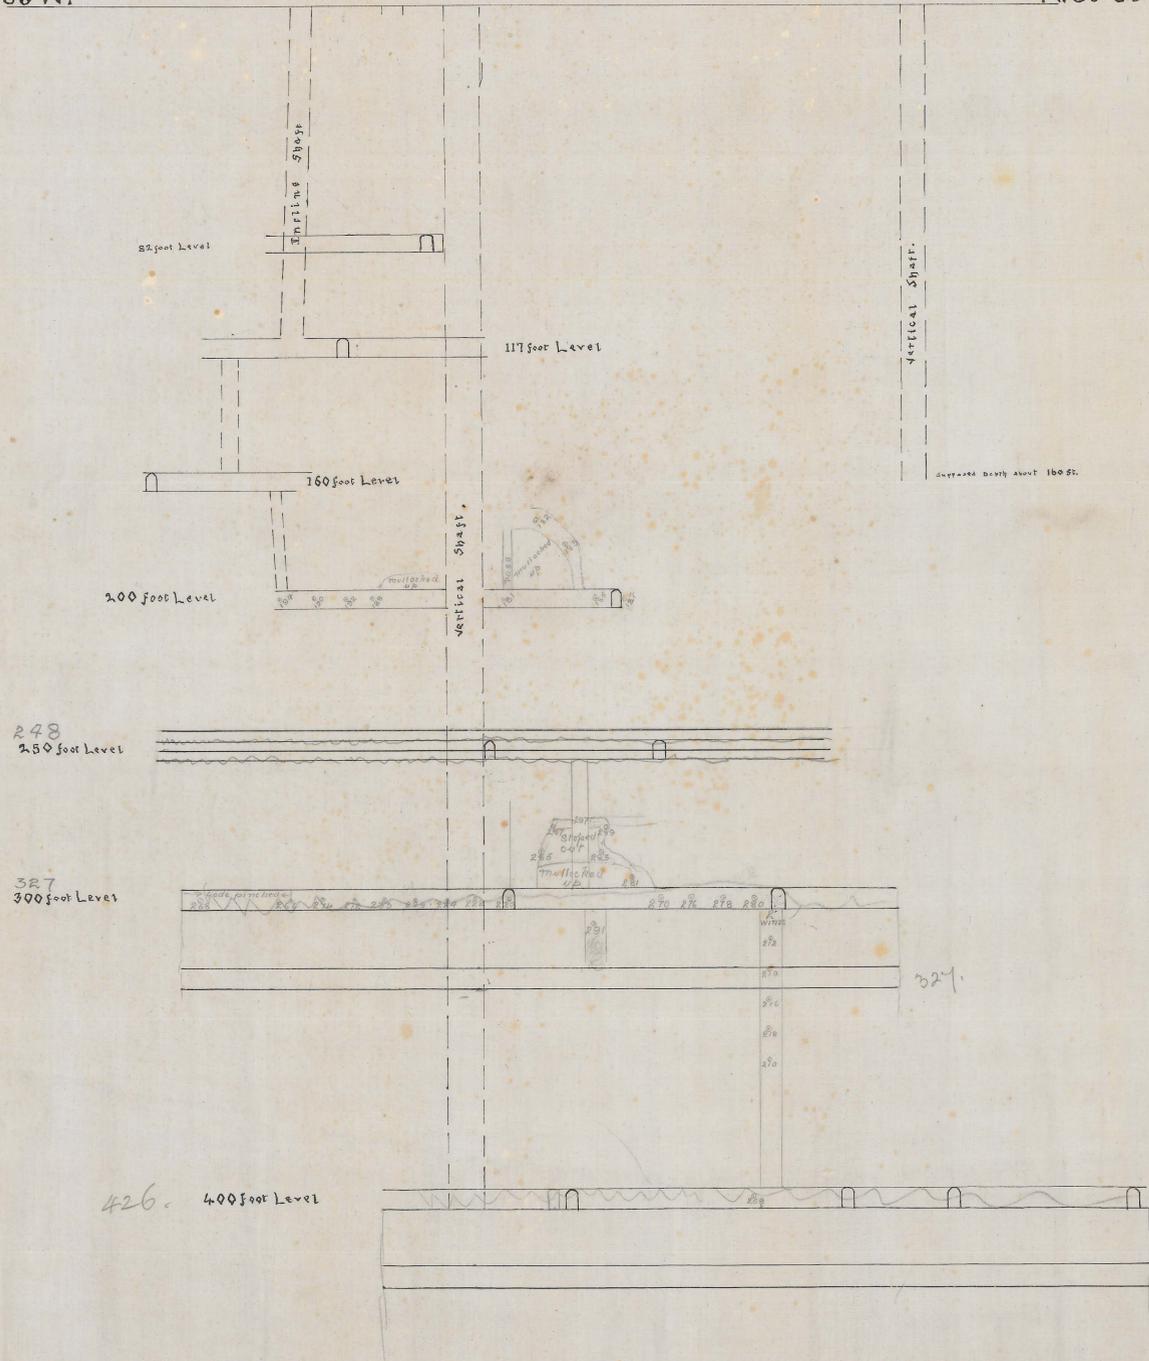

NORTH TASMANIA

MINE

P 33

0220-008

5m
0220-008