


# PLAN of UNDERGROUND WORKINGS MAGNET SILVER MINING CO. N.L.

Scale 25 Feet to an inch

## 1897

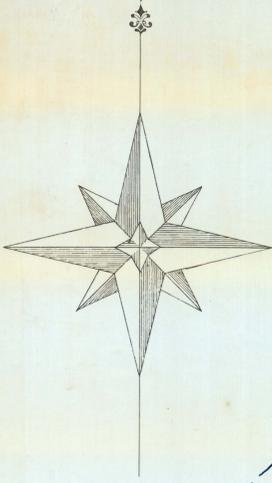

Ground Plan.

3705  
87M

20 AC.

TRAVERSE ON COURSE OF LODE

N<sup>o</sup> 3 DRIVE

N<sup>o</sup> 1 DRIVE

N<sup>o</sup> 2 DRIVE

Transverse Section

Ore Shed

N<sup>o</sup> 2 DRIVE

N<sup>o</sup> 1 DRIVE

DATUM OF LEVELS

I the undersigned hereby declare this Plan to be sufficiently correct for the purposes of the Mining Act 1895

*Handwritten signature*

District and Mining Surveyor  
Naratok 17-7-97

ON COURSE OF LODE

N<sup>o</sup> 3 DRIVE

N<sup>o</sup> 1 DRIVE ON LODE

Longitudinal Section

DATUM OF LEVELS

N<sup>o</sup> 2 DRIVE ON LODE

