
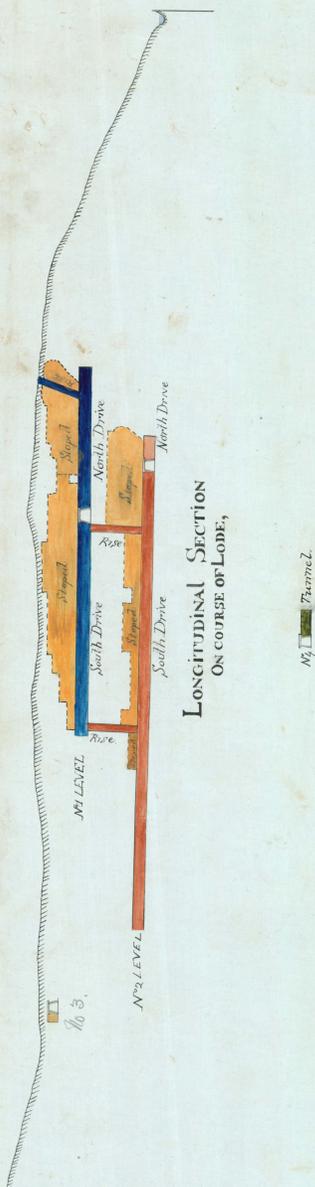


PLAN of UNDERGROUND WORKINGS MAGNET SILVER MINING CO. N.L.

Scale 40 Feet to an inch

1899.

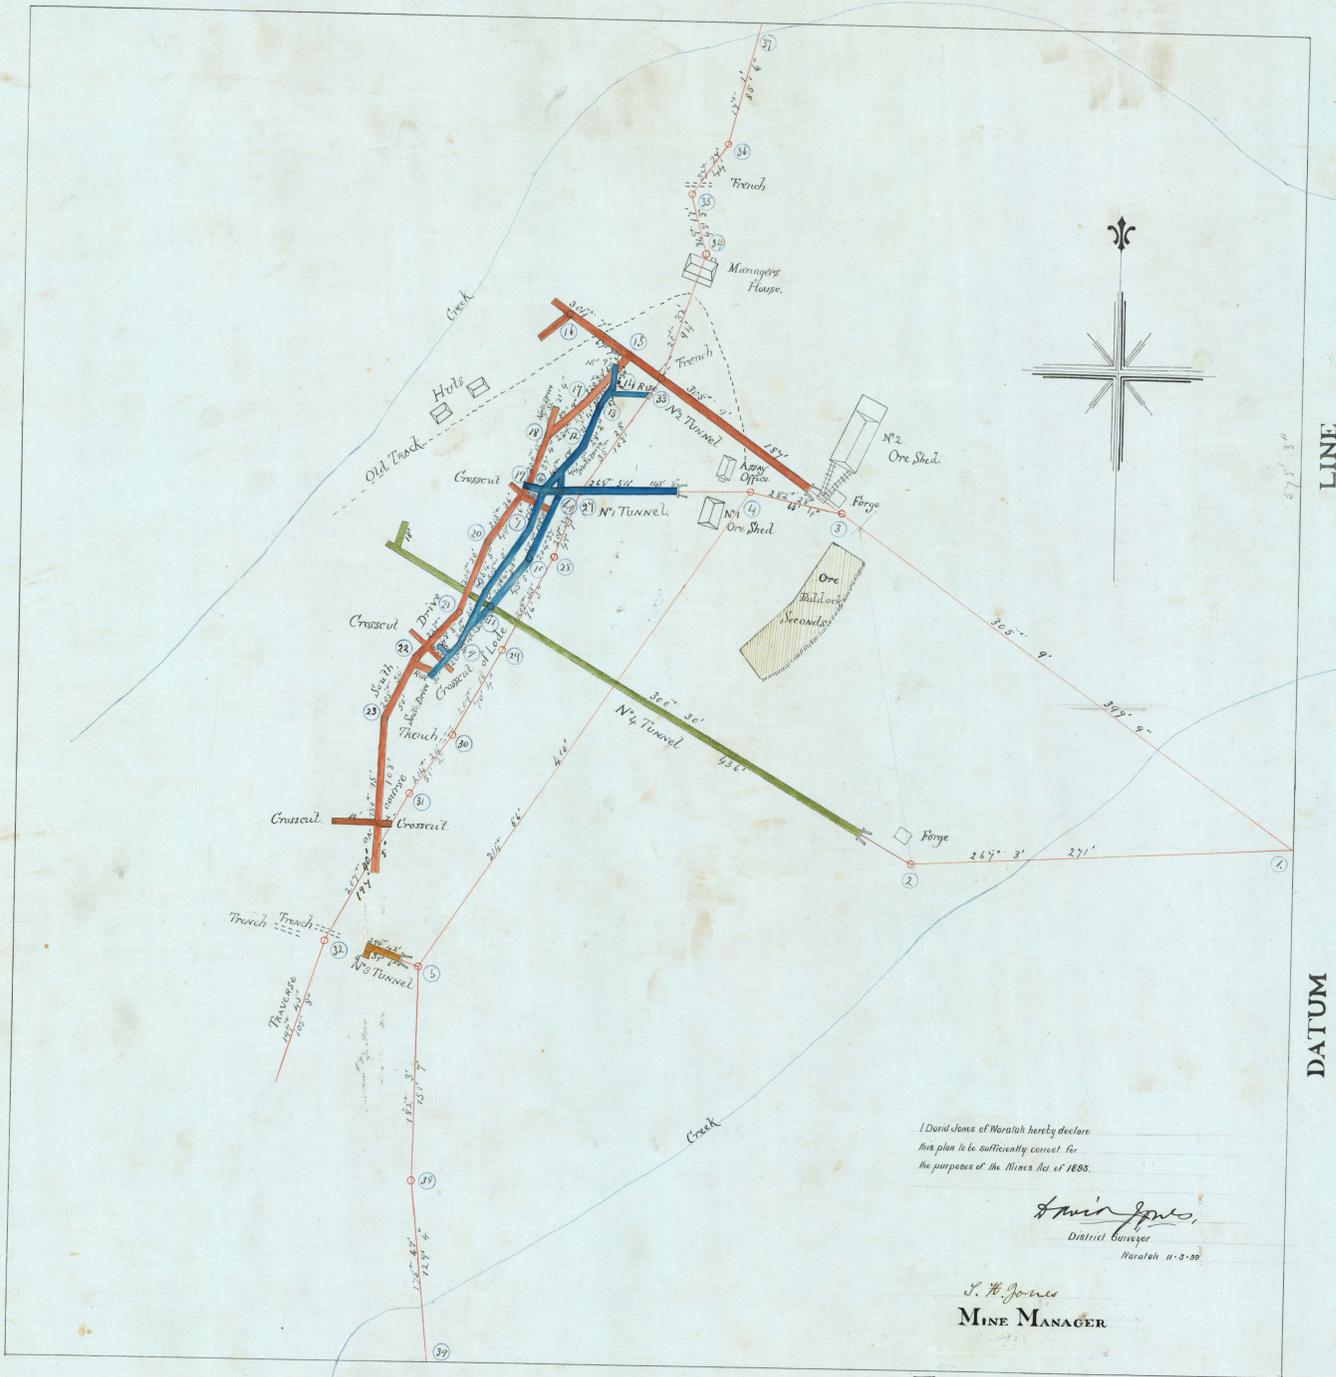

I David Jones of Waratah hereby declare
this plan to be sufficiently correct for
the purposes of the Mines Act of 1885.

David Jones
District Surveyor
Waratah 11-0-99

D. H. Jones
MINE MANAGER

