



# PLAN of UNDERGROUND WORKINGS MAGNET SILVER MINING CO. N.L.

Scale 40 Feet to an inch

**1900.**

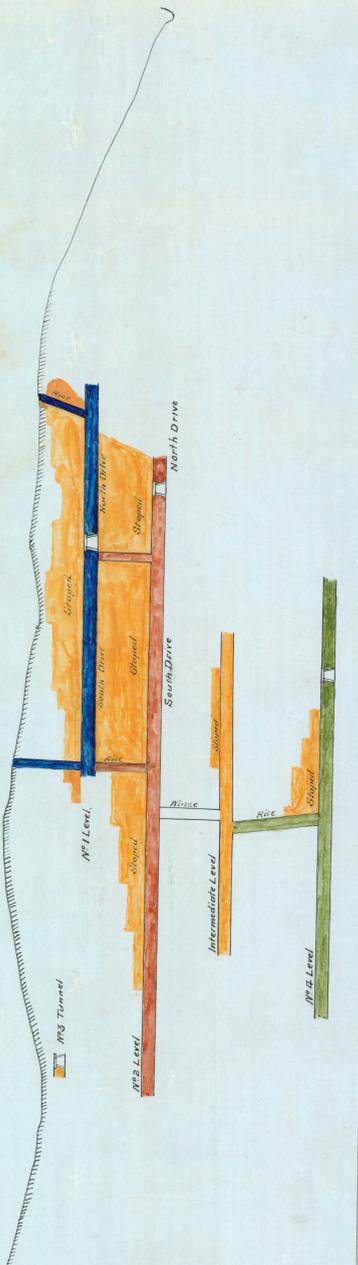

LONGITUDINAL SECTION  
ON COURSE OF LOPE.

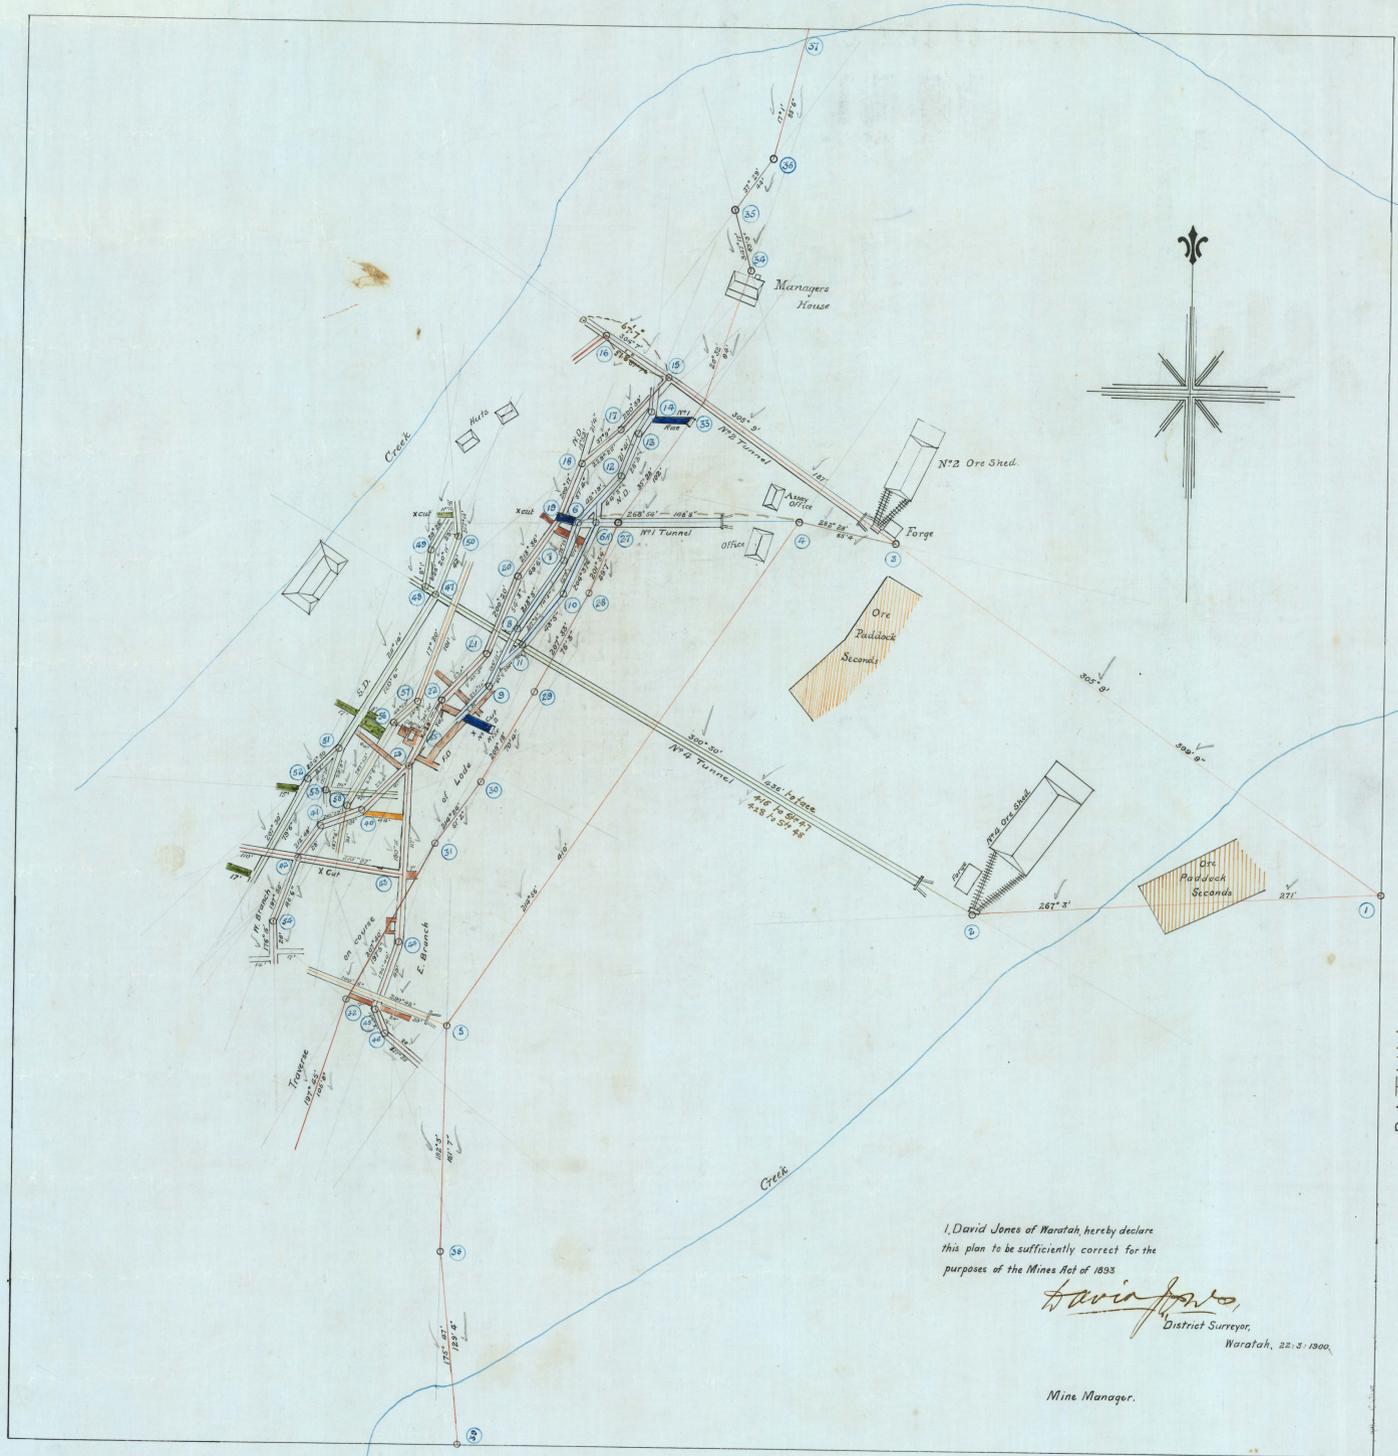

I, David Jones of Waratah, hereby declare  
this plan to be sufficiently correct for the  
purposes of the Mines Act of 1893

*David Jones*  
District Surveyor,  
Waratah, 22.5.1900.

Mine Manager.

