

221-01 221-03 221-04 221-02
Too Big Too Big Too Big Too Big

5 cm
221-04

MACNET SILVER MINING CO.


LONGITUDINAL SECTION

OF

UNDERGROUND WORKINGS

Scale - 25 Feet to An Inch

Plane of Projection perpendicular to line of No 4 Crosscut

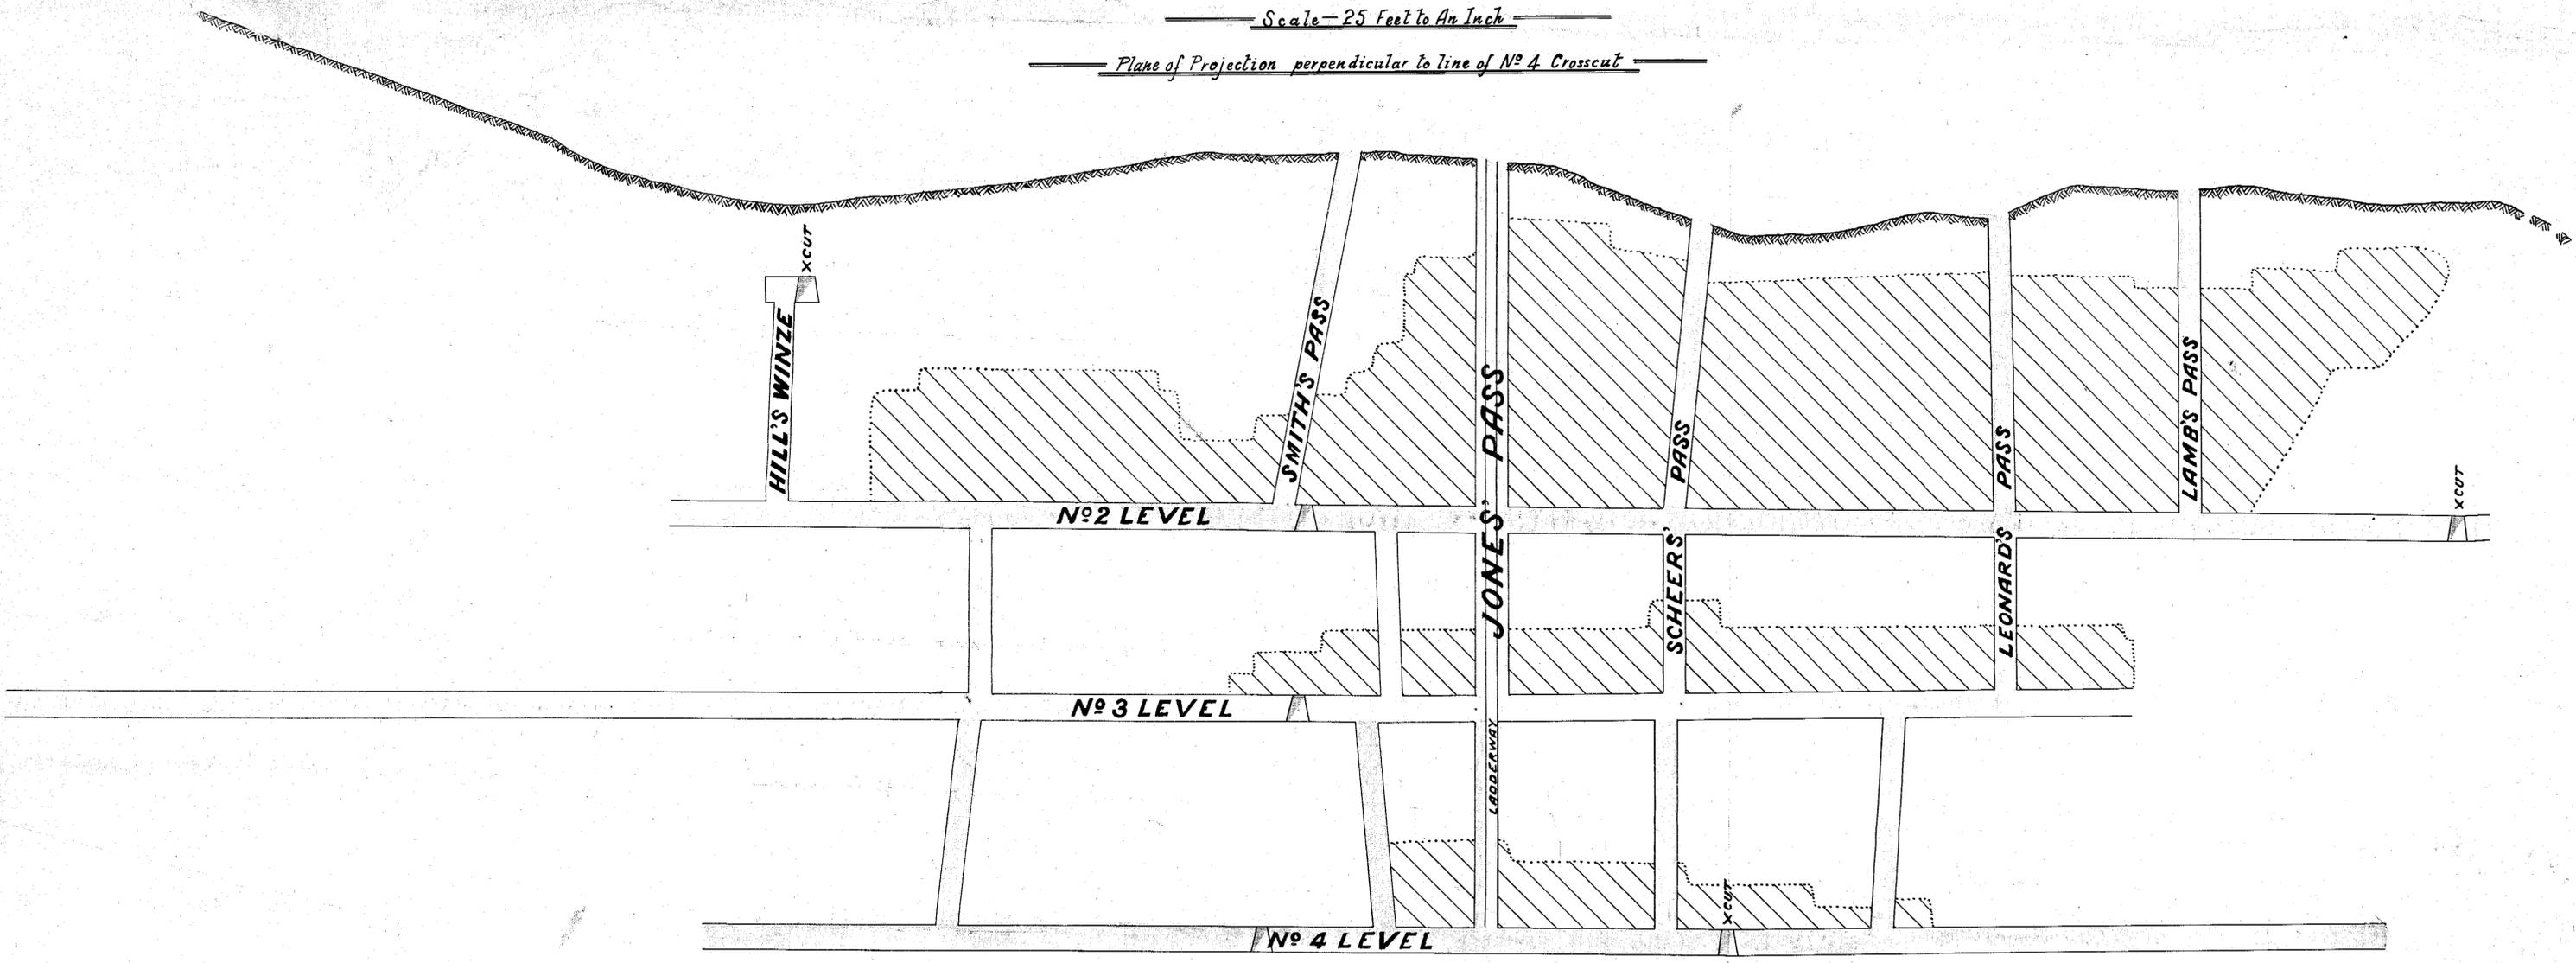

O. L. L. d. a. u. s. Authorized Surveyor
P. F. M. a. l. l. e. General Manager
January 1902