


220-05

S. 56°-50' W.

N. 56°-50' E.

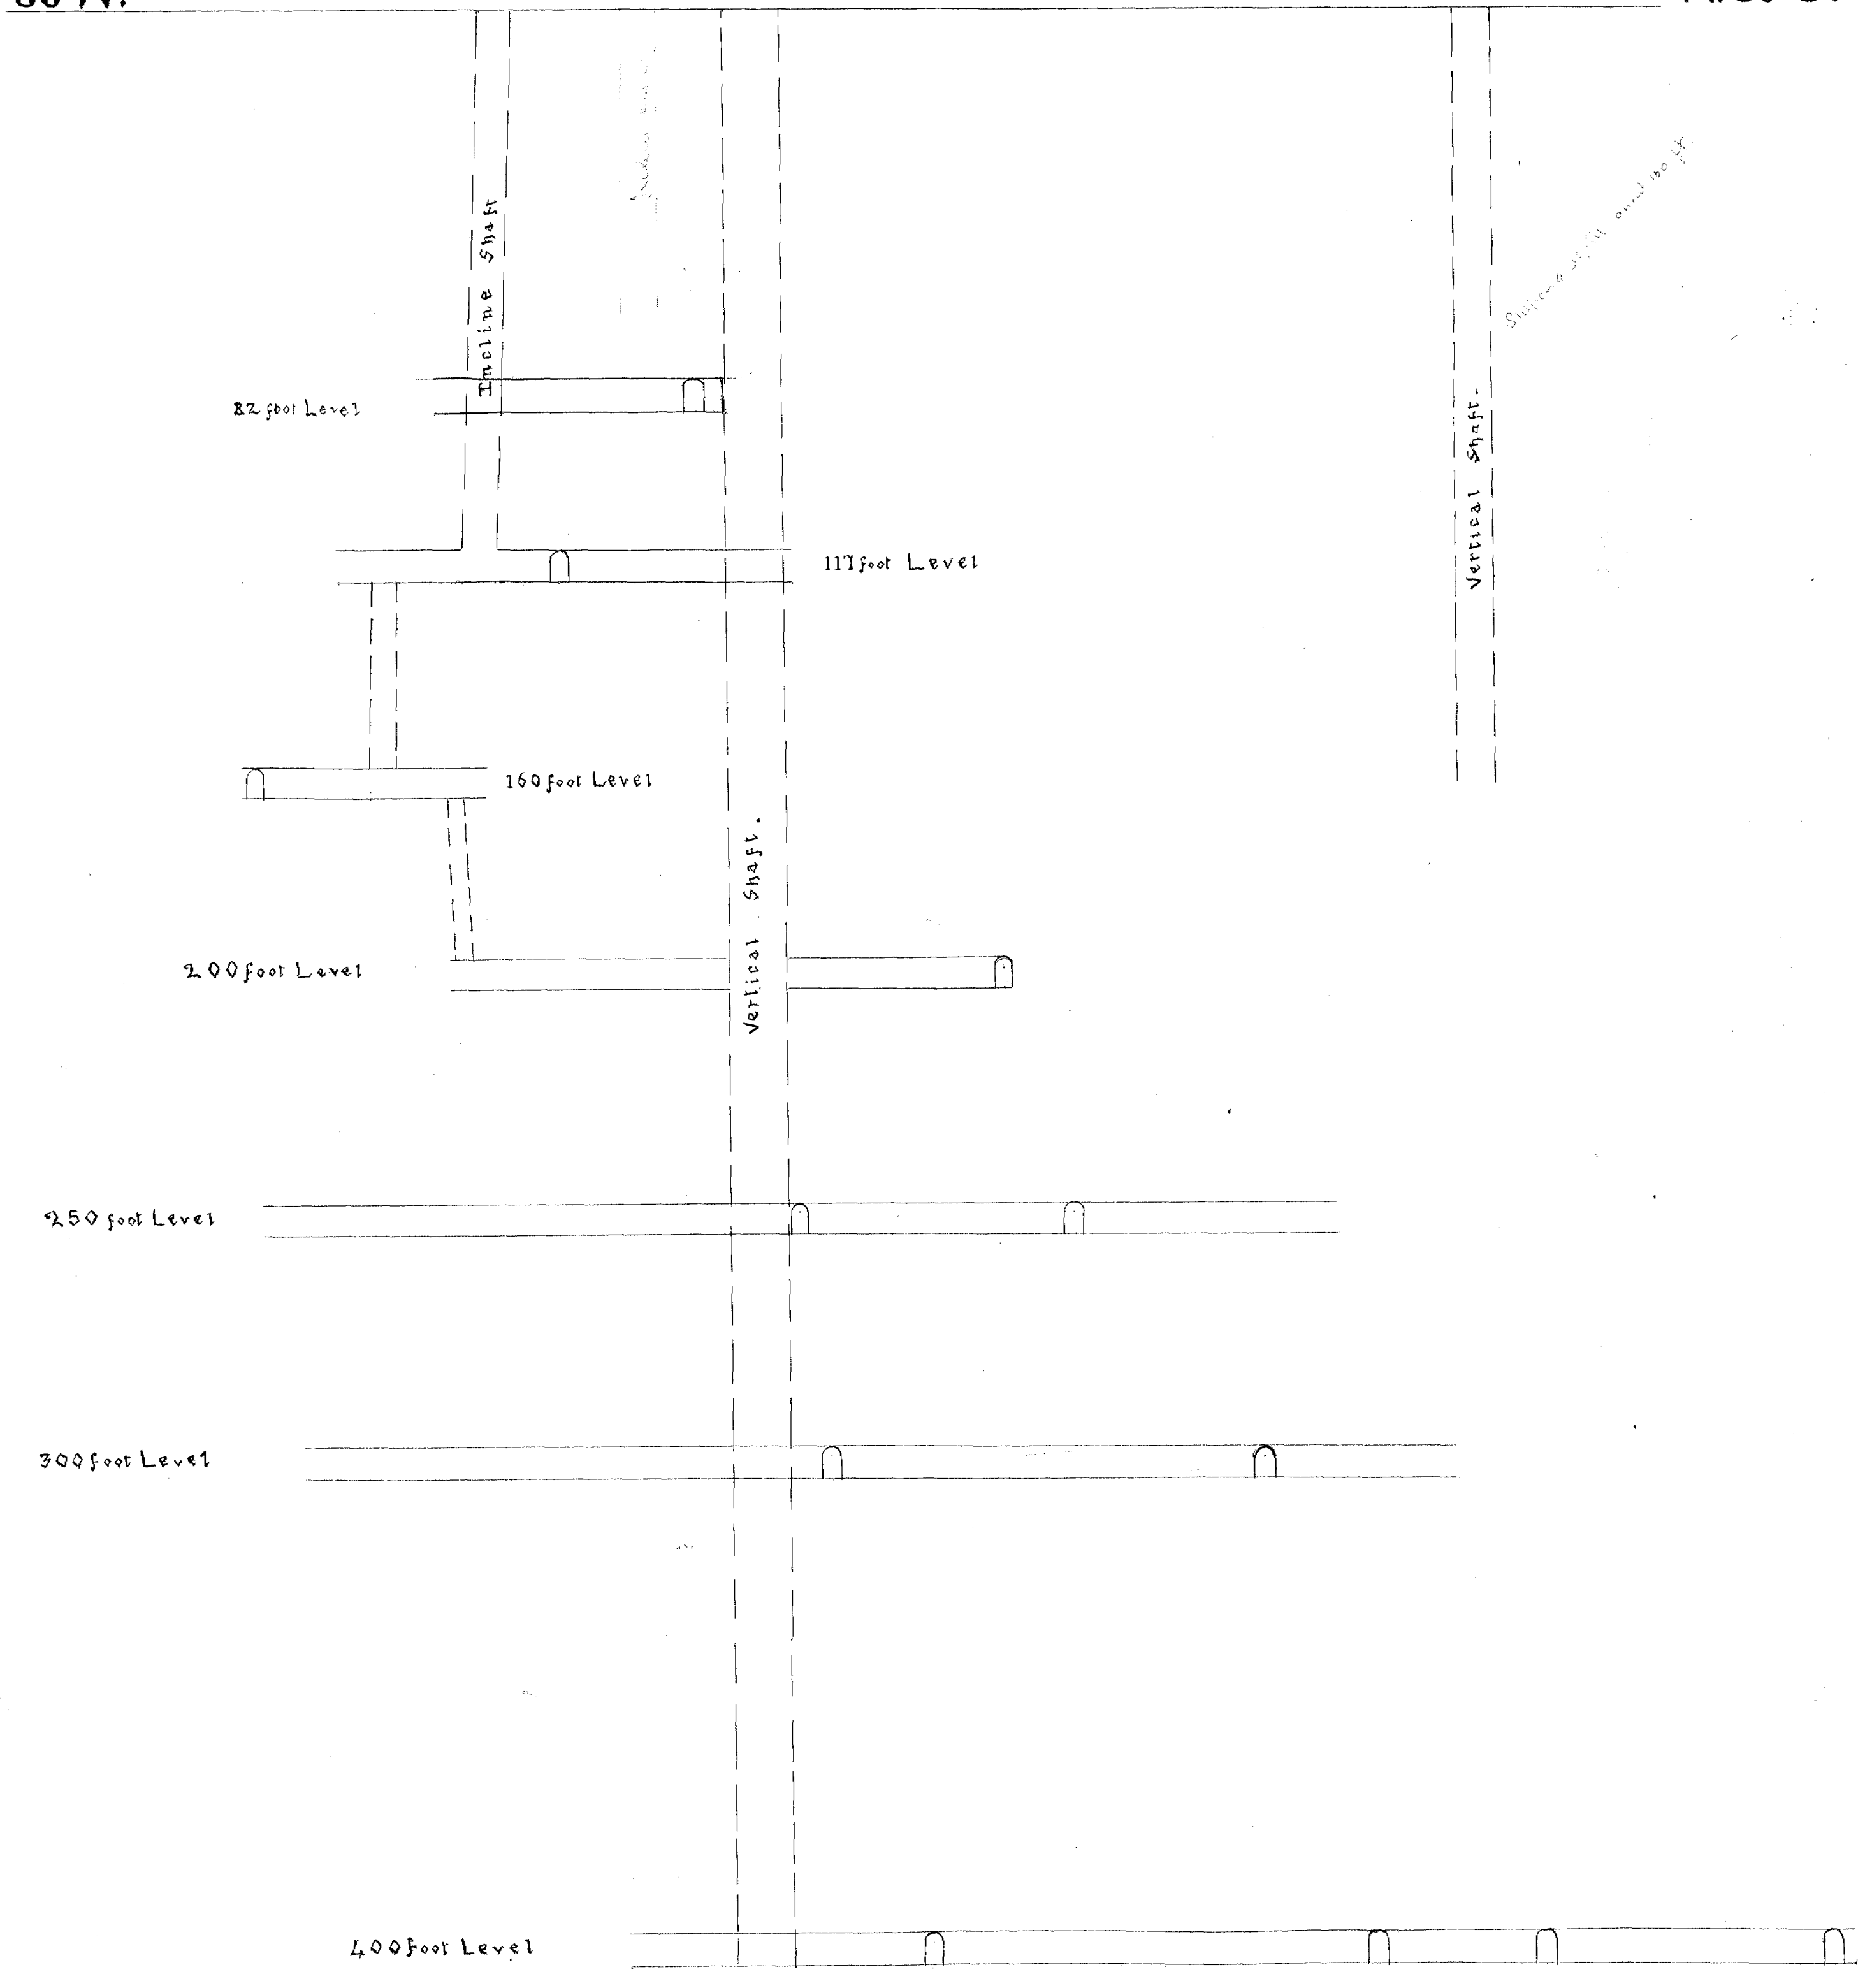

NORTH TASMANIA

MINE .

P342