


1091

West Boundary

Transverse Section

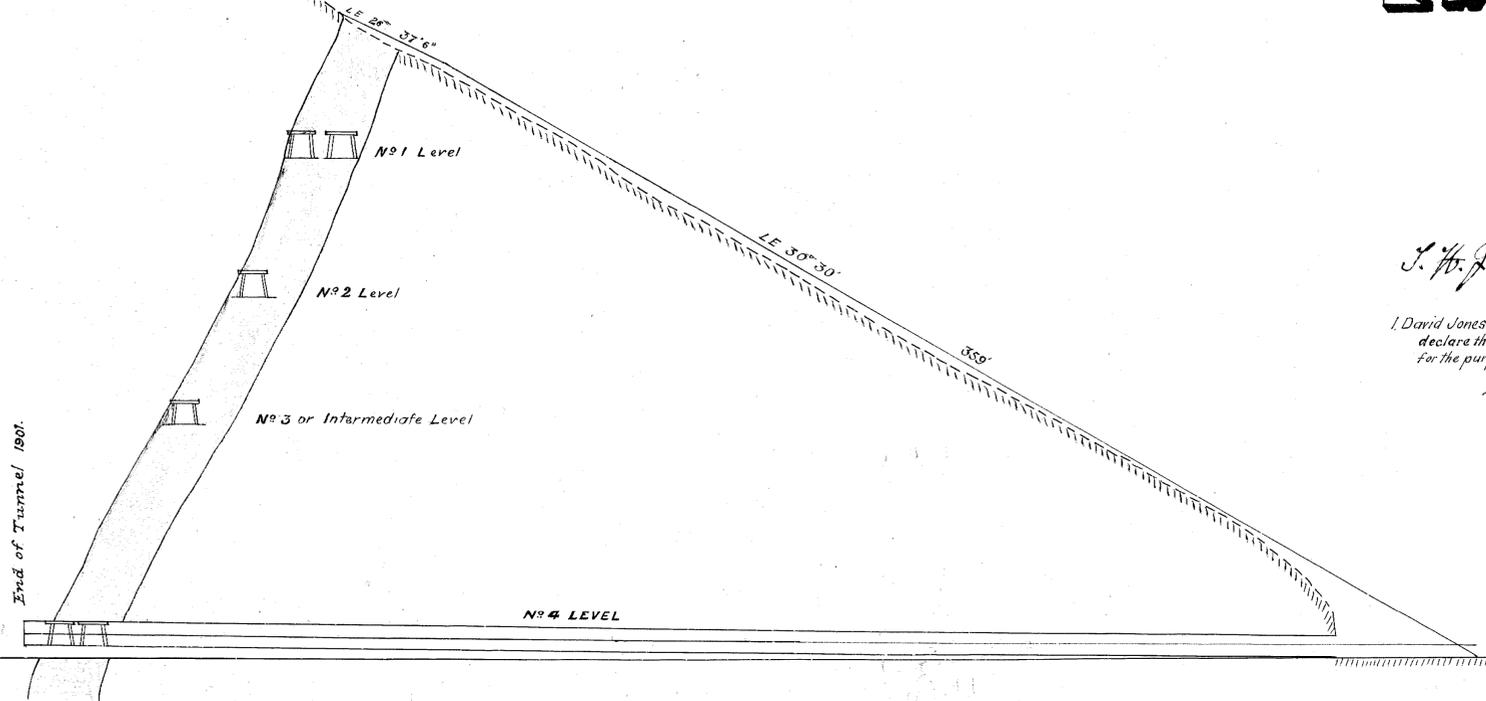

# SECTION

## MAGNET SILVER MINING CO. N.L.

Scale 25 Feet to an inch.

# 1901

*J. W. Jones* Mine Manager.

I, David Jones, Surveyor, of Waratah, hereby declare this plan to be sufficiently correct for the purposes of the Mines Act of 1898.

*David Jones* District Surveyor, Waratah, Tas.



5 cm

1091-06

221-06