



1805

Magnet Silver Mining Co.,

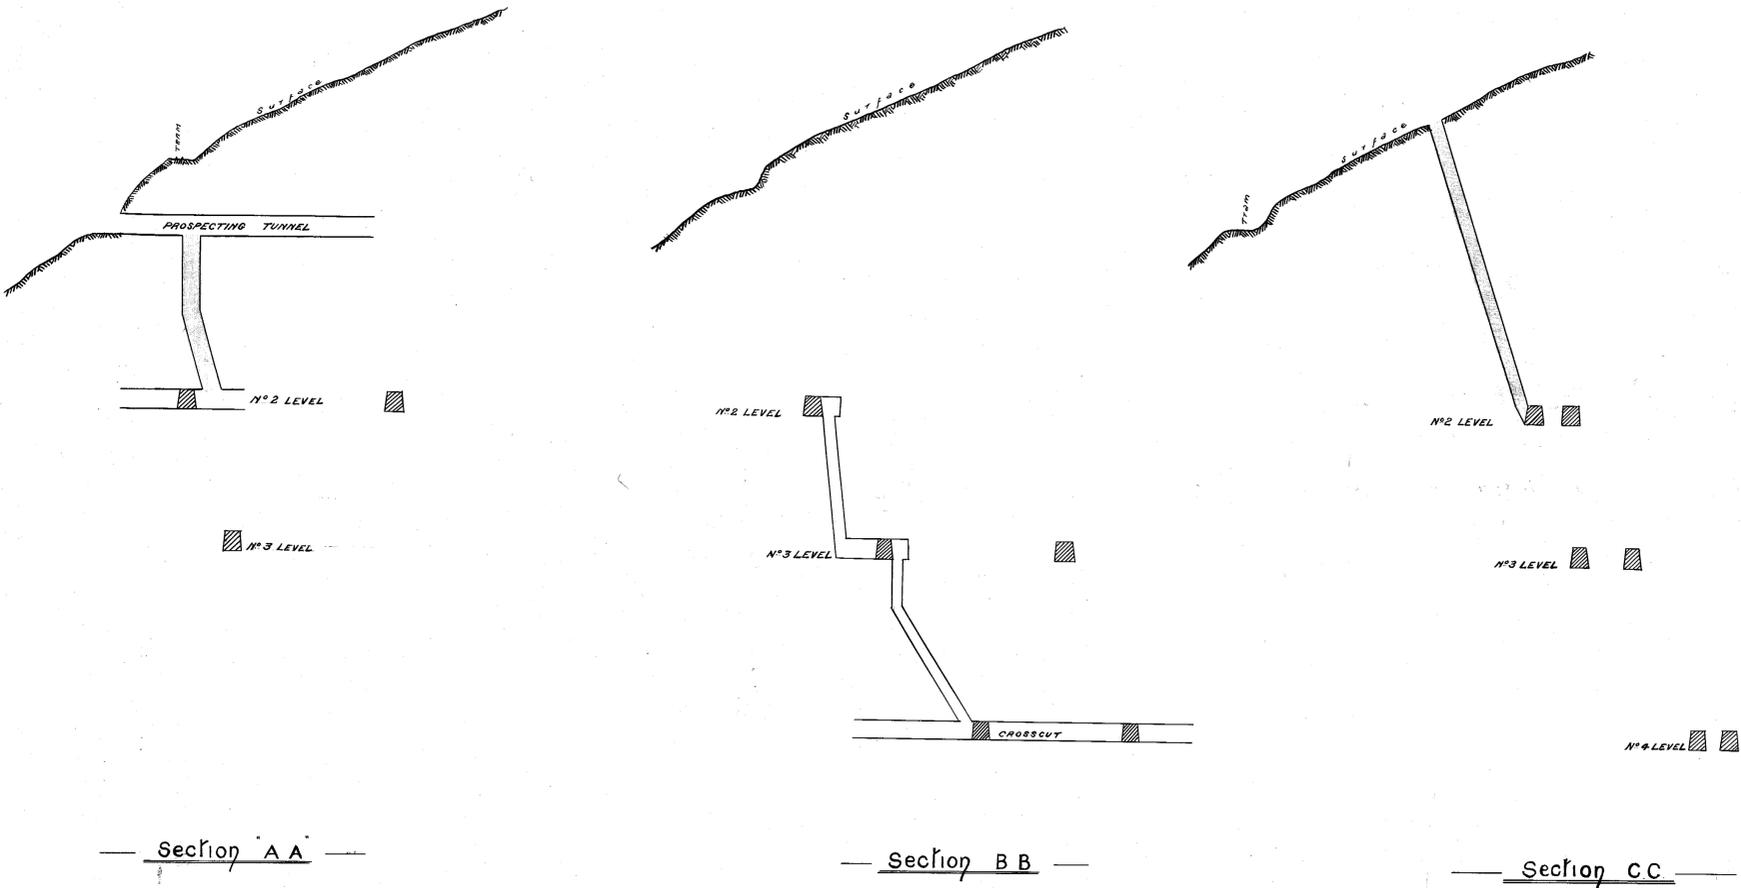

221-08

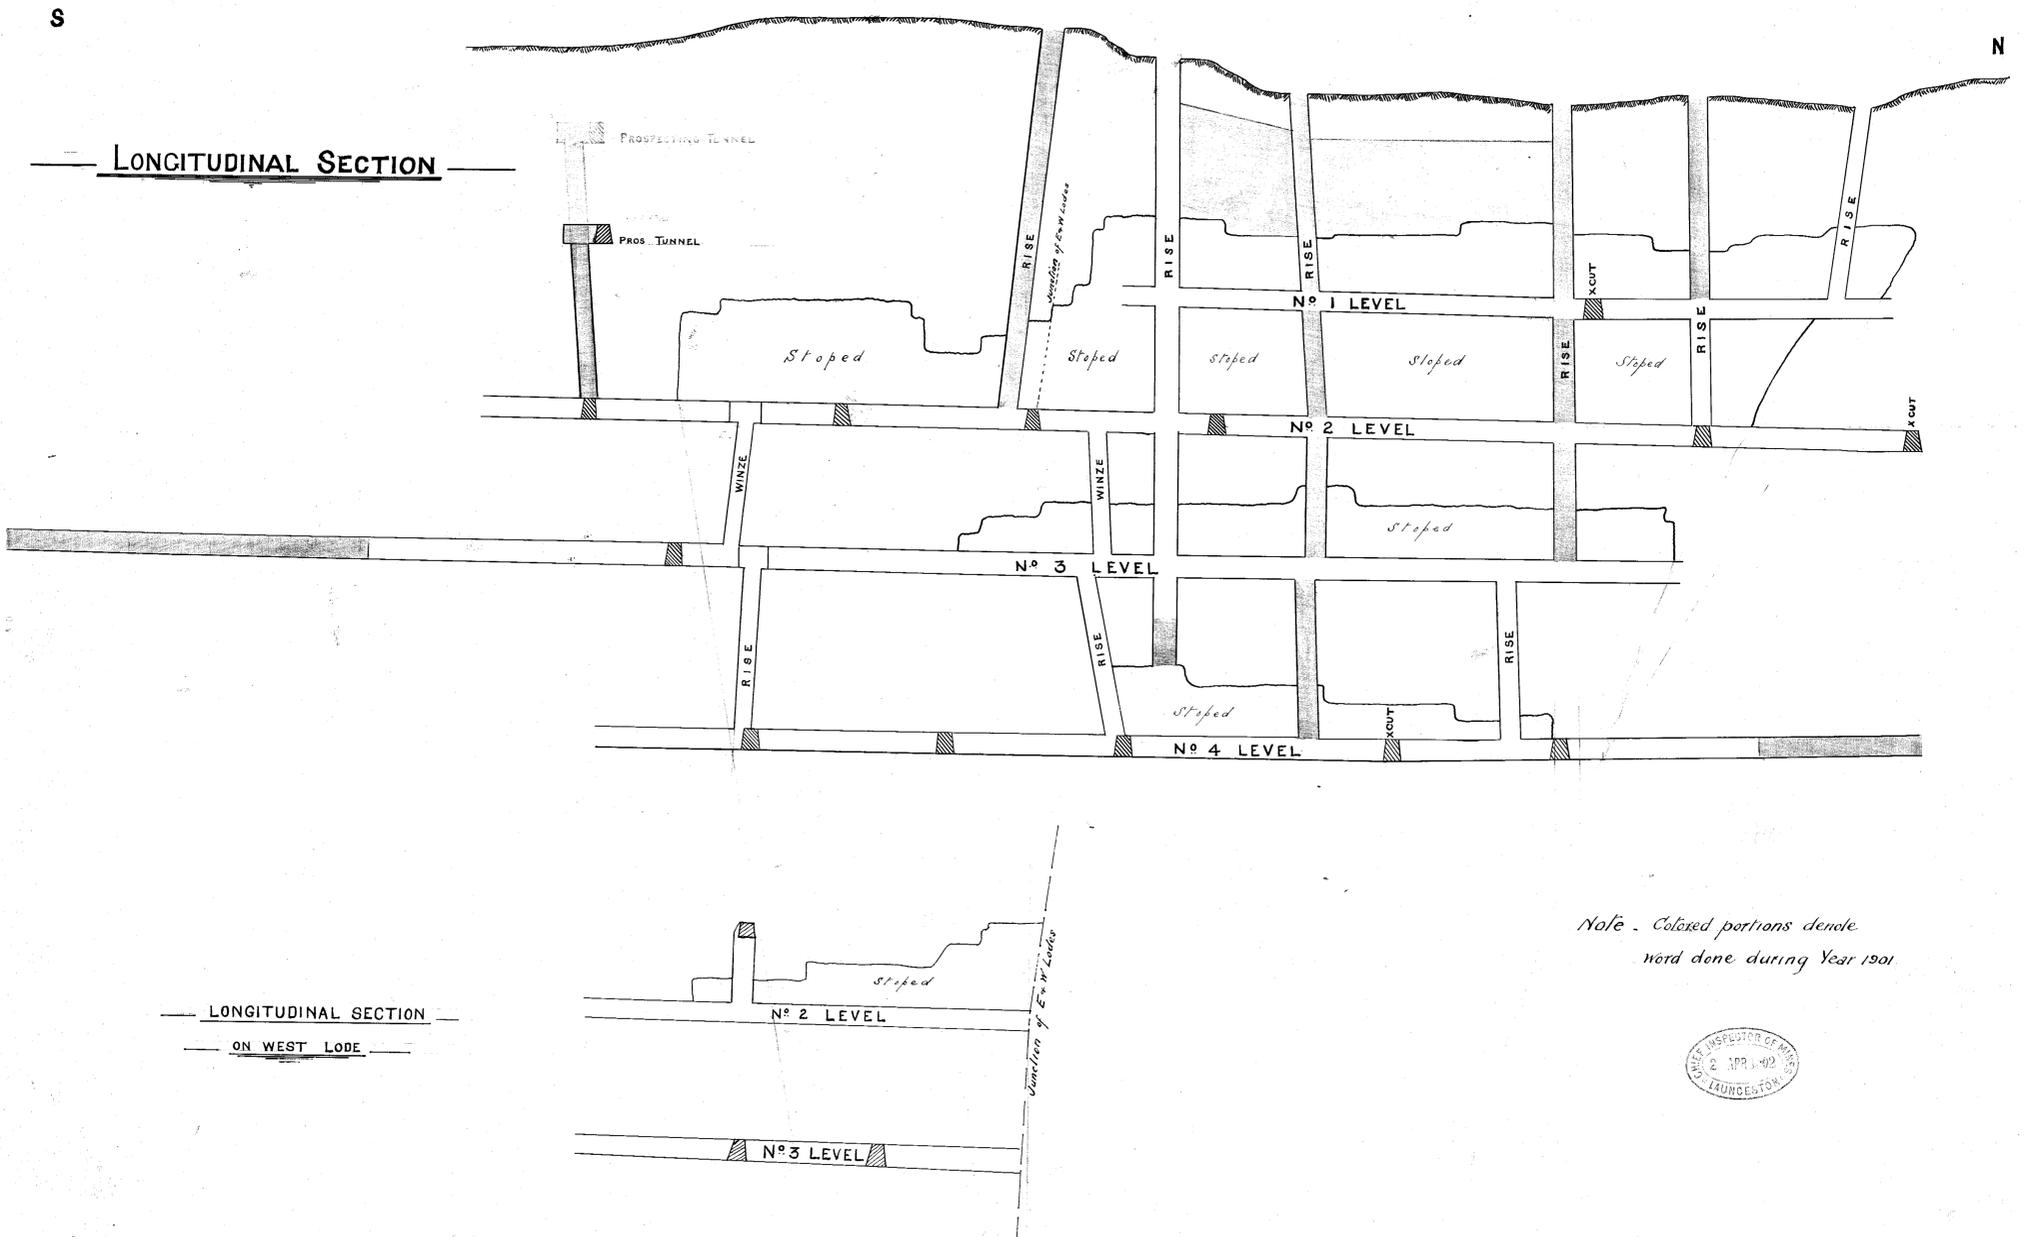

Note - Colored portions denote work done during Year 1901.



5 cm

221-08

180