

11 1/2

105

W. M. (1895)
M. W. (1895)


Magnet Silver Mining Co.,

PLAN OF UNDERGROUND WORKINGS

Scale 25 Feet = 1 Inch



Note. Colored portions denote
work done for year 1901.
I hereby certify that this survey was effected
by a theodolite & steel tape in correct adjustment
R. M. Waller
Feb 5 '02

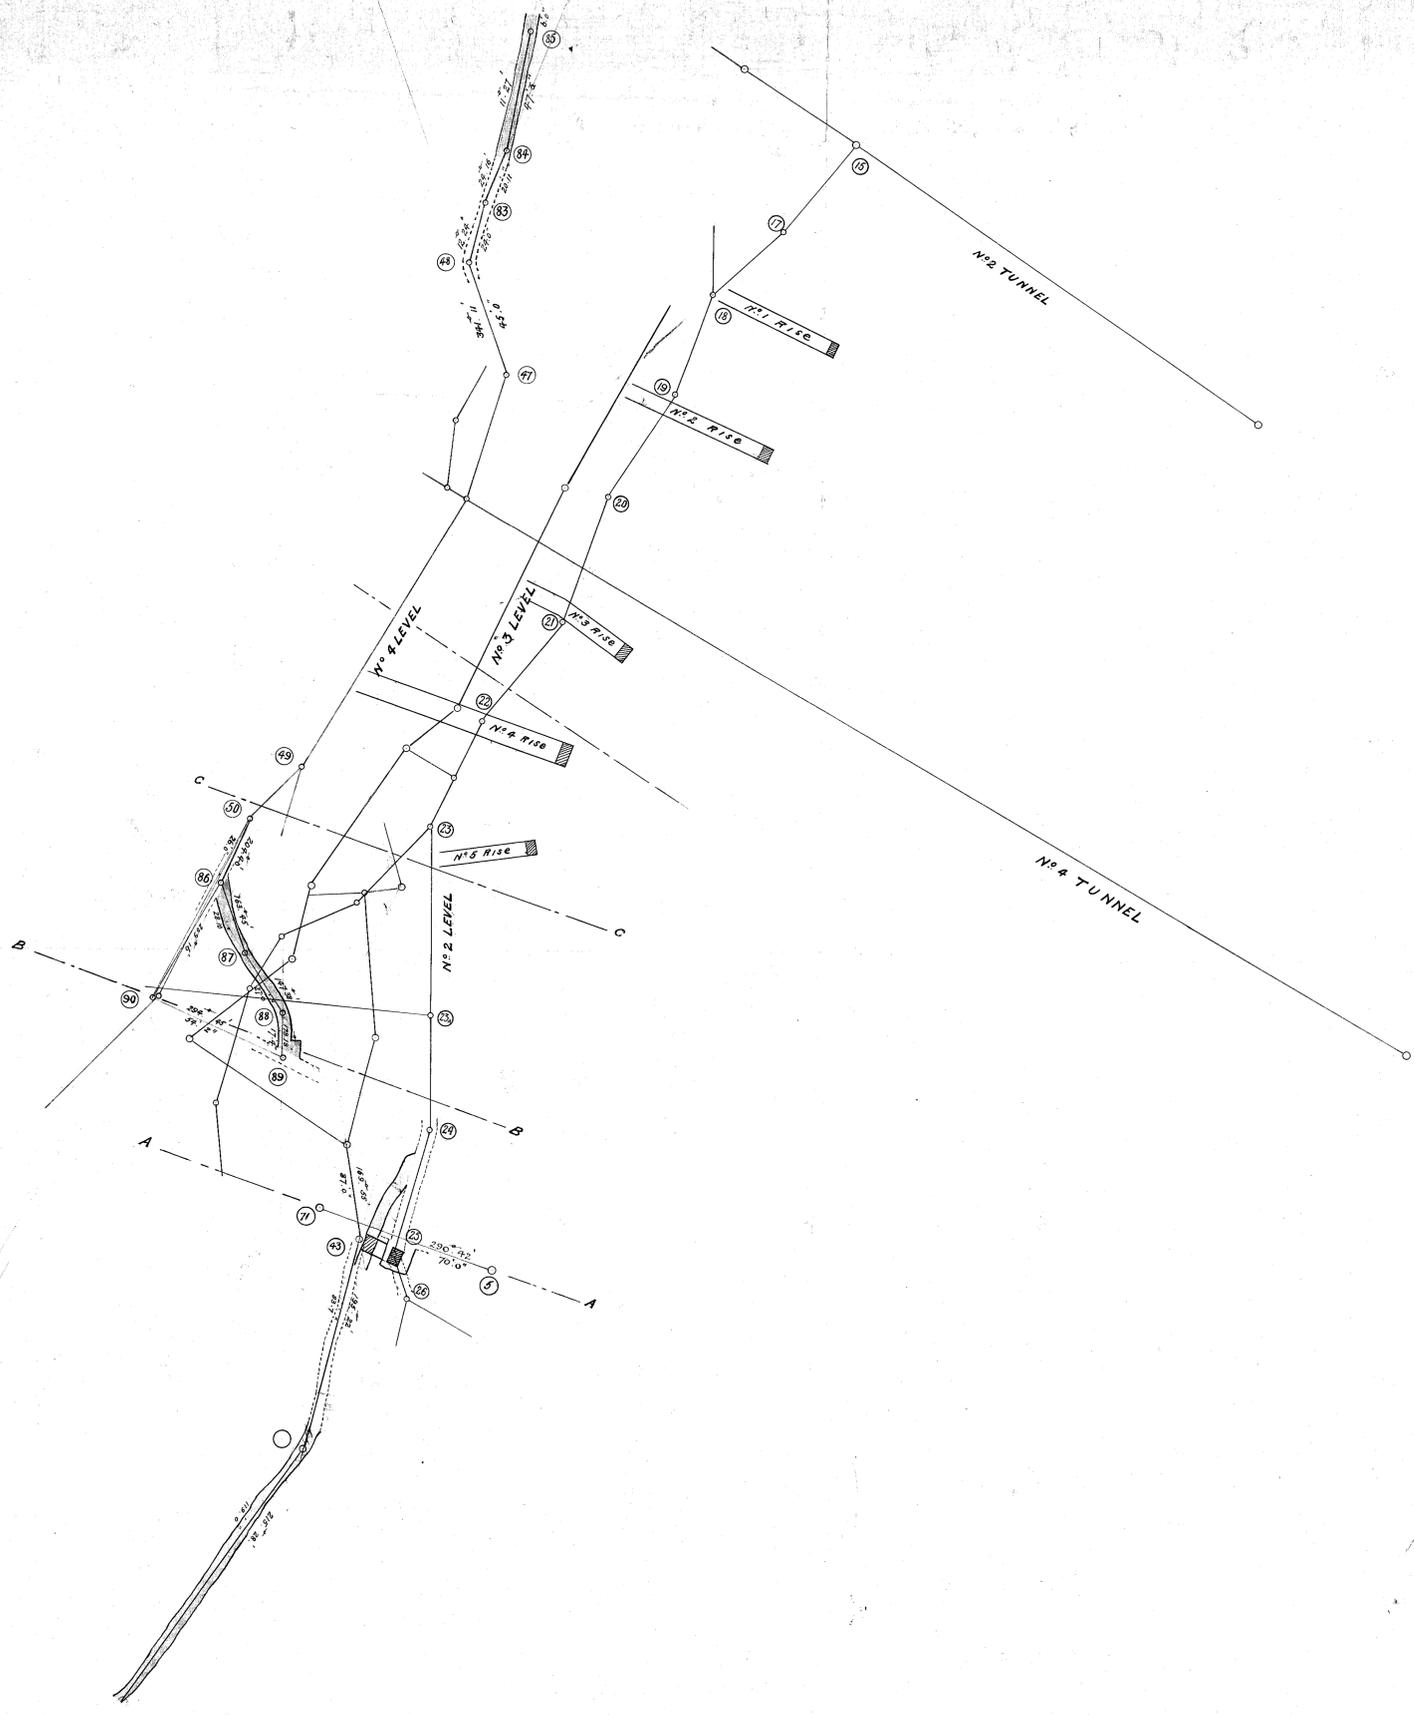

East Boundary of Section

221-09

221-09