



(VIC)
Magnet Silver Mining Co.,
 NO LIABILITY.

(LATE GODKIN S. M. CO.)

Scale 50 feet to one Inch.

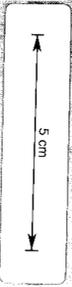

221-10

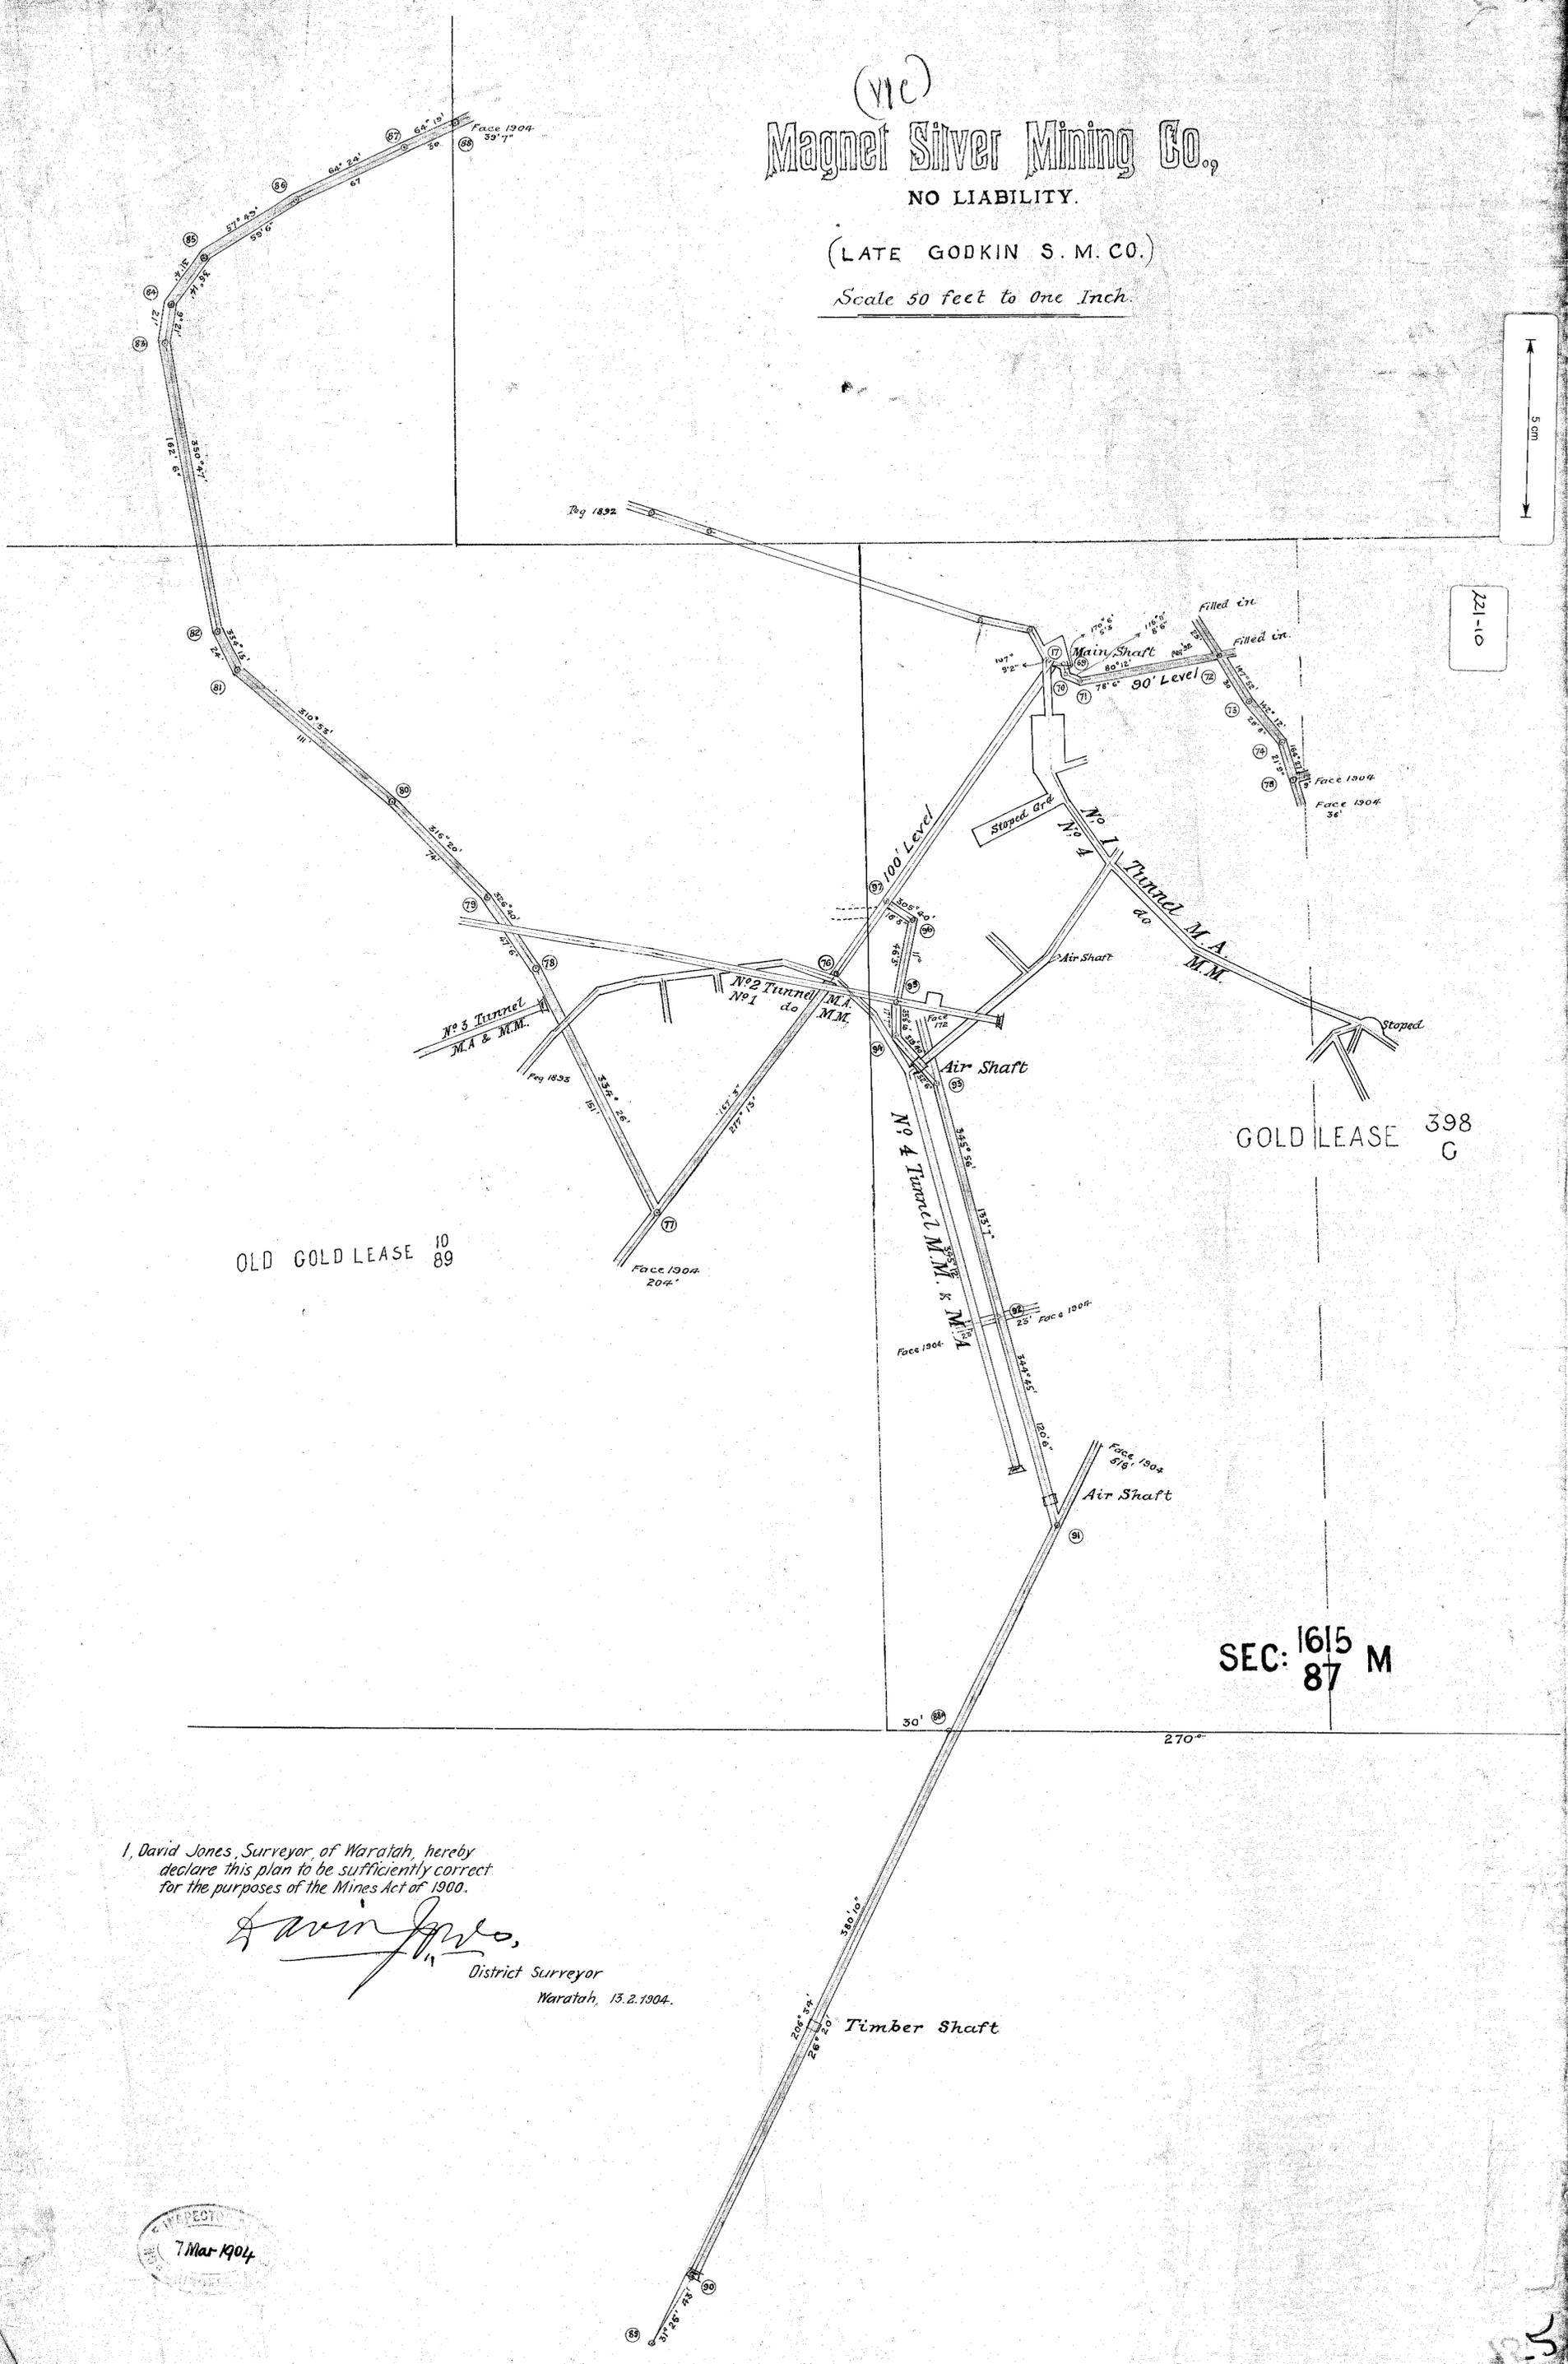

I, David Jones, Surveyor of Waratah, hereby declare this plan to be sufficiently correct for the purposes of the Mines Act of 1900.

David Jones
 District Surveyor
 Waratah, 13.2.1904.



221-10

221-10