

—MACNET SILVER MINING CO.—

—LONGITUDINAL SECTION—



—OR—
—UNDERGROUND WORKINGS—

—Scale—25 Feet to An Inch—

—Plane of Projection perpendicular to line of N^o 4 Crosscut—

—Sloped previous to January 1902—

—Stopped since January 1902—

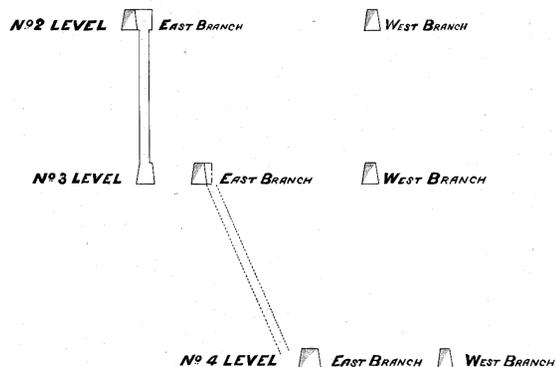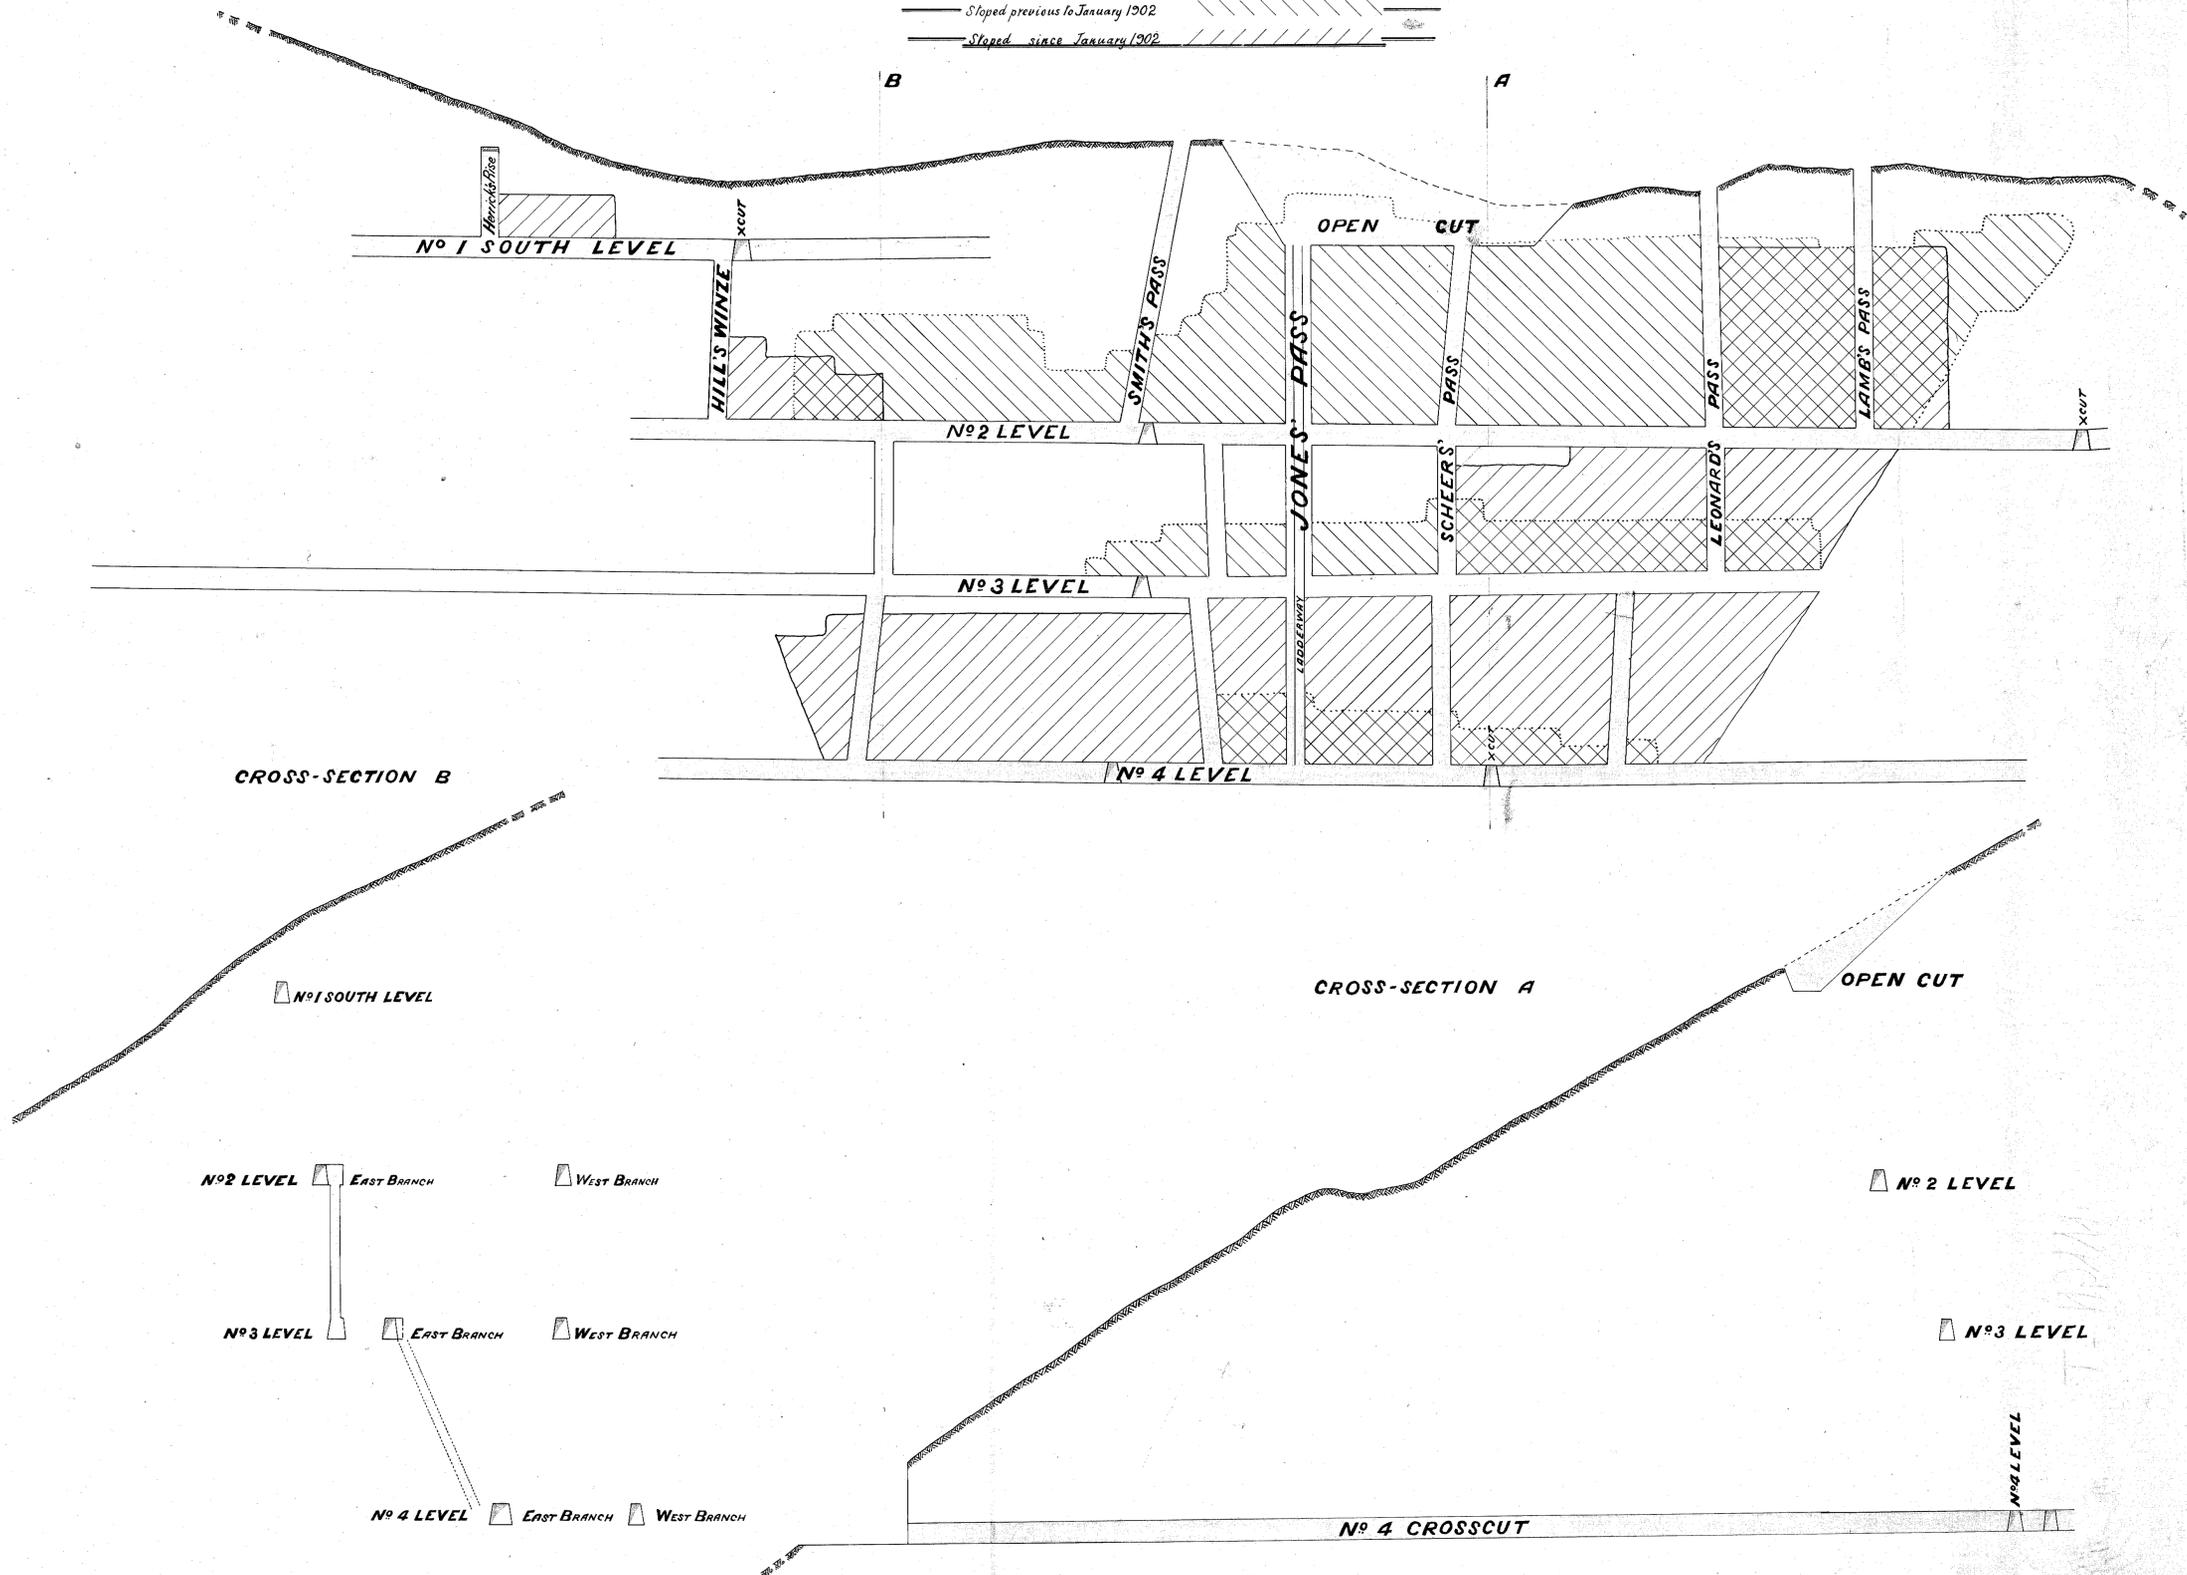

7.6/04

O. Adams Authorized Surveyor
M. Waller General Manager
 January 1903

5 CM

221-11

221-11

132