


500

221-12

MAGNET S. M. CO

UNDERGROUND WORKINGS

SCALE 25 FT. = 1 IN.

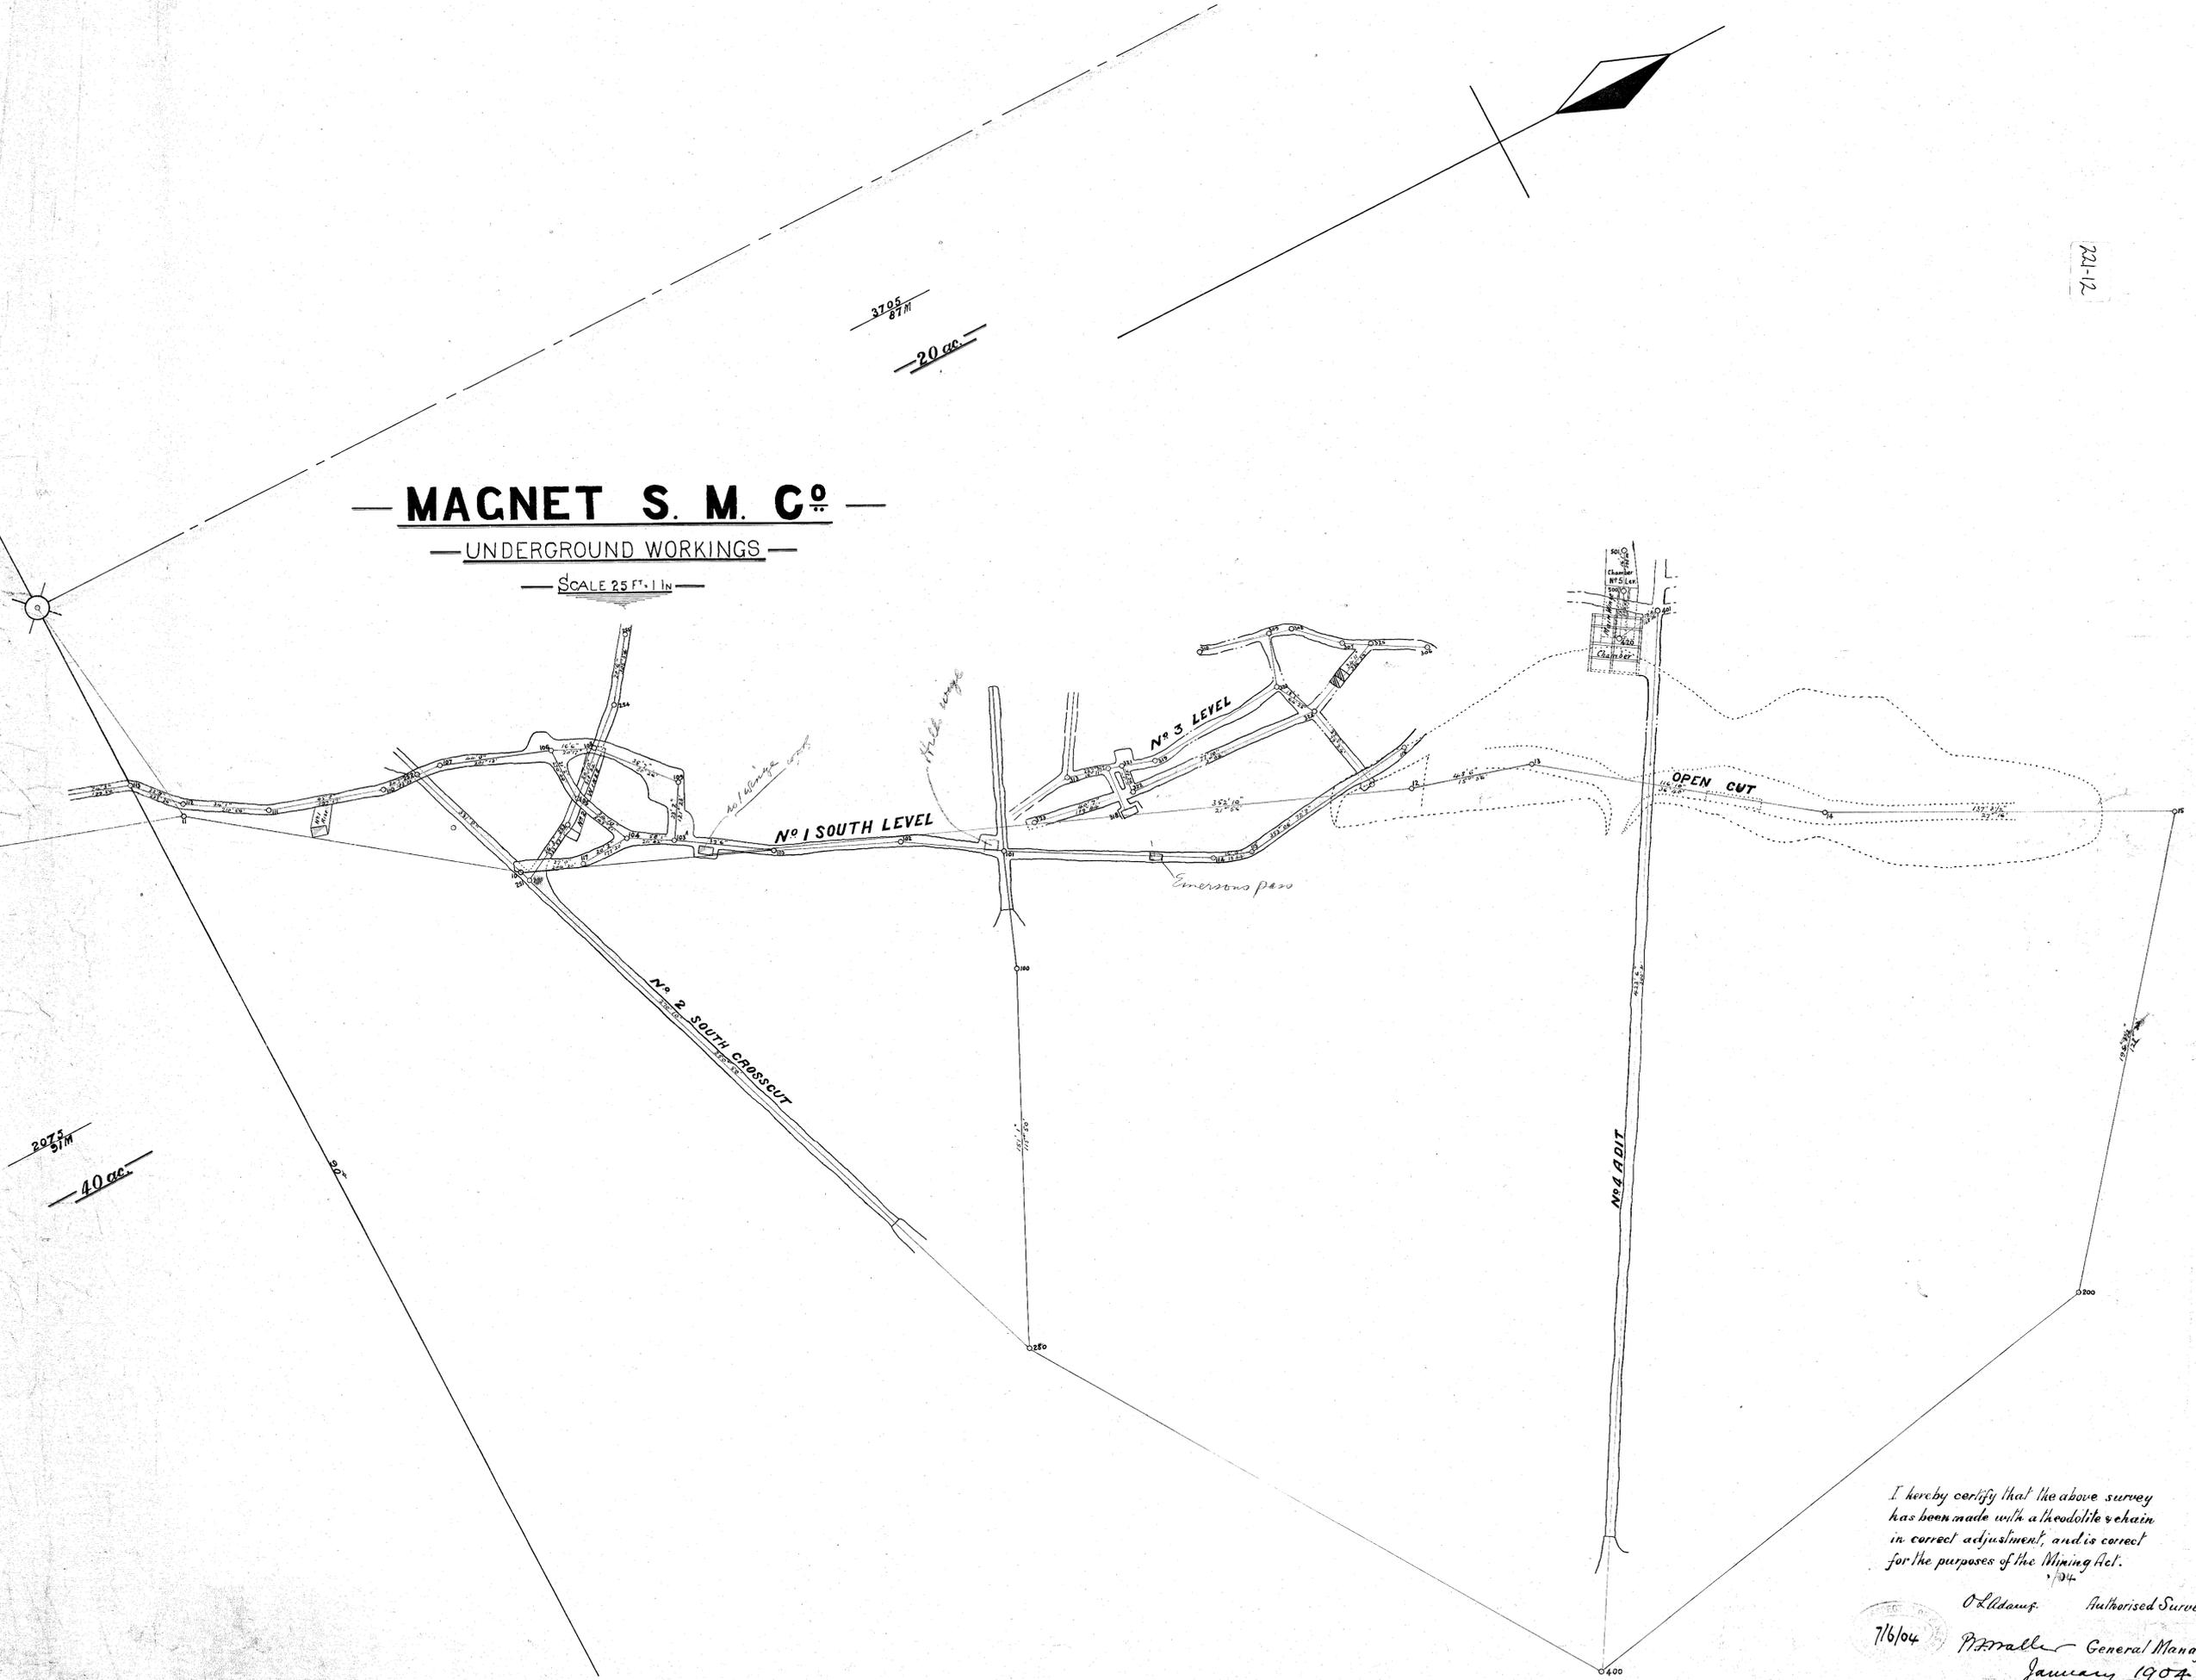

I hereby certify that the above survey
 has been made with a theodolite & chain
 in correct adjustment, and is correct
 for the purposes of the Mining Act.

O. L. Adams, Authorised Surveyor

7/6/04

P. M. Mable, General Manager
 January 1904

221-12