

—MAGNET SILVER MINING CO.—

—LONGITUDINAL SECTION—


—OF—
—UNDERGROUND WORKINGS—

—Scale—25 Feet to An Inch—

—Plane of Projection perpendicular to line of N° 4 Crosscut—

—Sloped previous to January 1902—

—Sloped since January 1902—

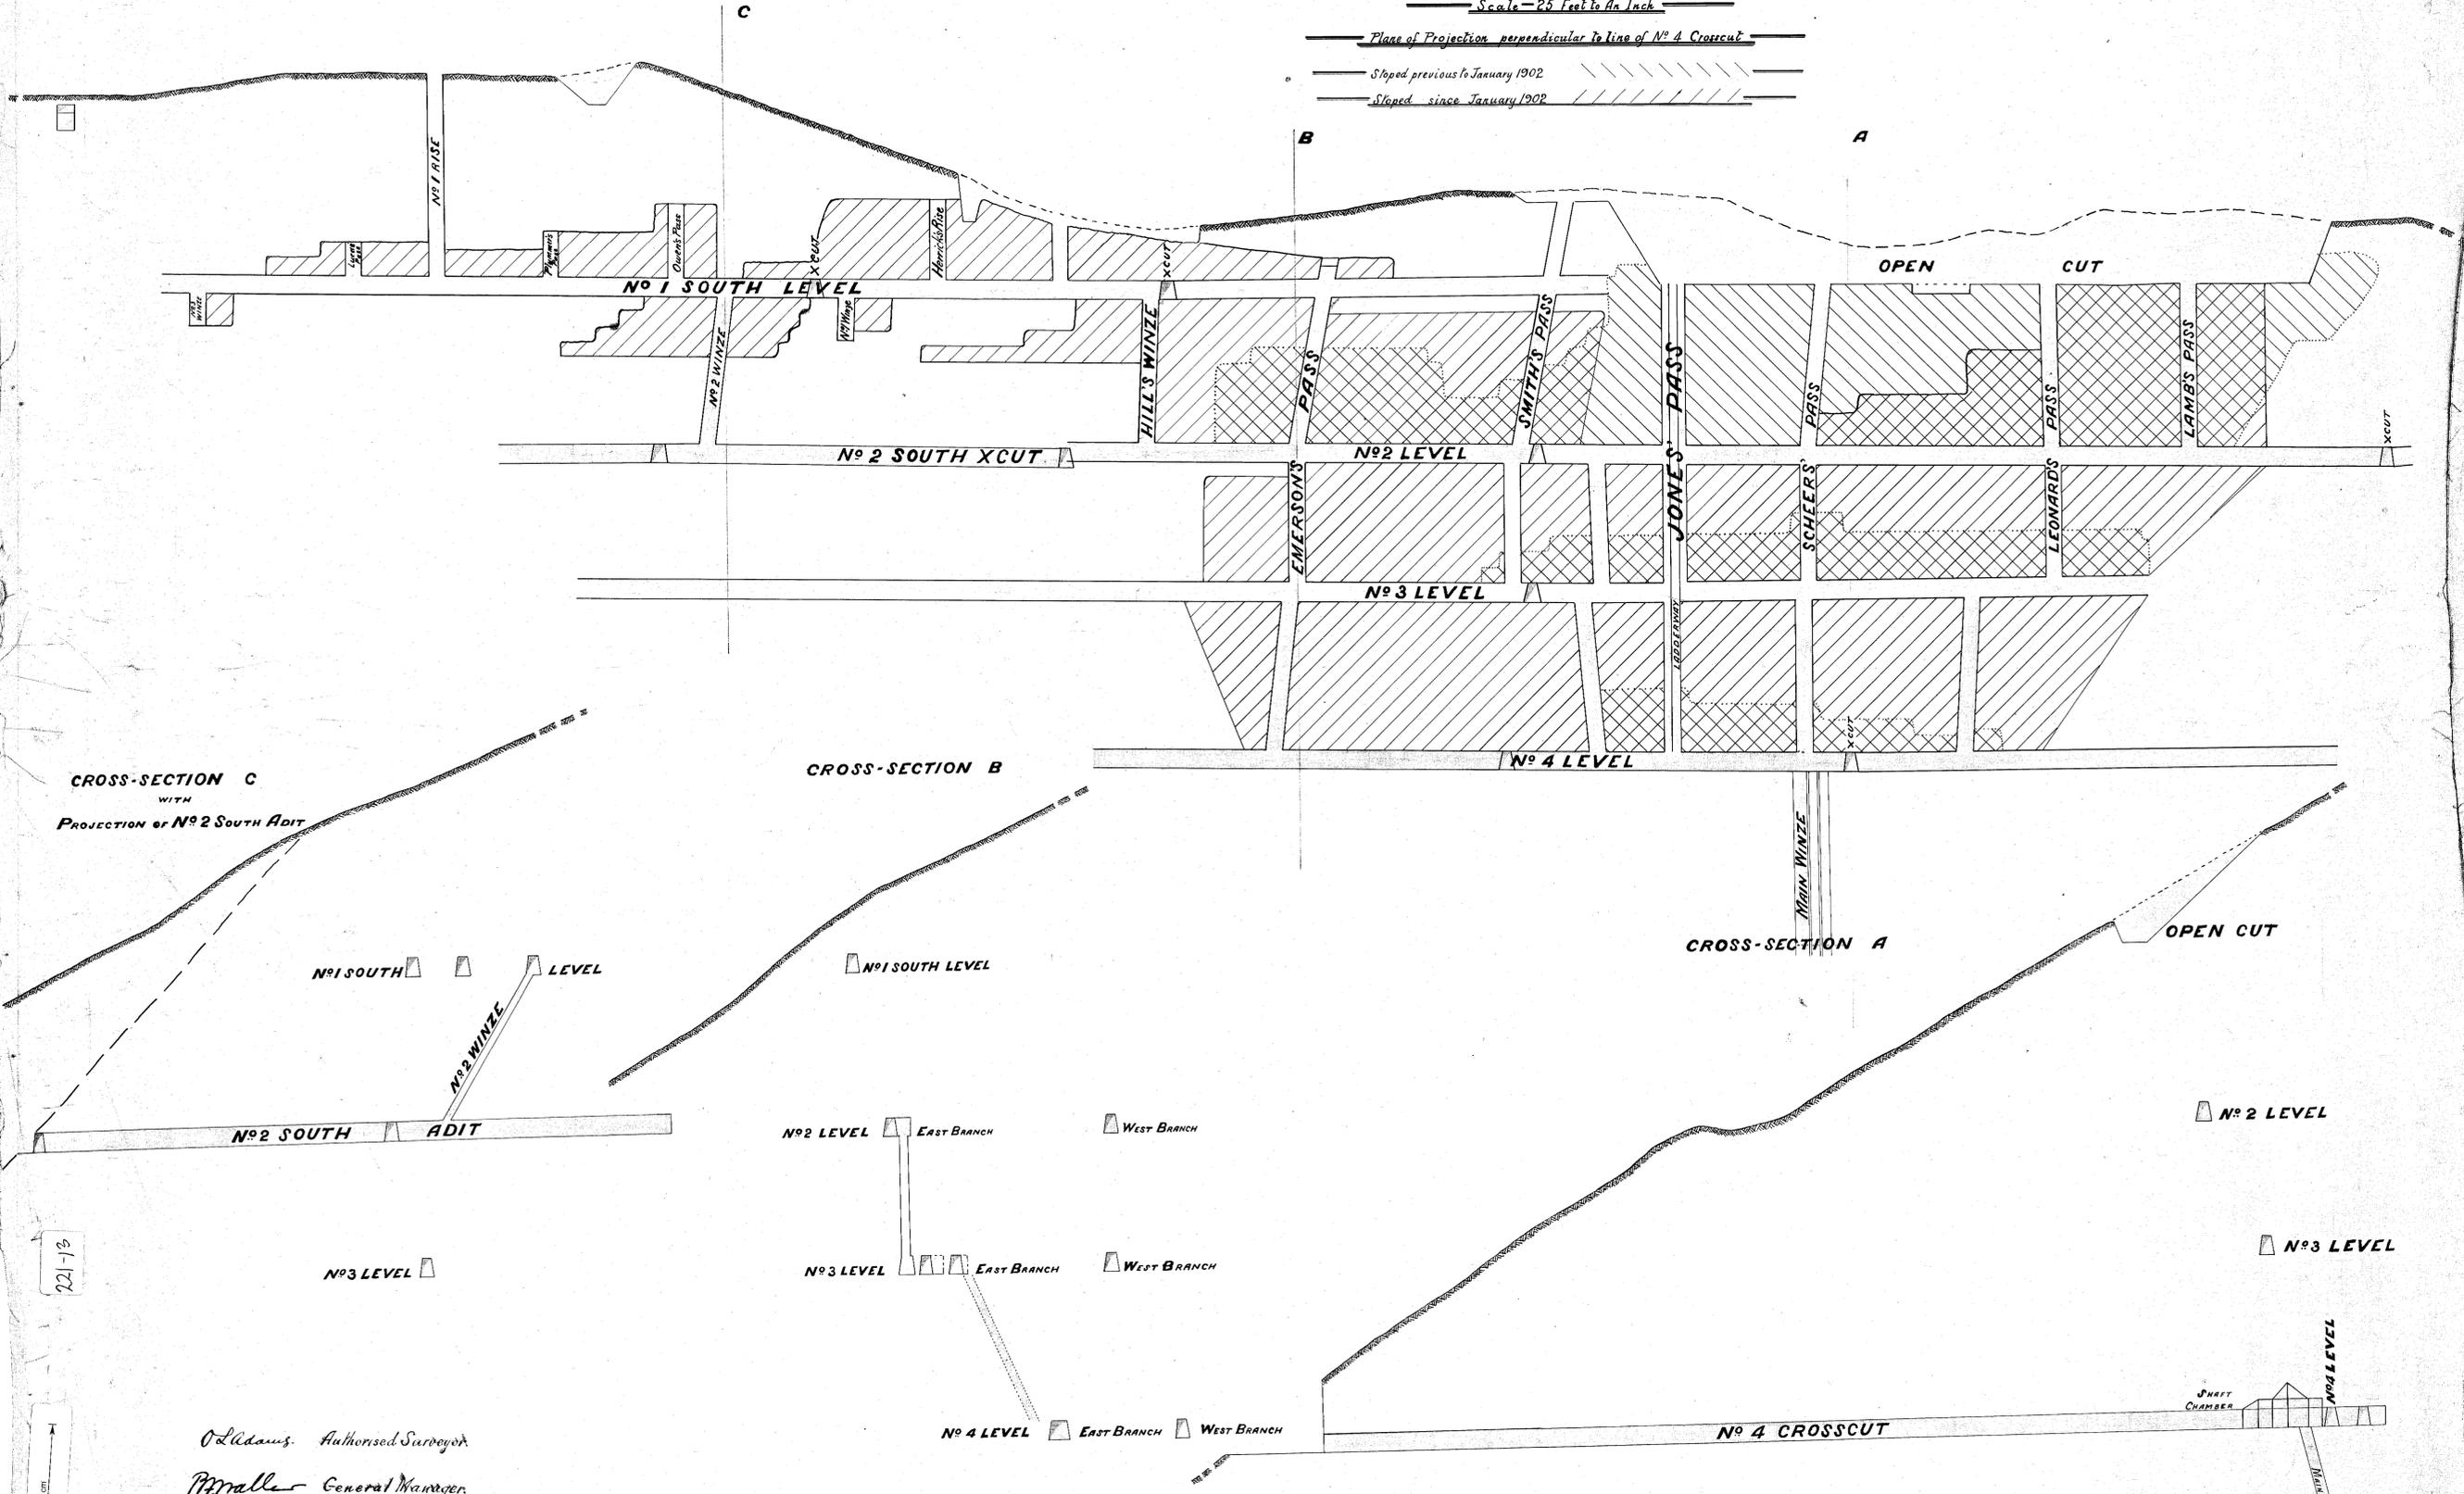

CROSS-SECTION C
WITH
PROJECTION of N° 2 South Adit

CROSS-SECTION B

CROSS-SECTION A

N° 1 SOUTH LEVEL

N° 1 SOUTH LEVEL

N° 2 LEVEL

N° 2 SOUTH ADIT

N° 2 LEVEL EAST BRANCH WEST BRANCH

N° 3 LEVEL

N° 3 LEVEL

N° 3 LEVEL EAST BRANCH WEST BRANCH

N° 4 LEVEL EAST BRANCH WEST BRANCH

N° 4 CROSSCUT

SHAFT CHAMBER

O. Adams, Authorized Surveyor.
R. M. Malle, General Manager.
January 1904

7/6/04

1400

CHAMBER N° 2 LEVEL

221-13

