


22-14

# MAGNET S. M. CO

UNDERGROUND WORKINGS

SCALE 25 FT. = 1 IN.

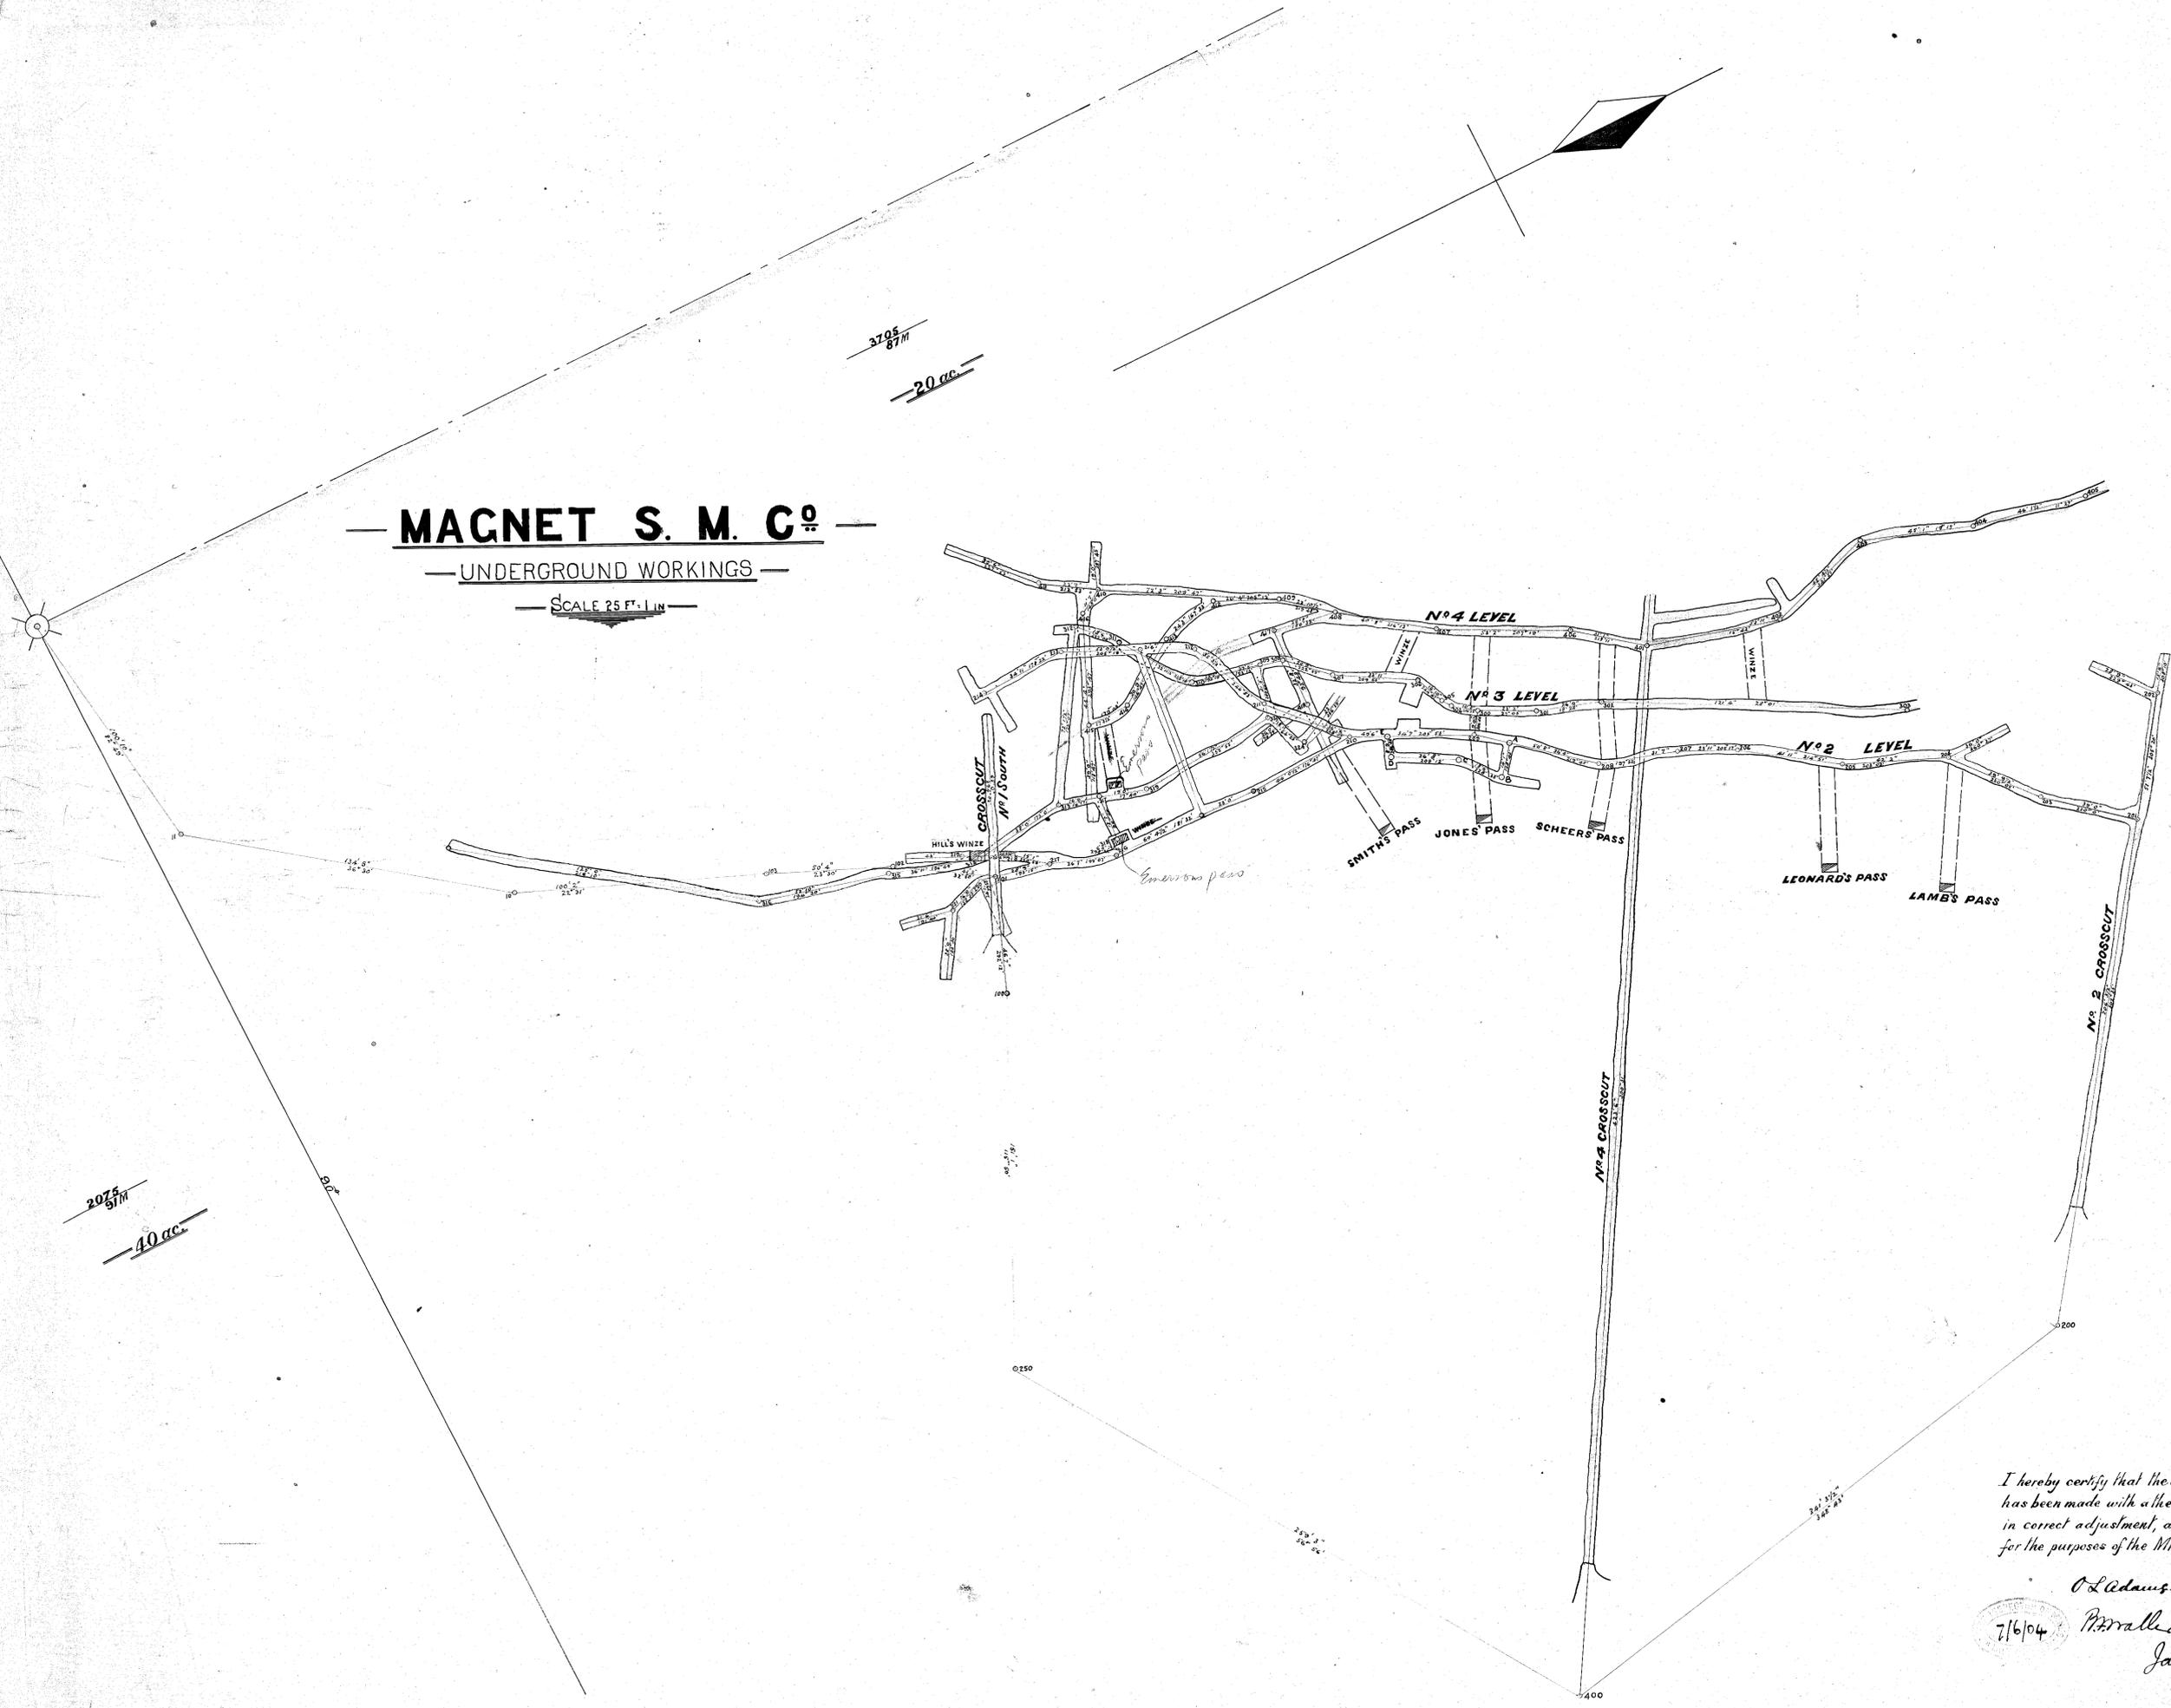

I hereby certify that the above survey has been made with a theodolite & chain in correct adjustment, and is correct for the purposes of the Mining Act.

O. L. Adams. Authorized Surveyor

7/6/04

P. M. Waller General Manager  
January 1902