

221-15

MAGNET S. M. CO

UNDERGROUND WORKINGS

SCALE 25 FT. = 1 IN.


370.5
87M
20 ac.

307.5
51M
40 ac.

221-15

50M

189

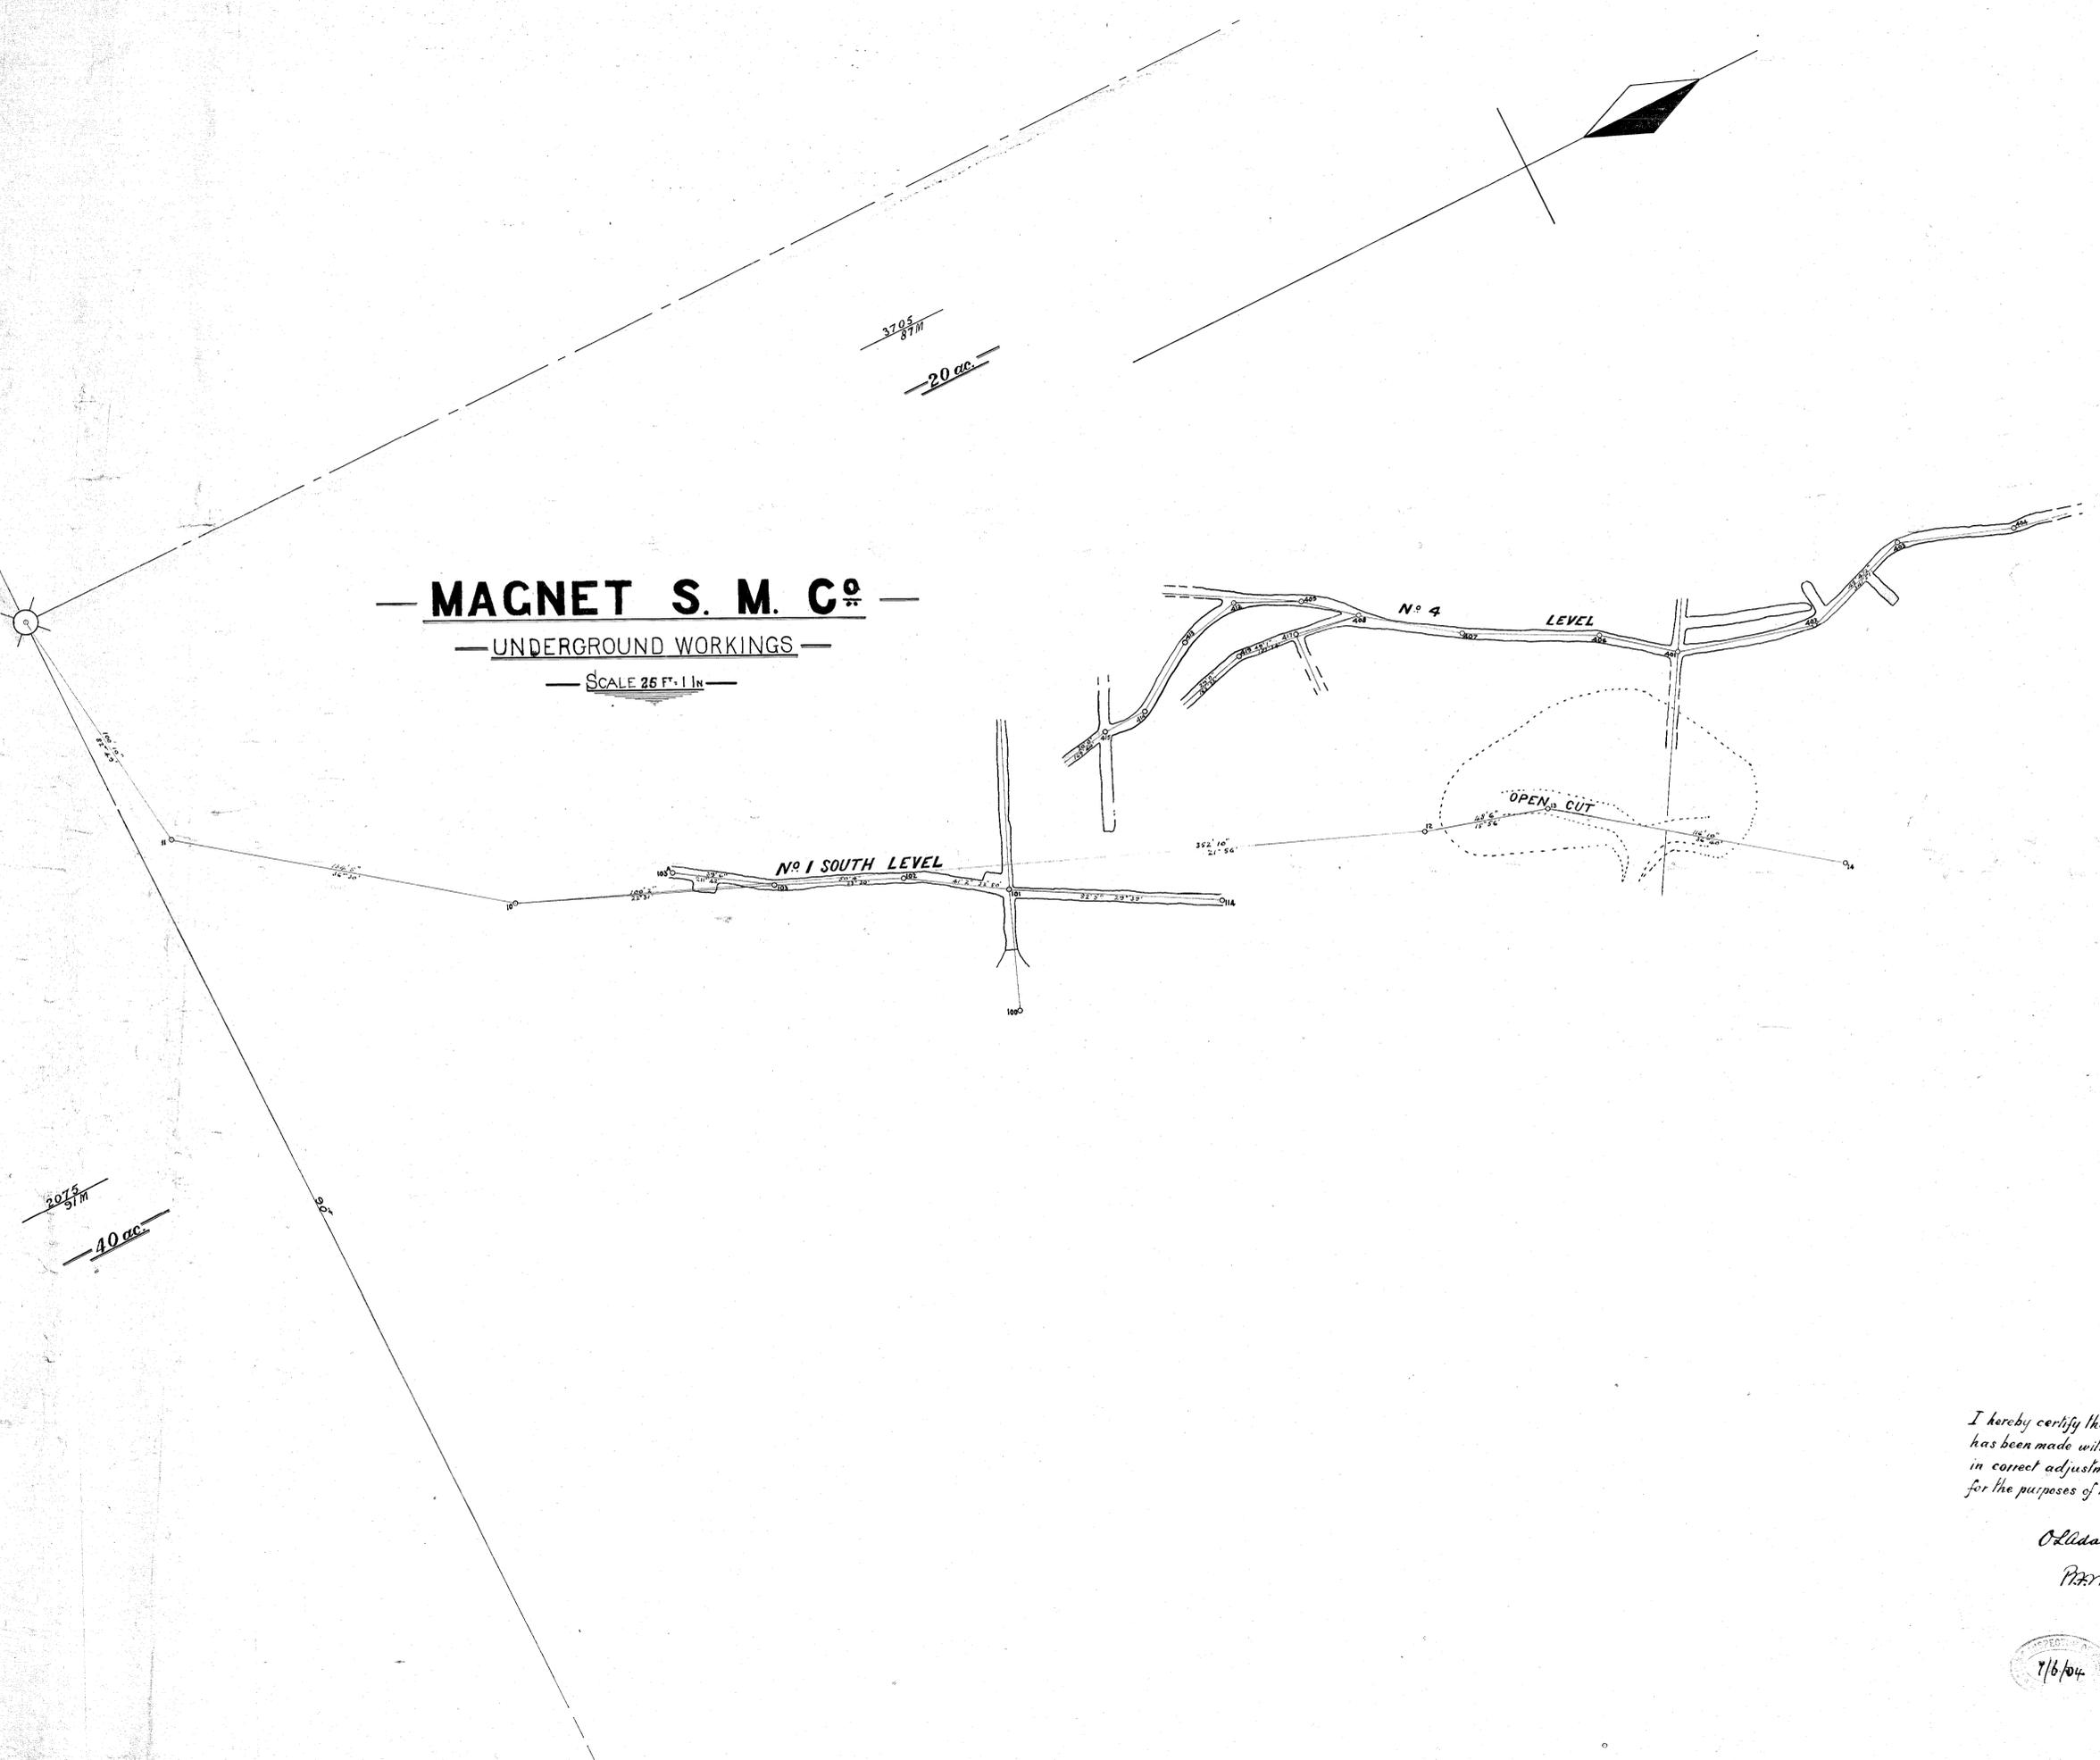

I hereby certify that the above survey
 has been made with a theodolite & chain
 in correct adjustment, and is correct
 for the purposes of the Mining Act.

O. Adams, Authorised Surveyor.

P. J. Waller General Manager.
 January 1903.

