

**MAGNET S.M.Co.**  
**LONGITUDINAL SECTION**  
 OF  
**WEST BRANCH**

25 Feet to An Inch


A

C


B

January 1909 *T.A. de la Roche*  
 Jan. 1908  
 Jan. 1907

*O. Adams* Authorised Surveyor  
*F. A. de la Roche*, General Manager  
 January 1906

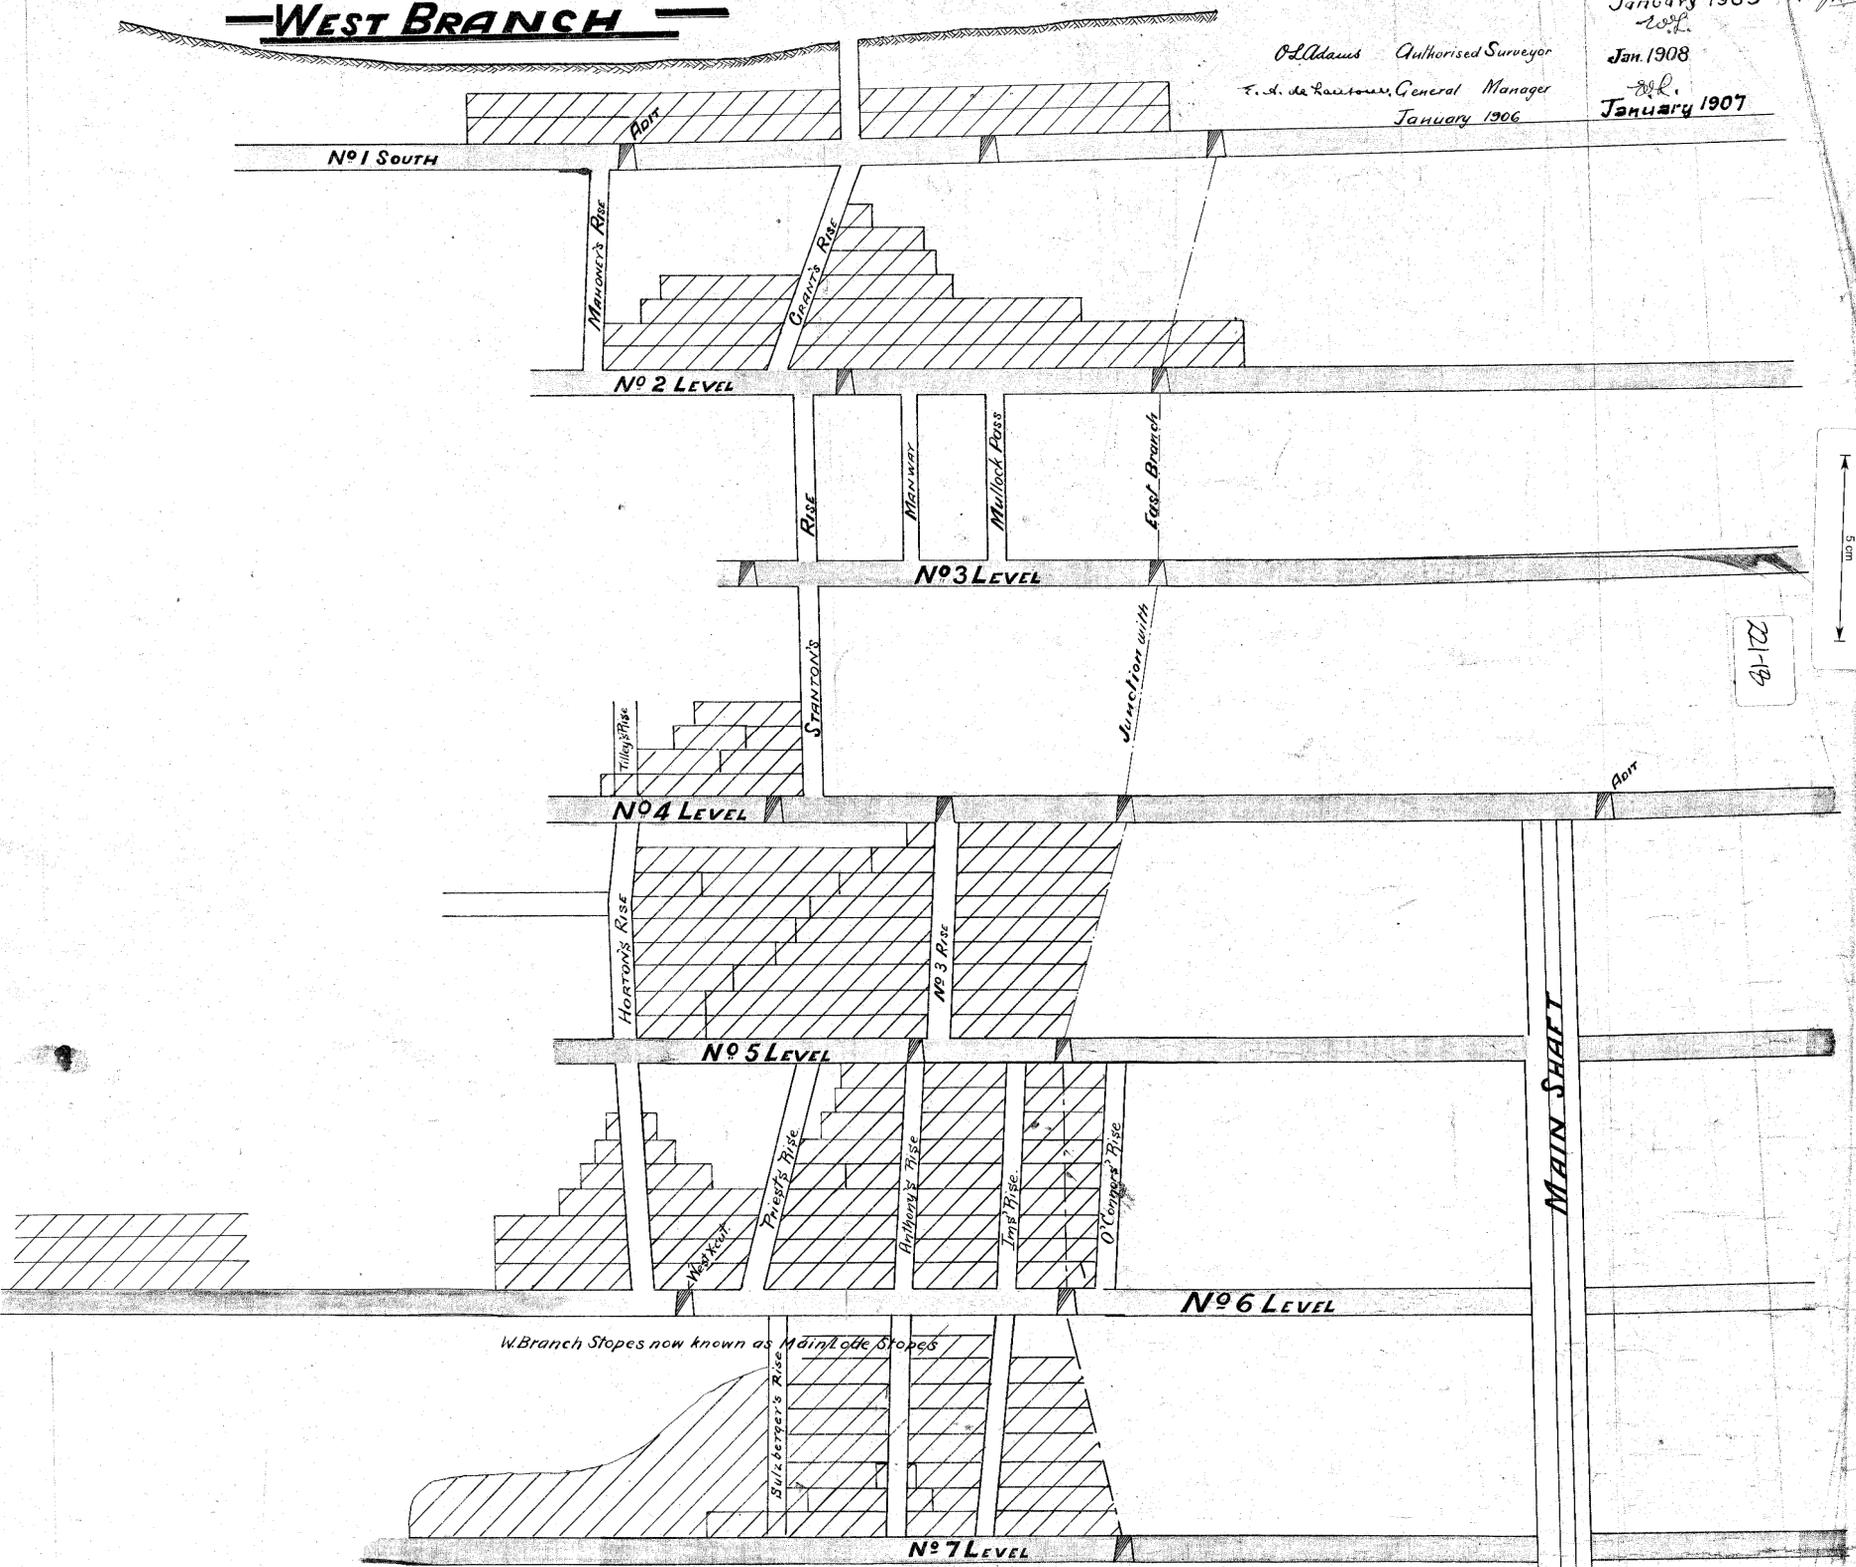

January 1910 *T.A. de la Roche*  
 January 1911 *F. A. de la Roche*

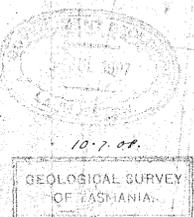

81-177