


221-19

B

A

MAGNET S.M.Co.
LONGITUDINAL SECTION
 OF
EAST LOPE.

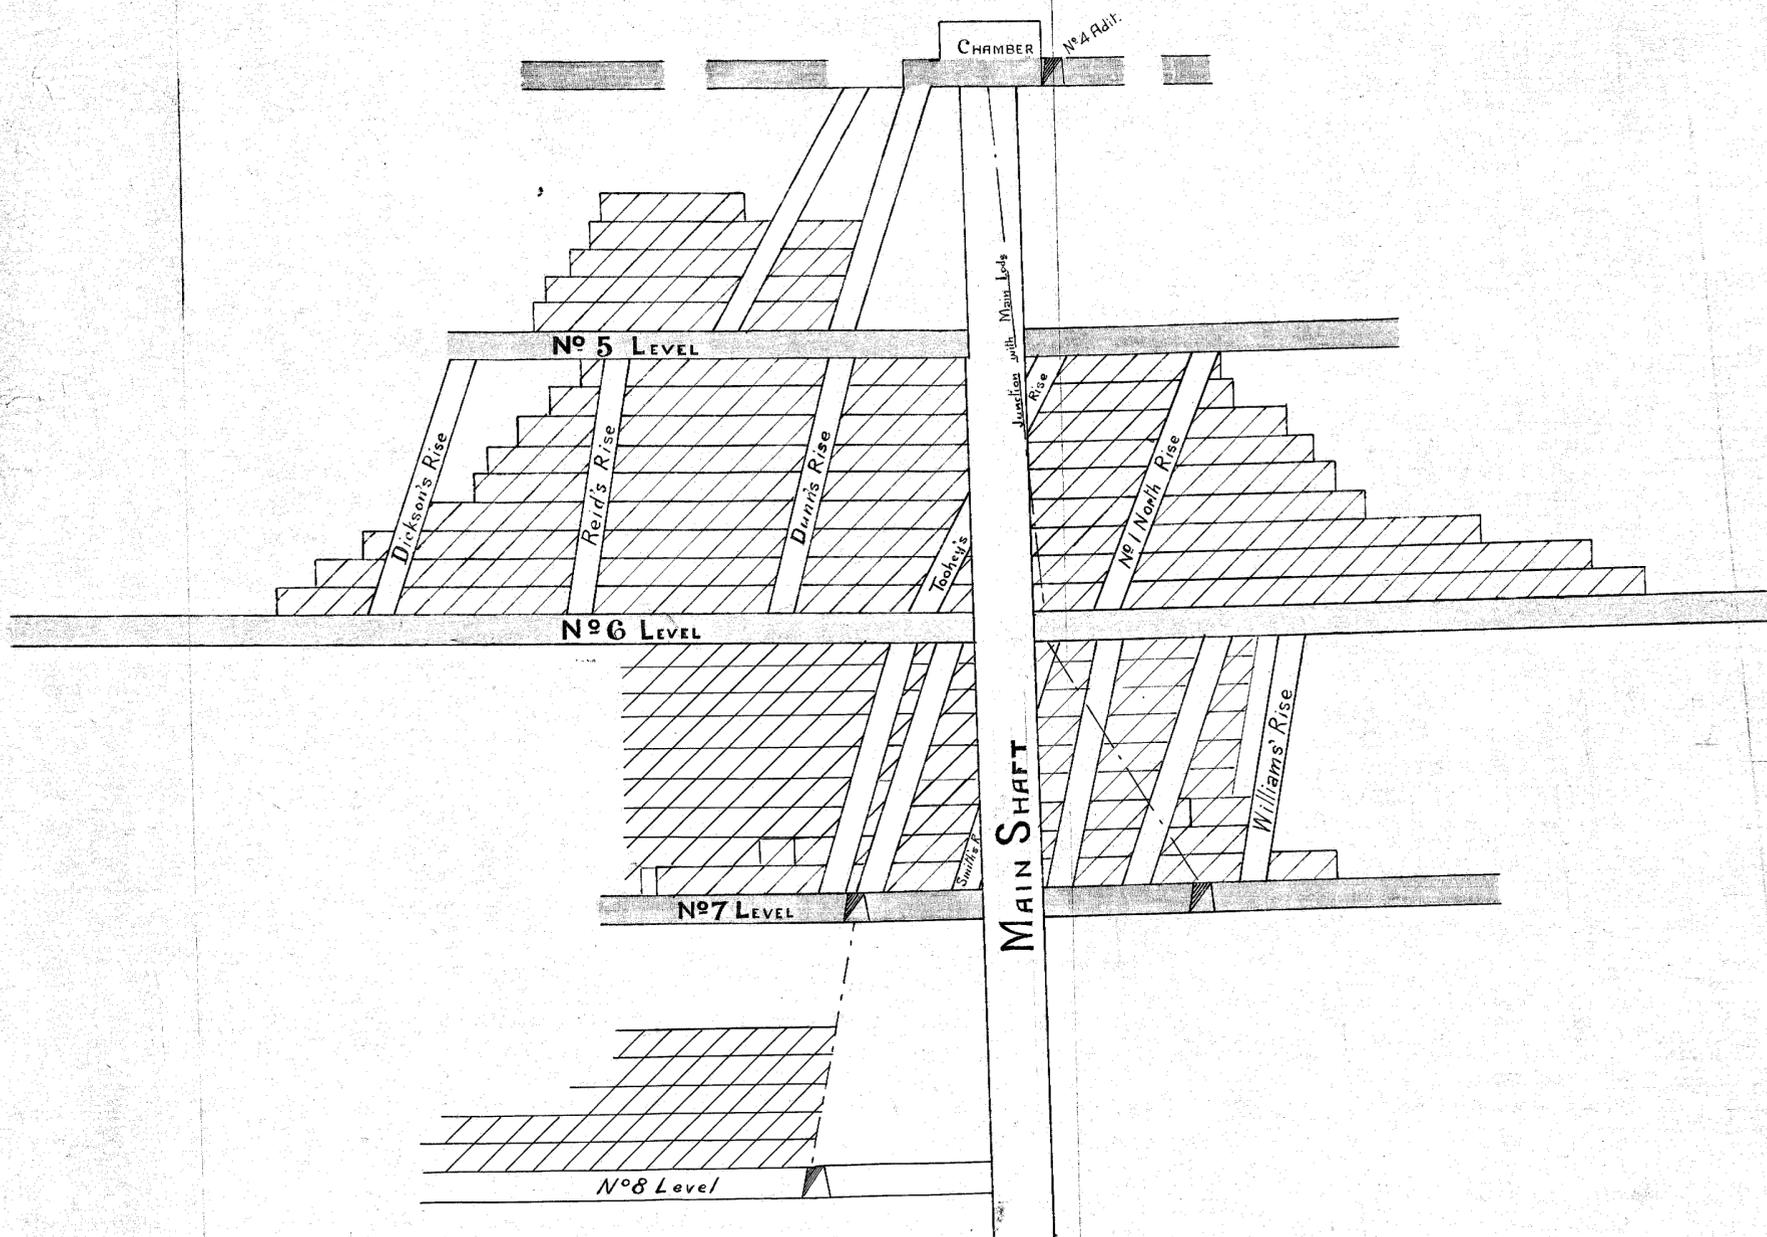

221-19



January 1908 J. Adams
 " " E. J. Adams
 " 1910 E. J. Adams
 " 1911 E. J. Adams

10.7.08.
 GEOLOGICAL SURVEY
 OF TASMANIA

J. Adams Authorised Surveyor
 R. de la Poer General Manager
 January 1908

Datum 1000 Feet above Sea Level