


END 1893

PLAN

MAGNET (Vic.) S. M. COMP'S Underground Works WHYTE RIVER

Scale 50 Feet to 1 Inch.

221-20

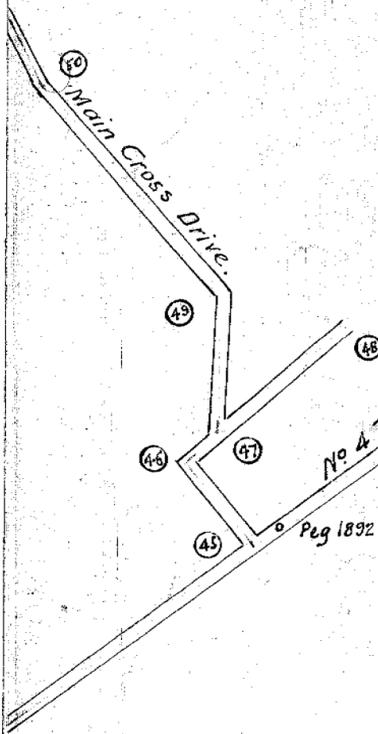

221-20

I, David Jones, Surveyor, of Waratah, hereby declare this plan to be sufficiently correct for the purposes of the Mining Act of 1905.

David Jones
District Surveyor,

Waratah. 29.10.08.



Waratah (Mines)
221-20

Waratah (Mines)
221-20
62d. 8.3.09
W.R.