


5 cm

B

221-21

MAGNET S.M.Co.
LONGITUDINAL SECTION
OF
EAST LOPE
25 Feet to An Inch

A

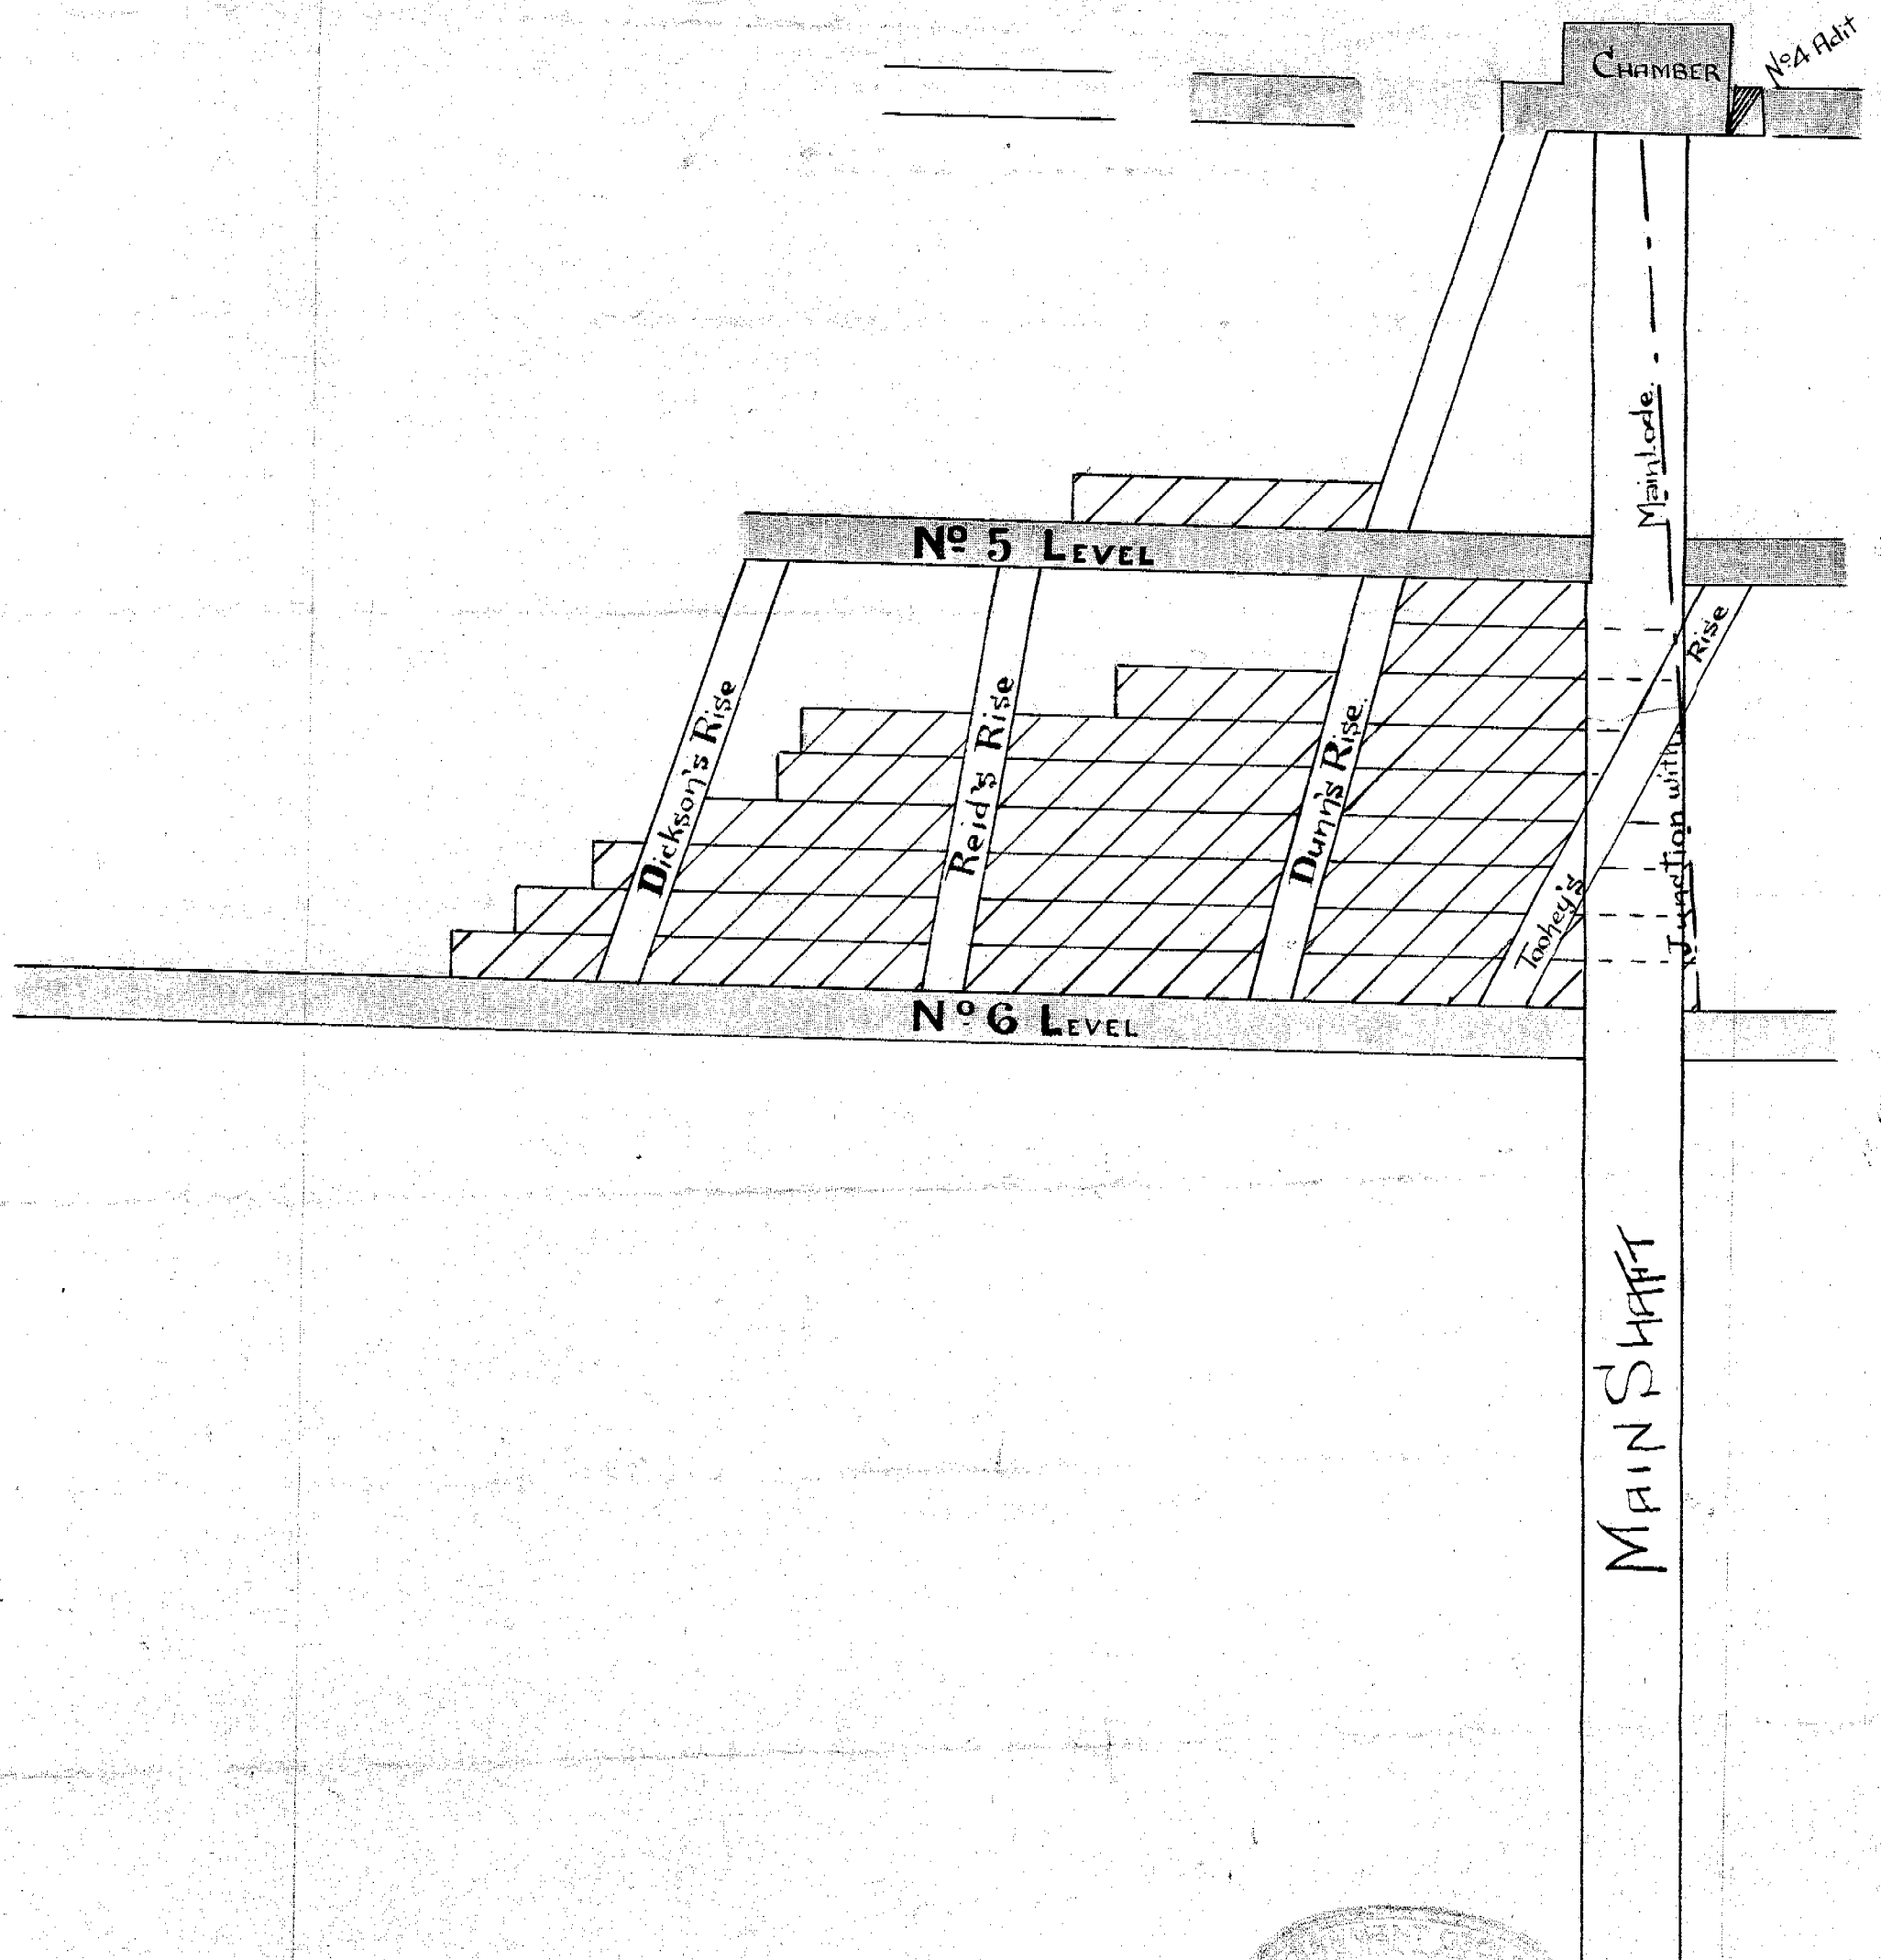

January 1907

O. Adams Authorised Surveyor

E. A. Lantier General Manager

