

1061 2 1

THE "KOH-I-NOOR" TRACING CLOTH

DAVID JONES
DISTRICT SURVEYOR
WARATAH,
TASMANIA.

PLAN

OF THE


GODKIN S.M. COMPANY'S

Now MAOONET S.M. COMPANY'S

Underground Works

WHYTE RIVER

Scale 50 Feet to 1 Inch

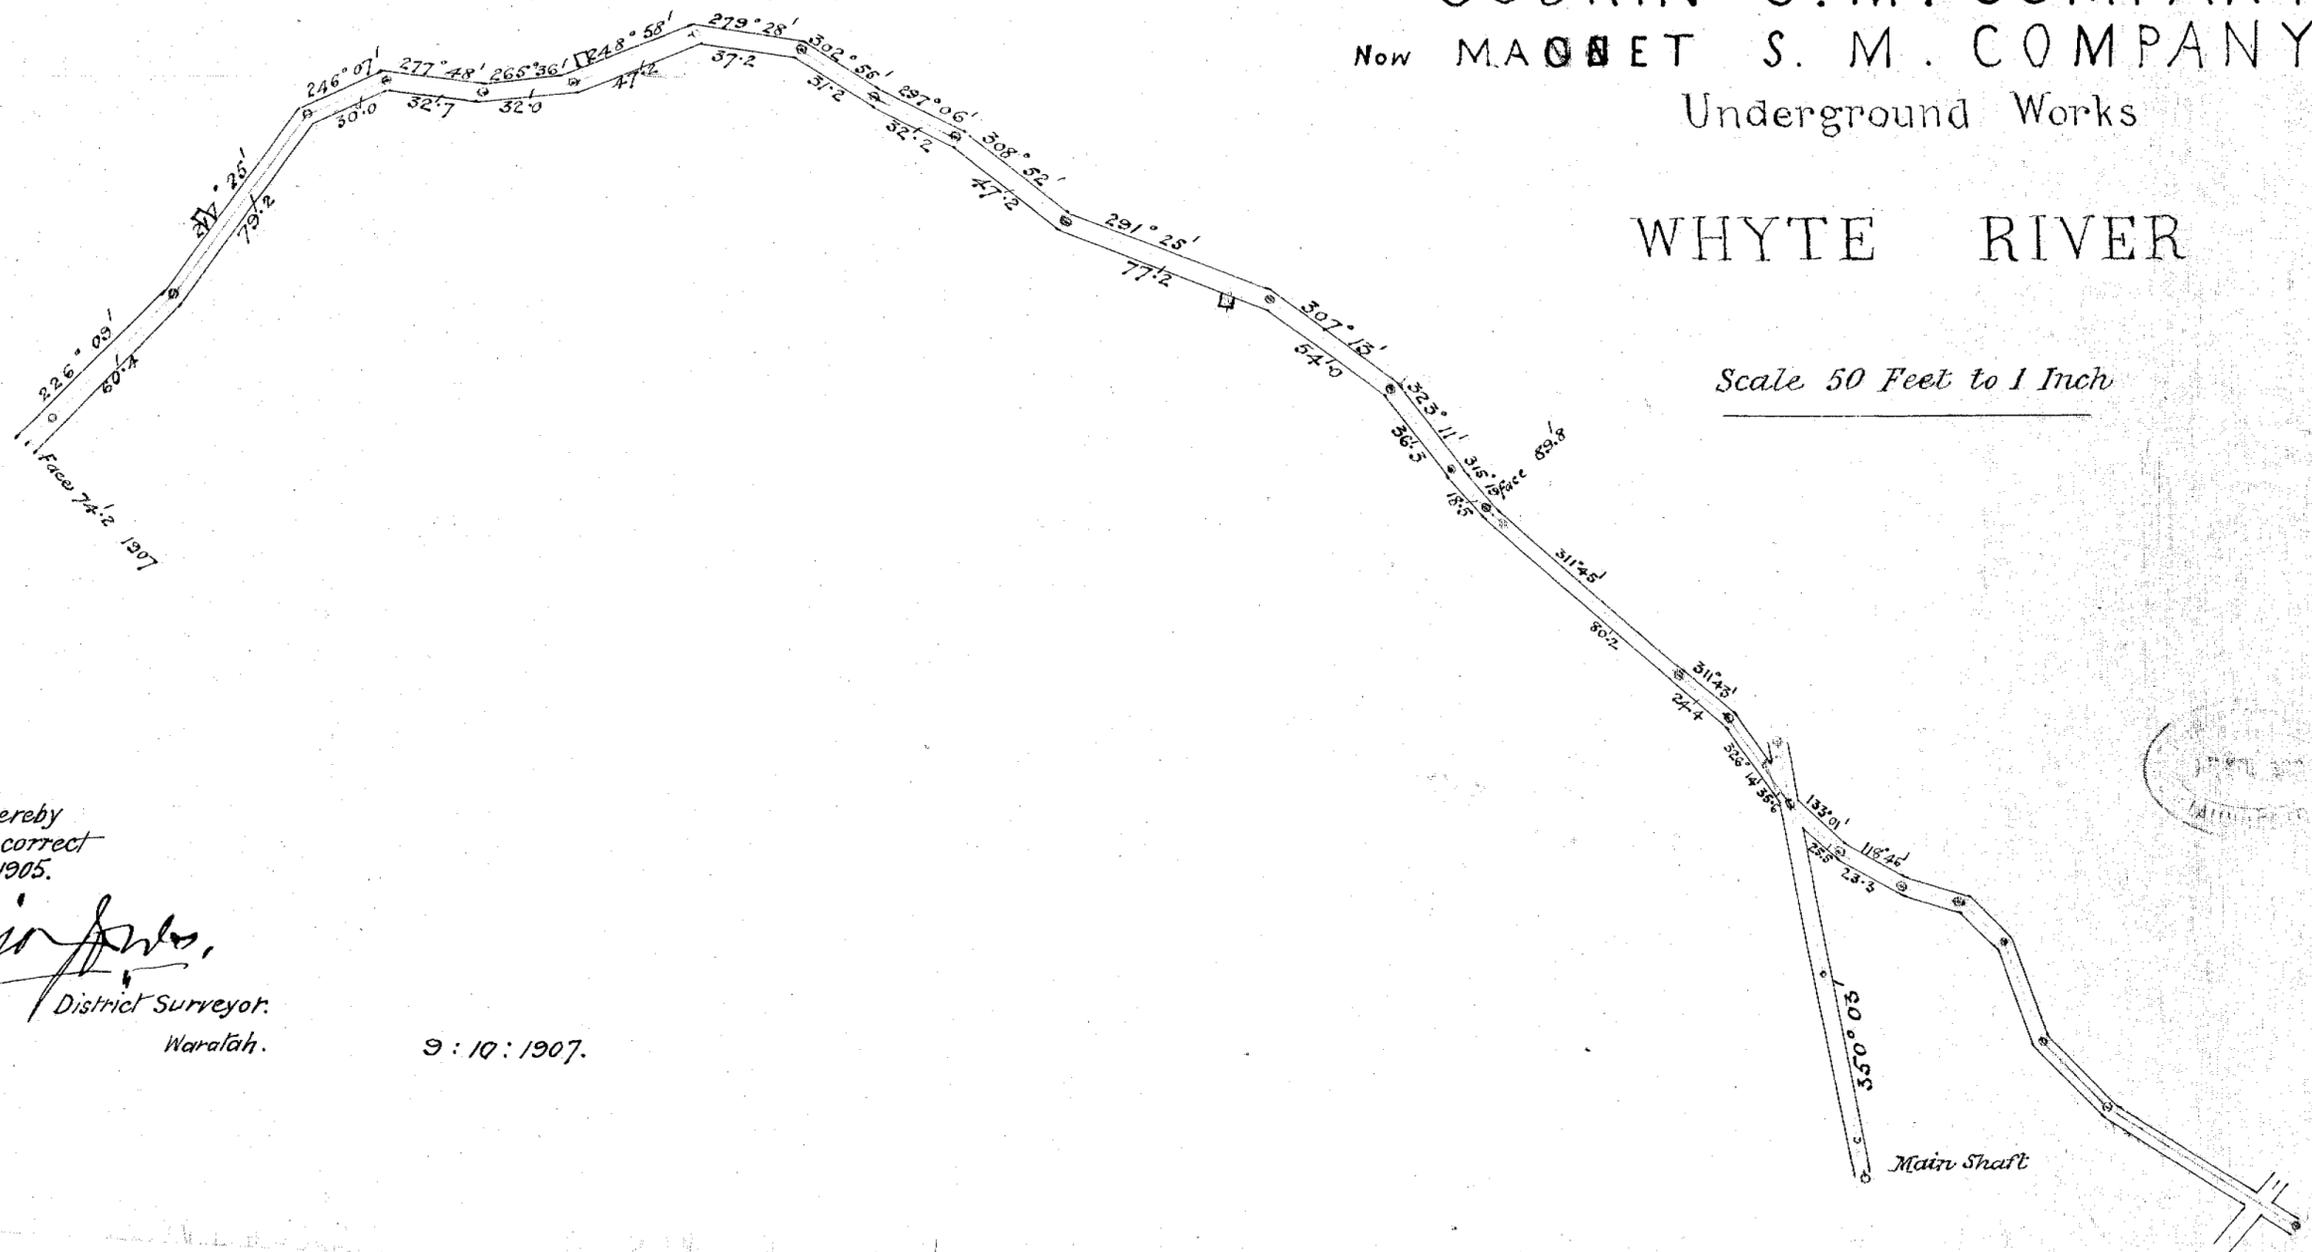

I, David Jones, Surveyor of Waratah hereby declare this plan to be sufficiently correct for the purposes of the Mines Act of 1905.

David Jones
District Surveyor
Waratah.

9:10:1907.

221-22

100 1-2-100

100 1-2-100

50m

221-22