


No. 2 221-23

221-23


5 cm

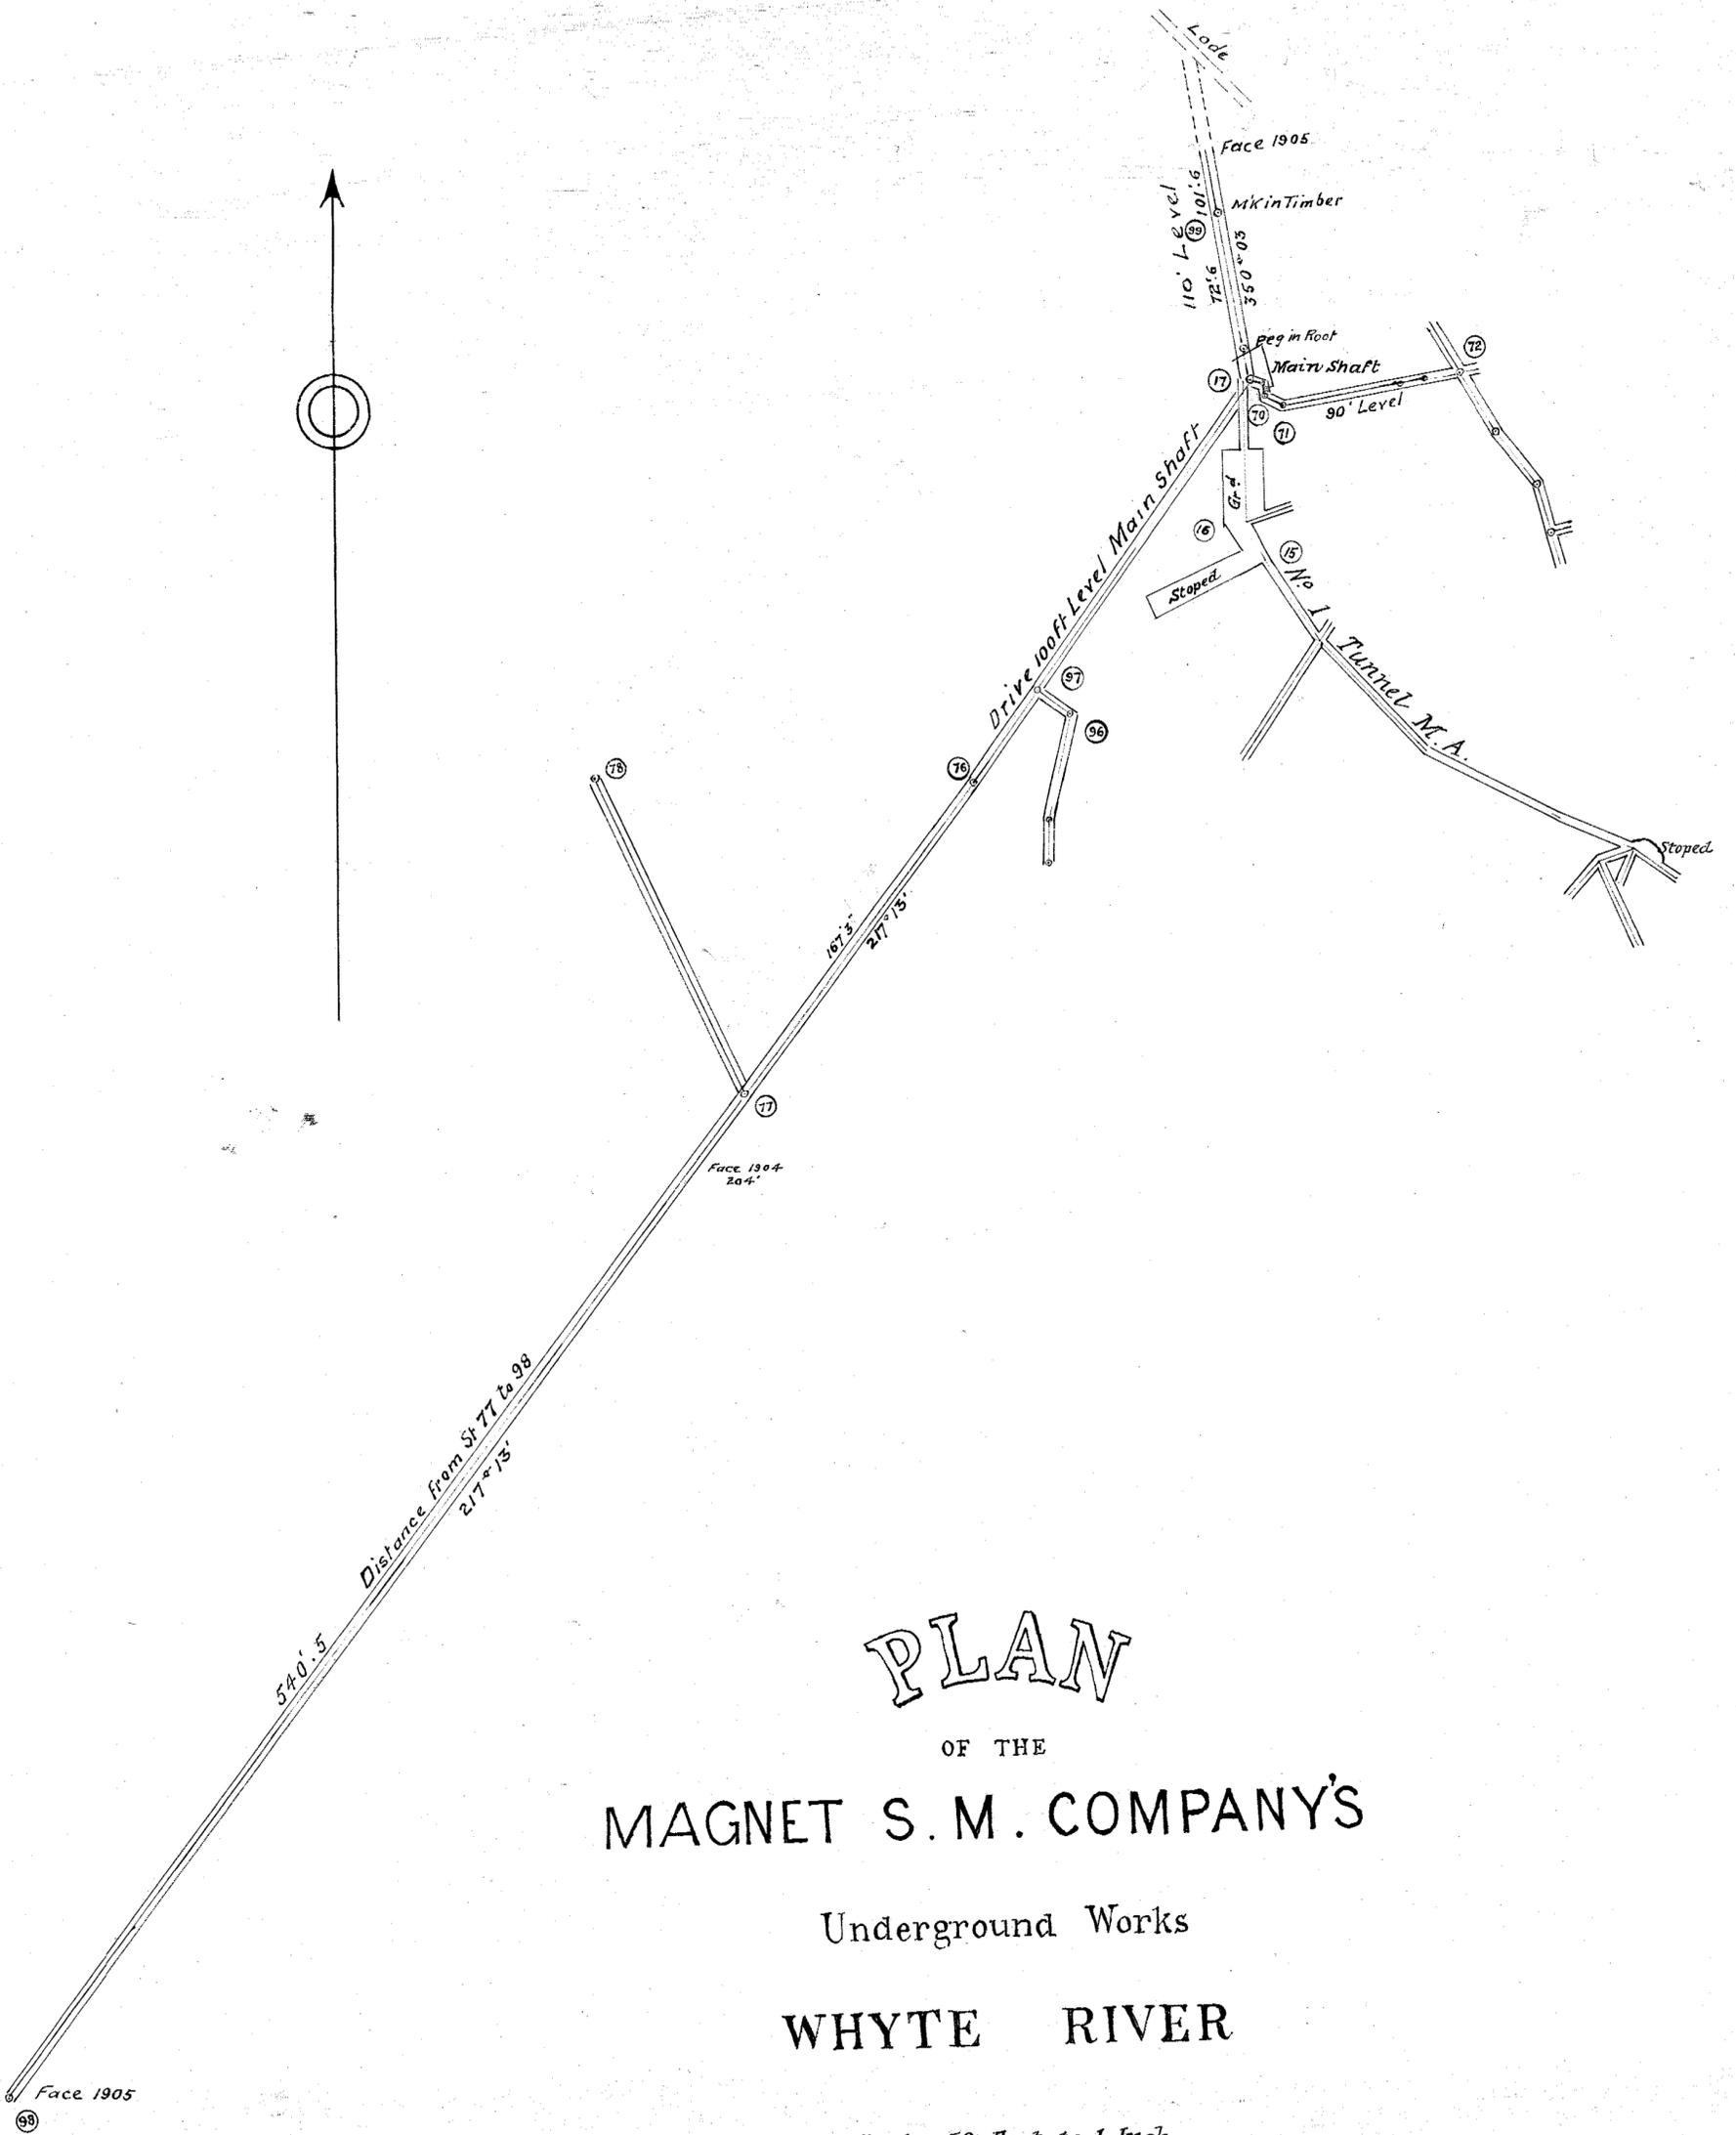

PLAN
 OF THE
MAGNET S. M. COMPANY'S
 Underground Works
WHYTE RIVER

Scale 50 Feet to 1 Inch

I, David Jones, Surveyor of Waratah, hereby declare this plan to be sufficiently correct for the purposes of the Mines Act of 1900

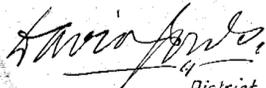
 District Surveyor
 Waratah, 20.6.06

Magnet S.M. Co. (Incorporated)
 Whyte River