


5

PLAN  
OF  
MAGNET SILVER MINING CO. N.L.  
WHYTE RIVER.

Scale 50 feet to One Inch

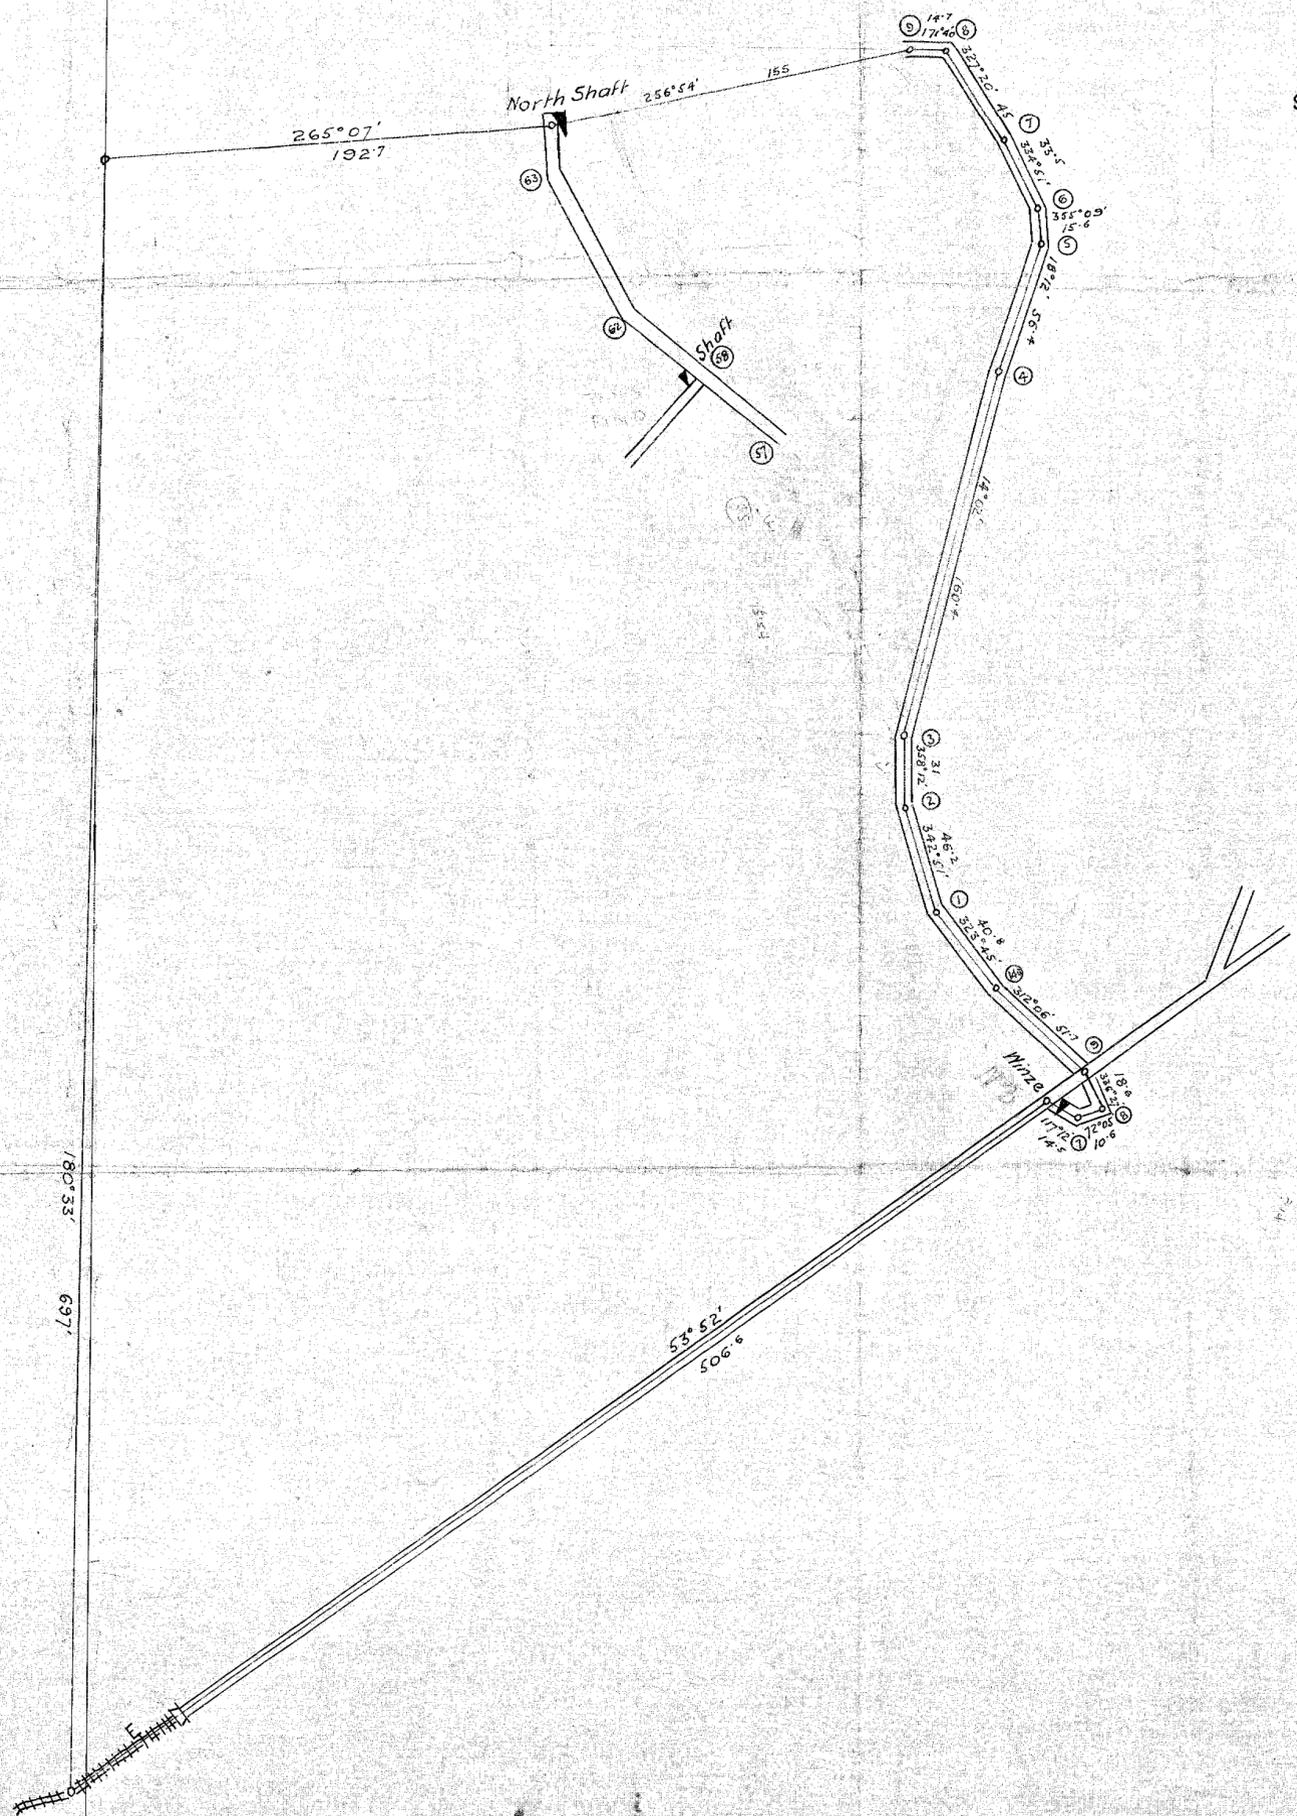

22-124

*David J. ...*  
*Chief Surveyor,*  
*Magnet, N.L.*  
 27. 7. 11.