

221-26

11-55-27-0
11-55-27-0
11-55-27-0

Plan


of

Underground Works

Magnet (Victorian) S. M. Co.

Scale 50 Feet to One Inch.

5 cm

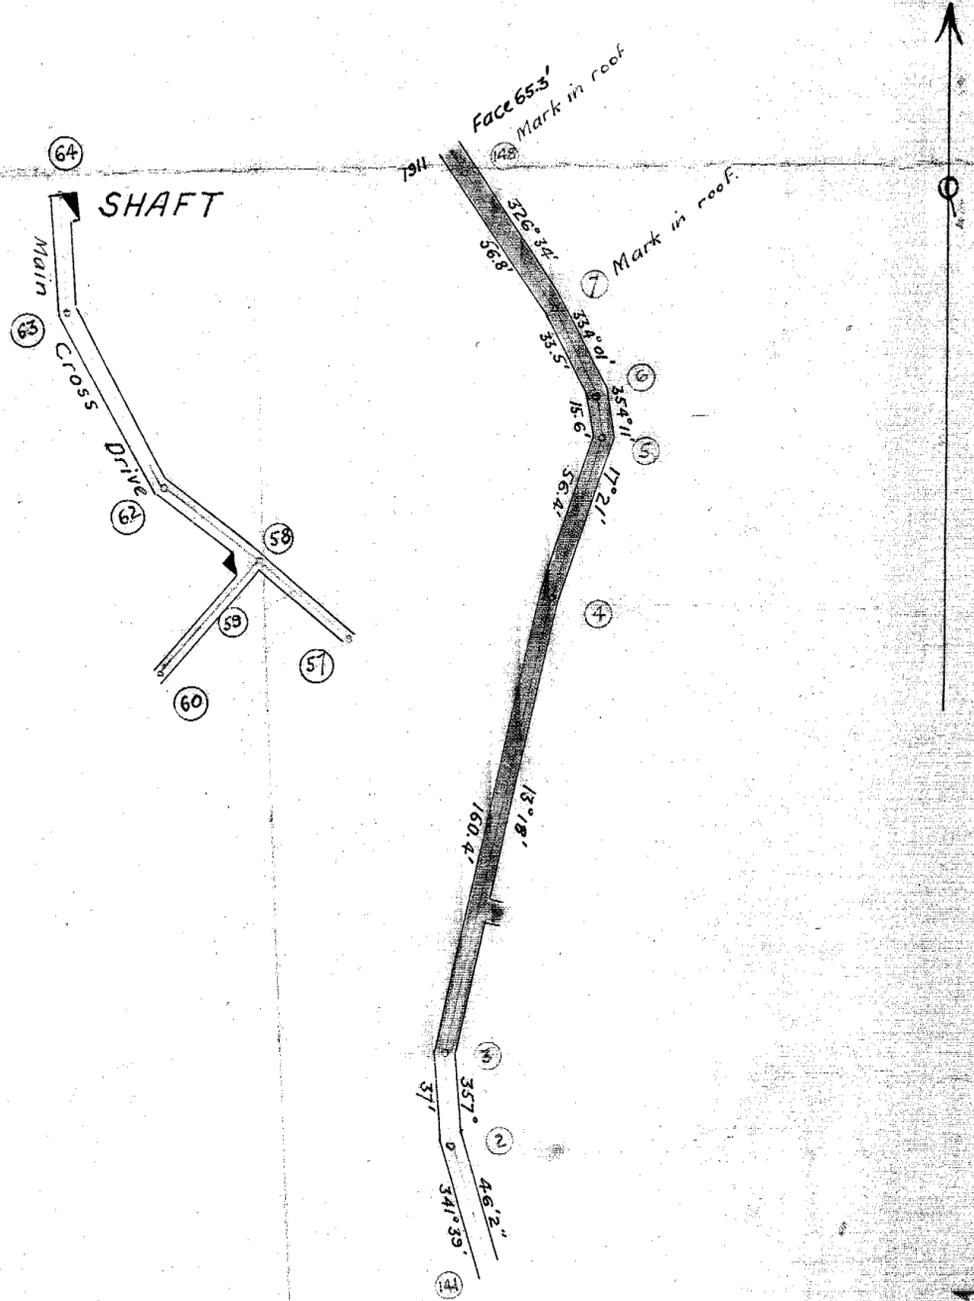

221-26

DAVID JONES
MINE & MEYOR
WASLEY, W.VA.

vide
lith. plan

vide
lith. plan
11-55-27-0
23: 5: 11