




221-27

221-27

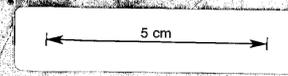

MAGNET (VIC) S.M.CO.
 formerly
 GODKIN S.M. COMPANY'S
 Underground Works
 WHYTE RIVER

Scale 50 Feet to 1 Inch.

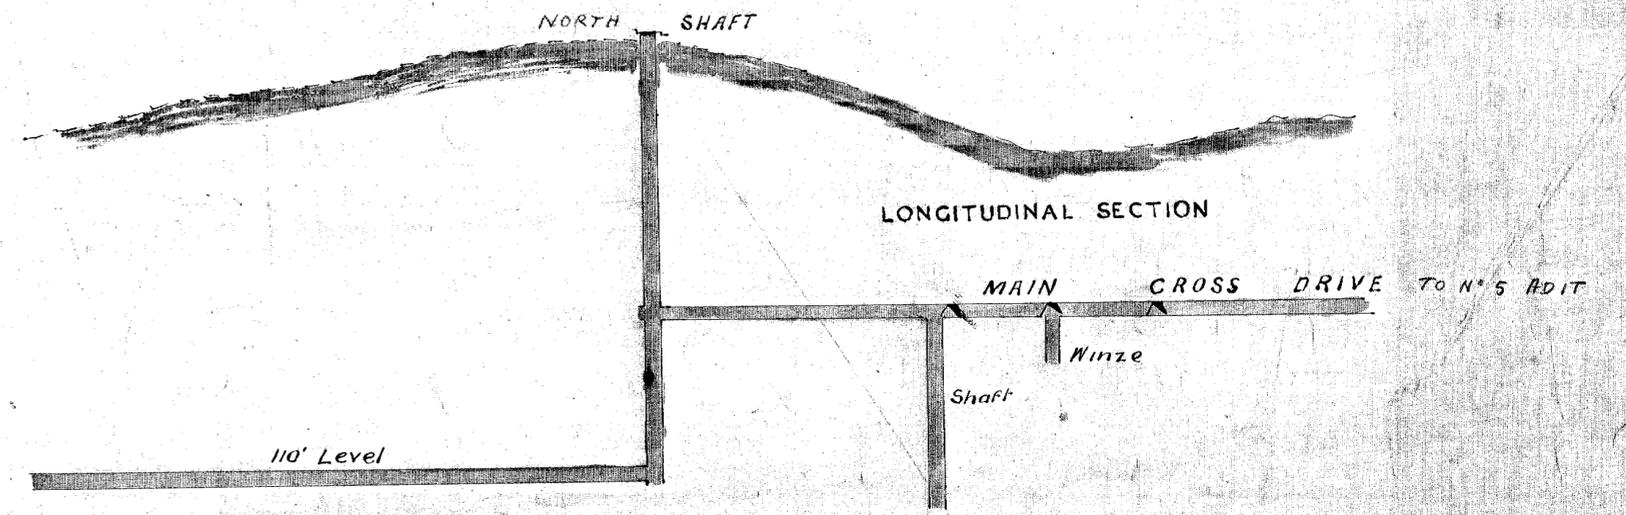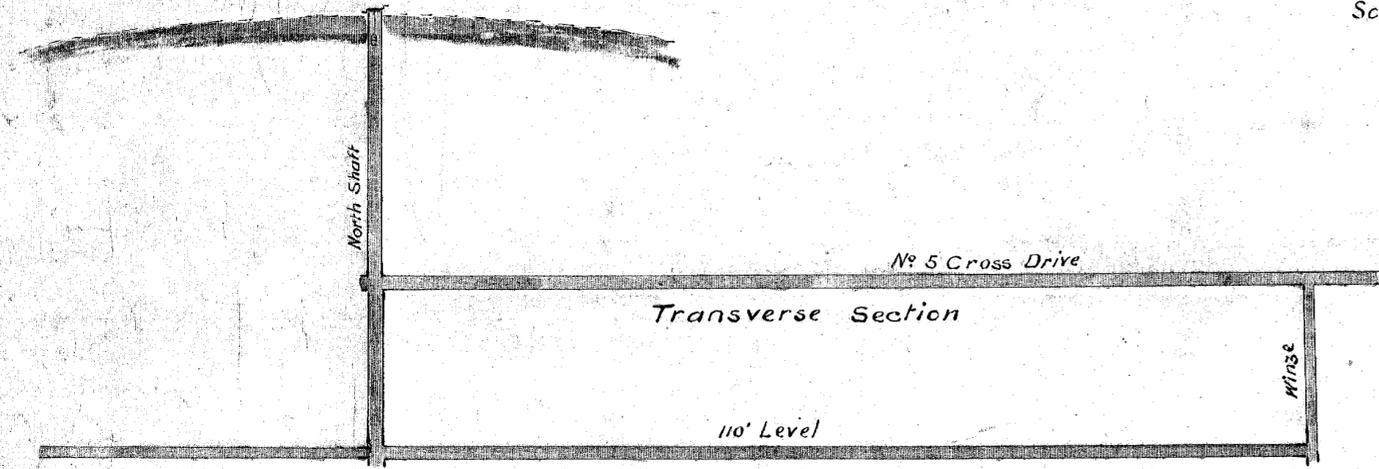

Handwritten notes: 221-27, 1917, 1932, 3/7

David Jones,
 Dist Surveyor
 Waratah Tas.
 31. 7. 17.

Handwritten vertical text: GODKIN'S

1927