


TEMPORARY

THE MAGNET S.M.C.
N.L.

Scale 25 feet to 1 inch.

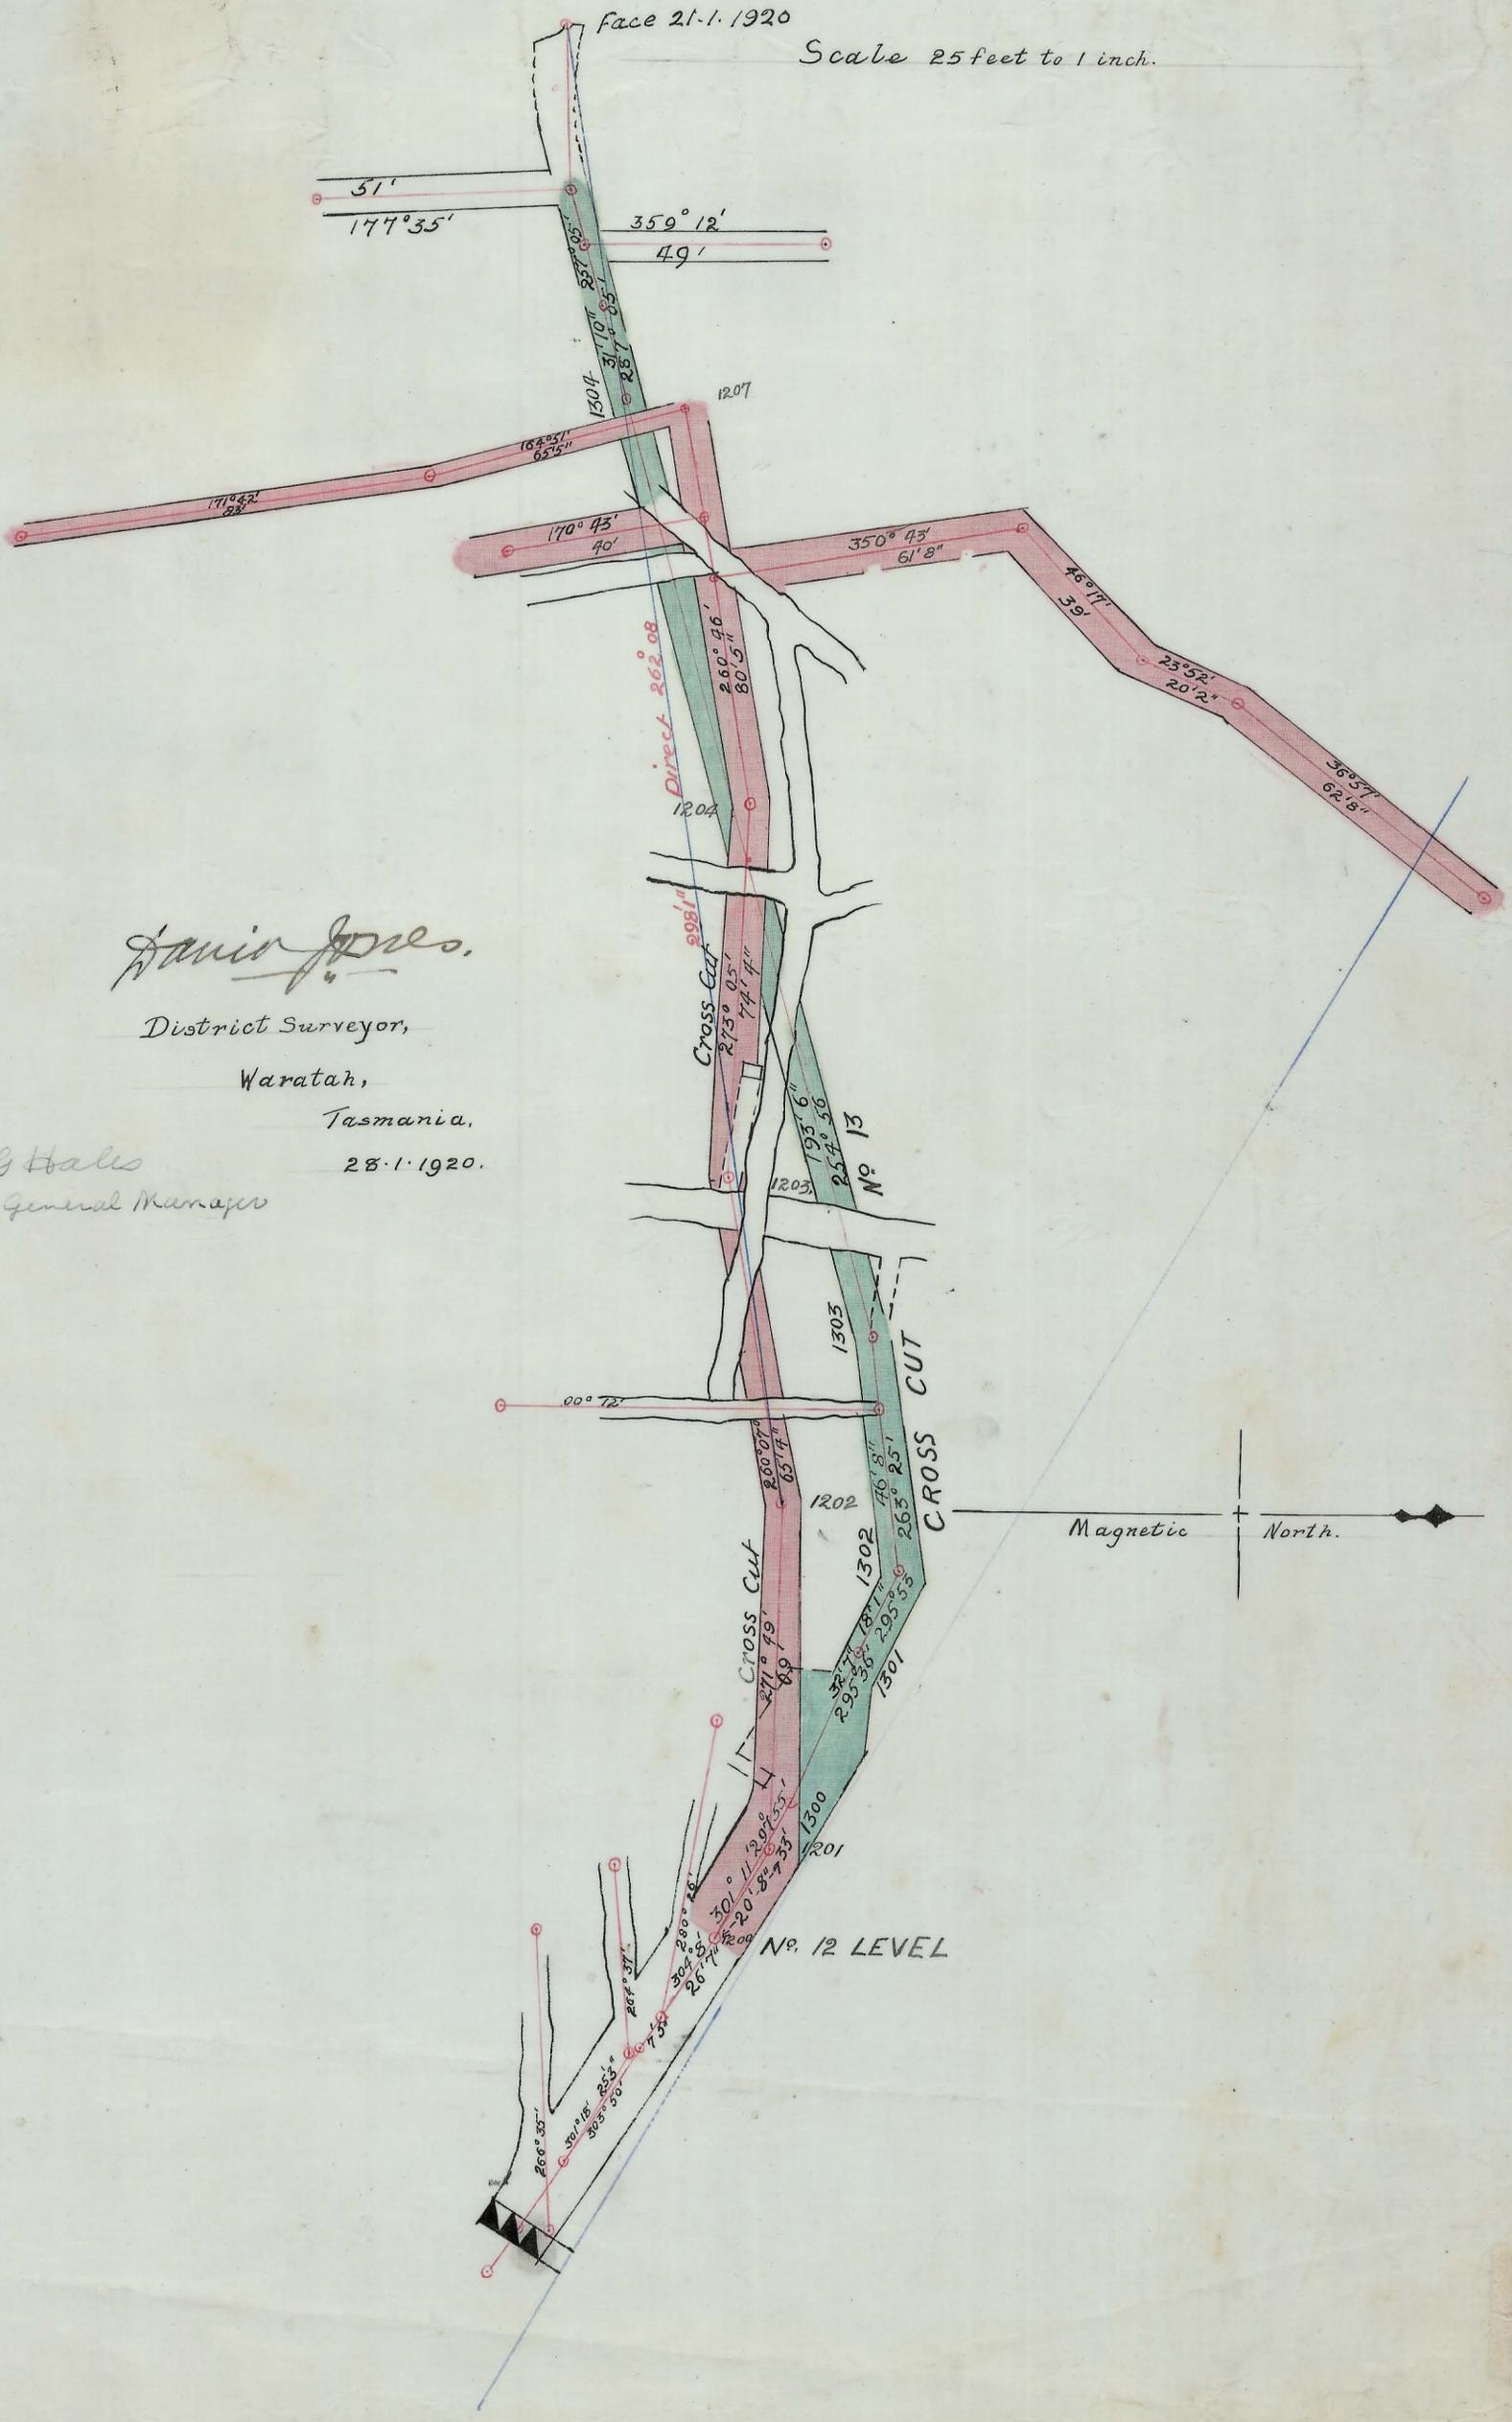

Janio Jones,
District Surveyor,
Waratah,
Tasmania.

R.G. Hales
General Manager
28-1-1920.

121