


221-33

221-33

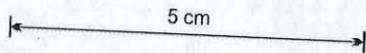

Face 22.1.1920.

28.1.1920

David Jones,
Dist + Mining
Surveyor -
Mauritius.

R. G. Hales
General Manager

SOUTH ADIT

1205.8

291.7 Face 8.1.1919

1188'

273.9

Scale 25 feet to 1 inch

