


5 cm

221-34

Plan Magnet S. M. Co.

Underground Workings.
Scale 25 feet to an Inch
1920,

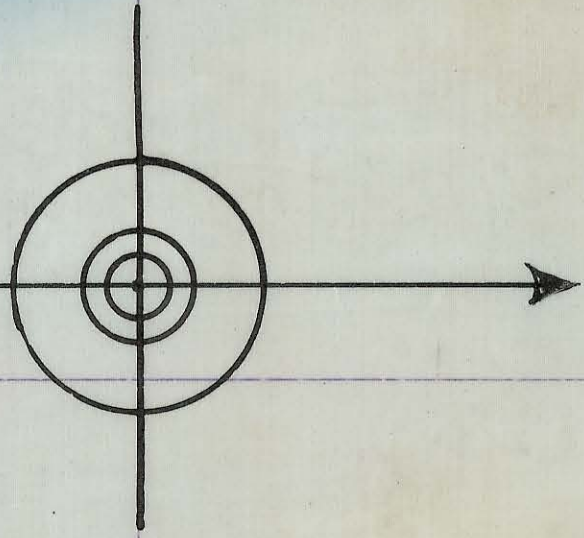

R. G. Hales
General Manager
26/3/21

H. J. Hales
Mining Surveyor
8-3-21