

221-35


5 cm

221-35

Magnet Silver Mining Co. Section

Scale 25 feet to an inch

1920

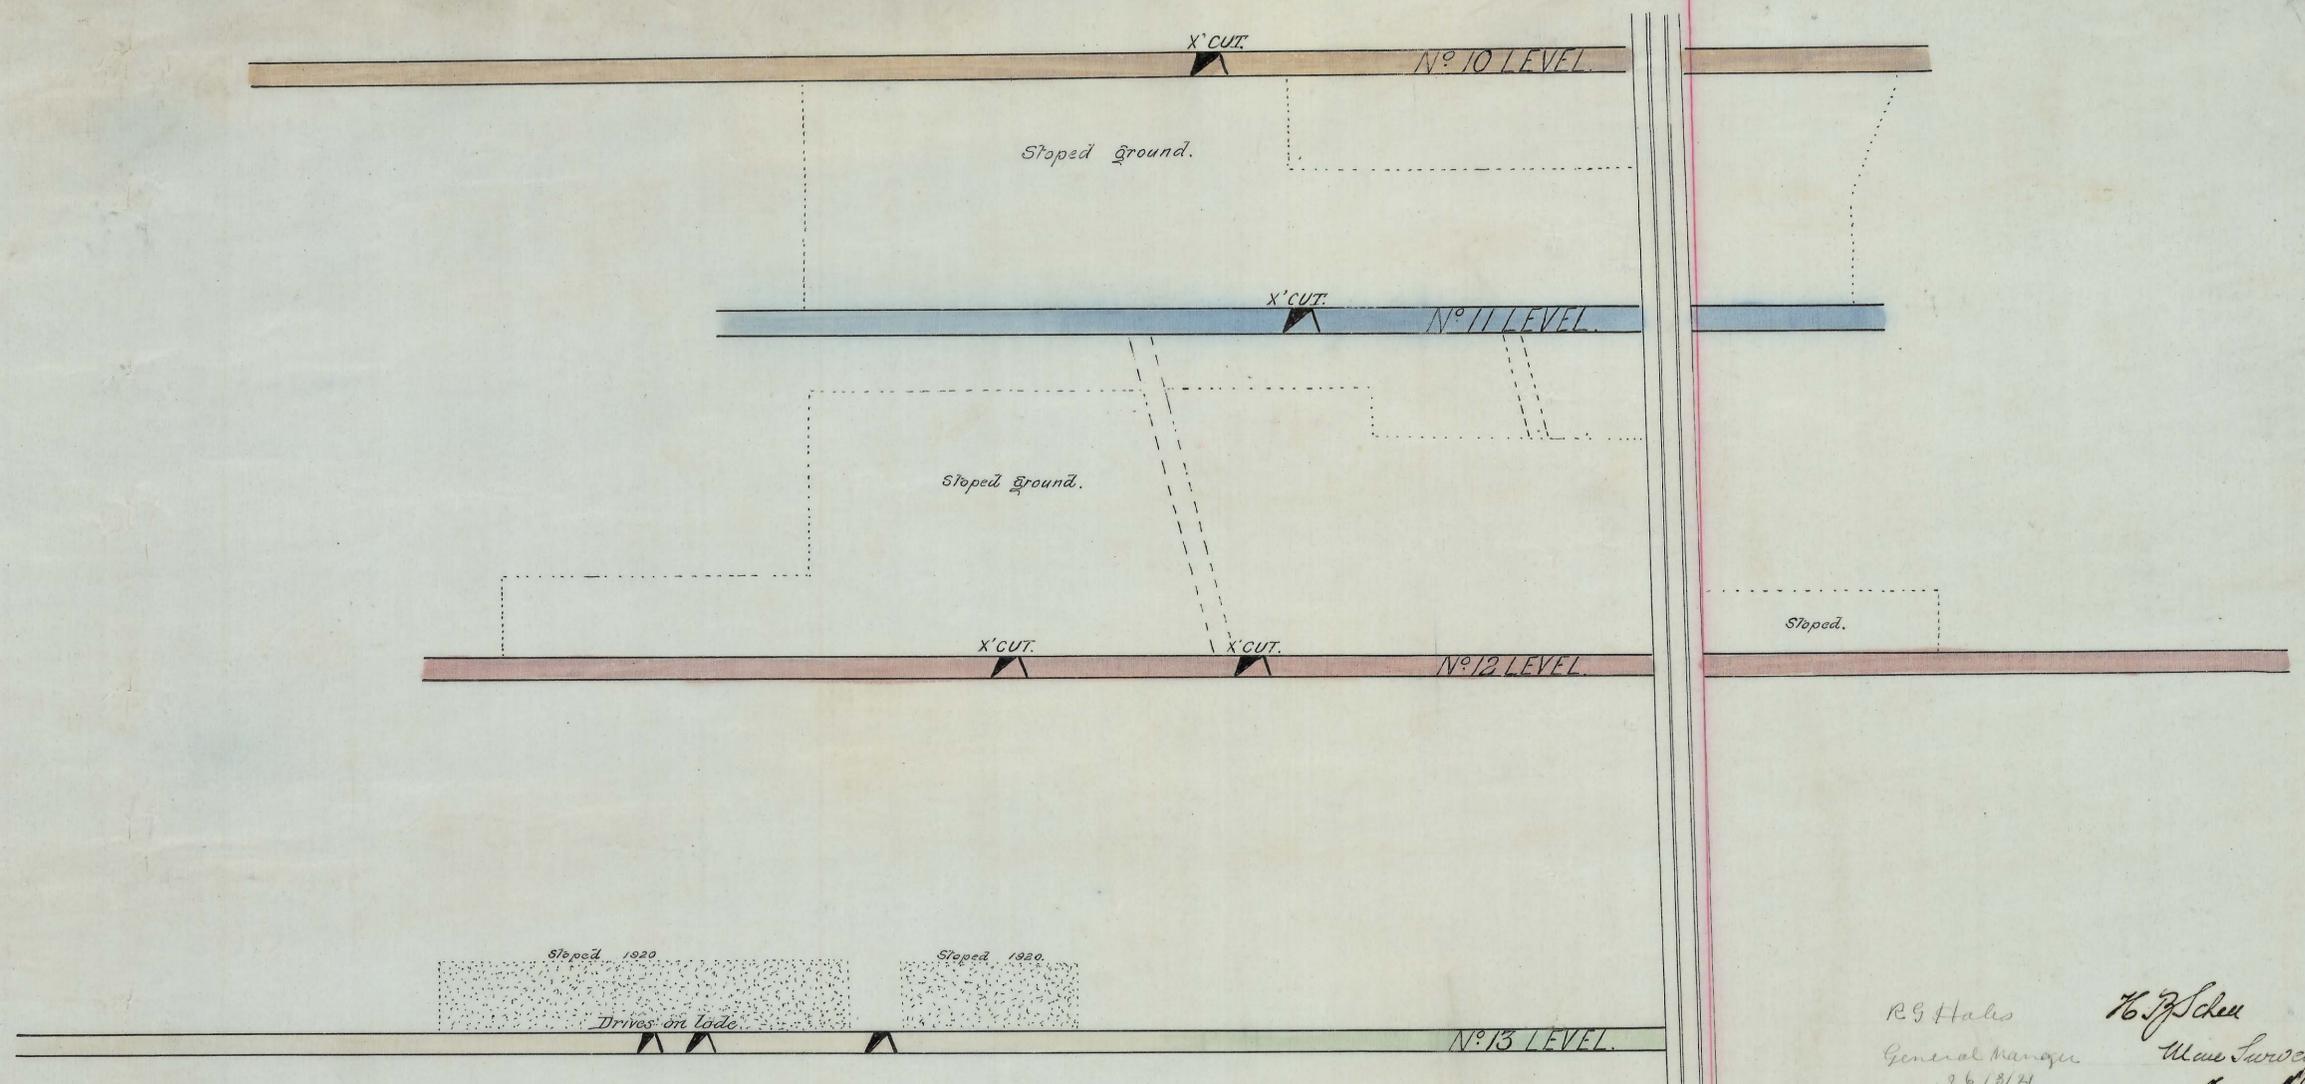

R.S. Hales
General Manager
26/8/21

H. J. Schen
Mine Surveyor
Mar 8 1921