
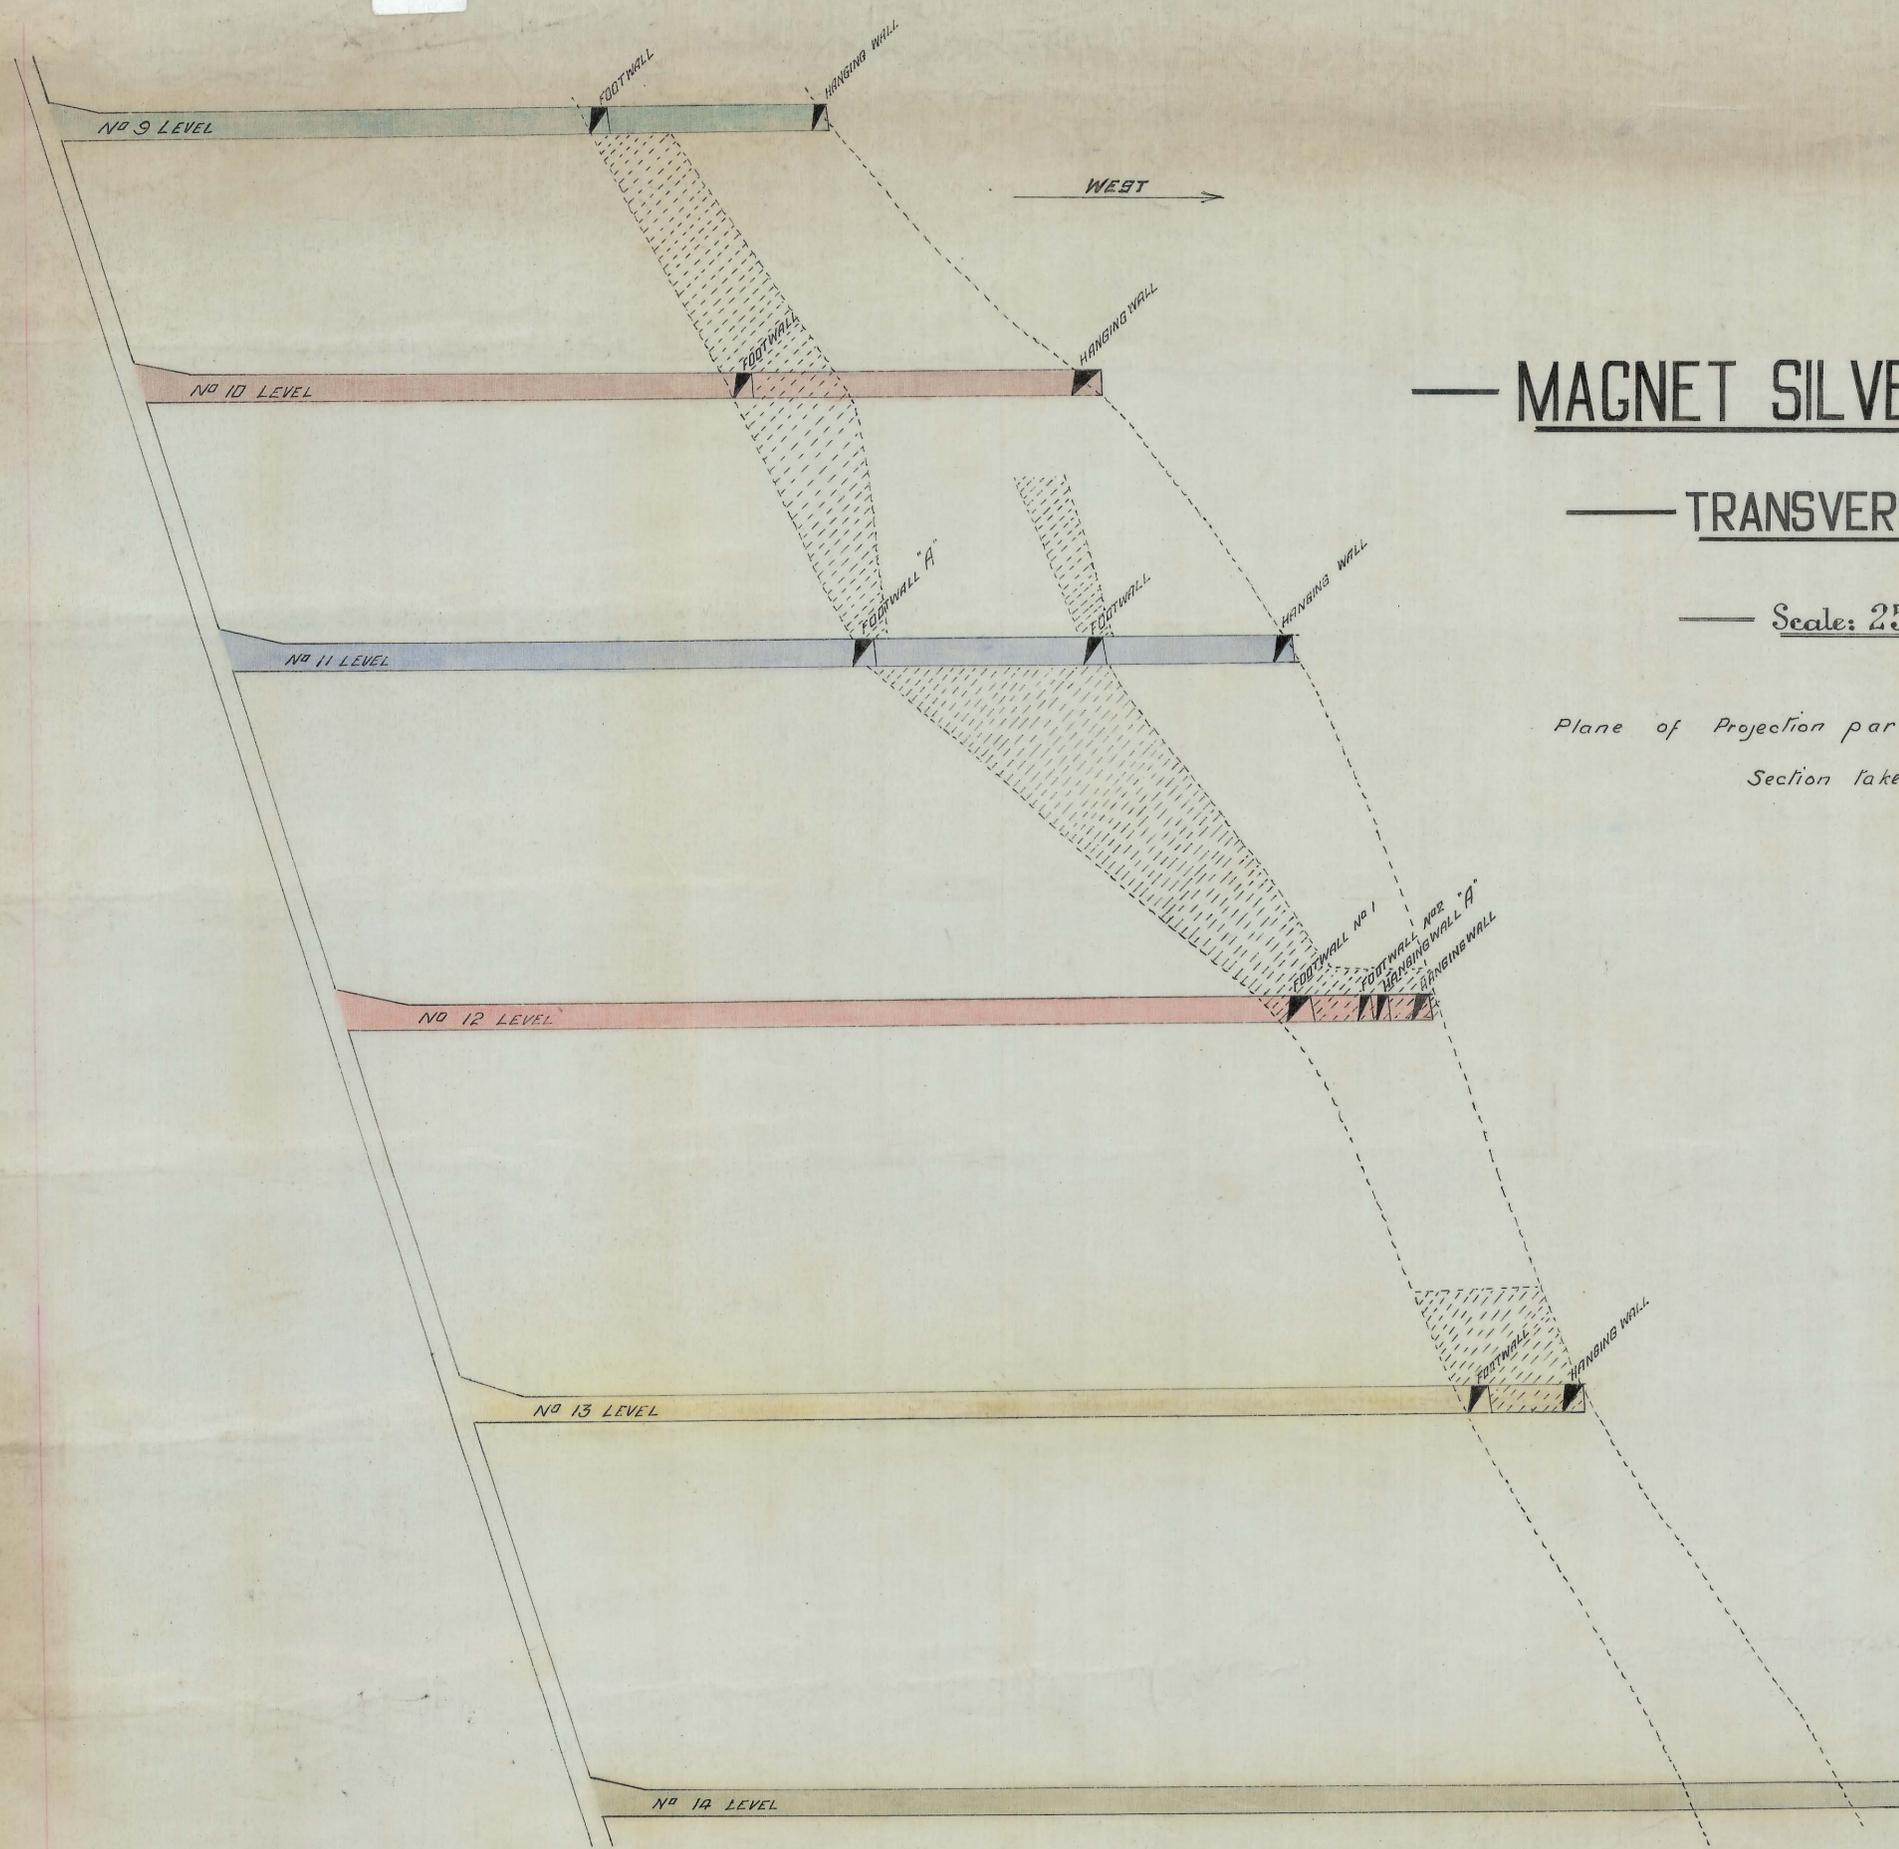


221-36

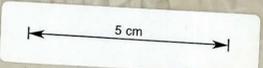

MAGNET SILVER MINING CO. N.L.

TRANSVERSE SECTION

Scale: 25 Feet to 1 Inch

Plane of Projection parallel to line of No 4 Crosscut
Section taken along Main Crosscuts

*Honorable
Mine Surveyor
25-3-22.
R. G. Hales
General Manager
25-3-22*