

# MAGNET SILVER MINING CO. N.L.

## LONGITUDINAL SECTION


Scale: 25 Feet to 1 Inch

Plane of Projection Perpendicular to line of No 4 Crosscut

NORTH

5 cm

221-37

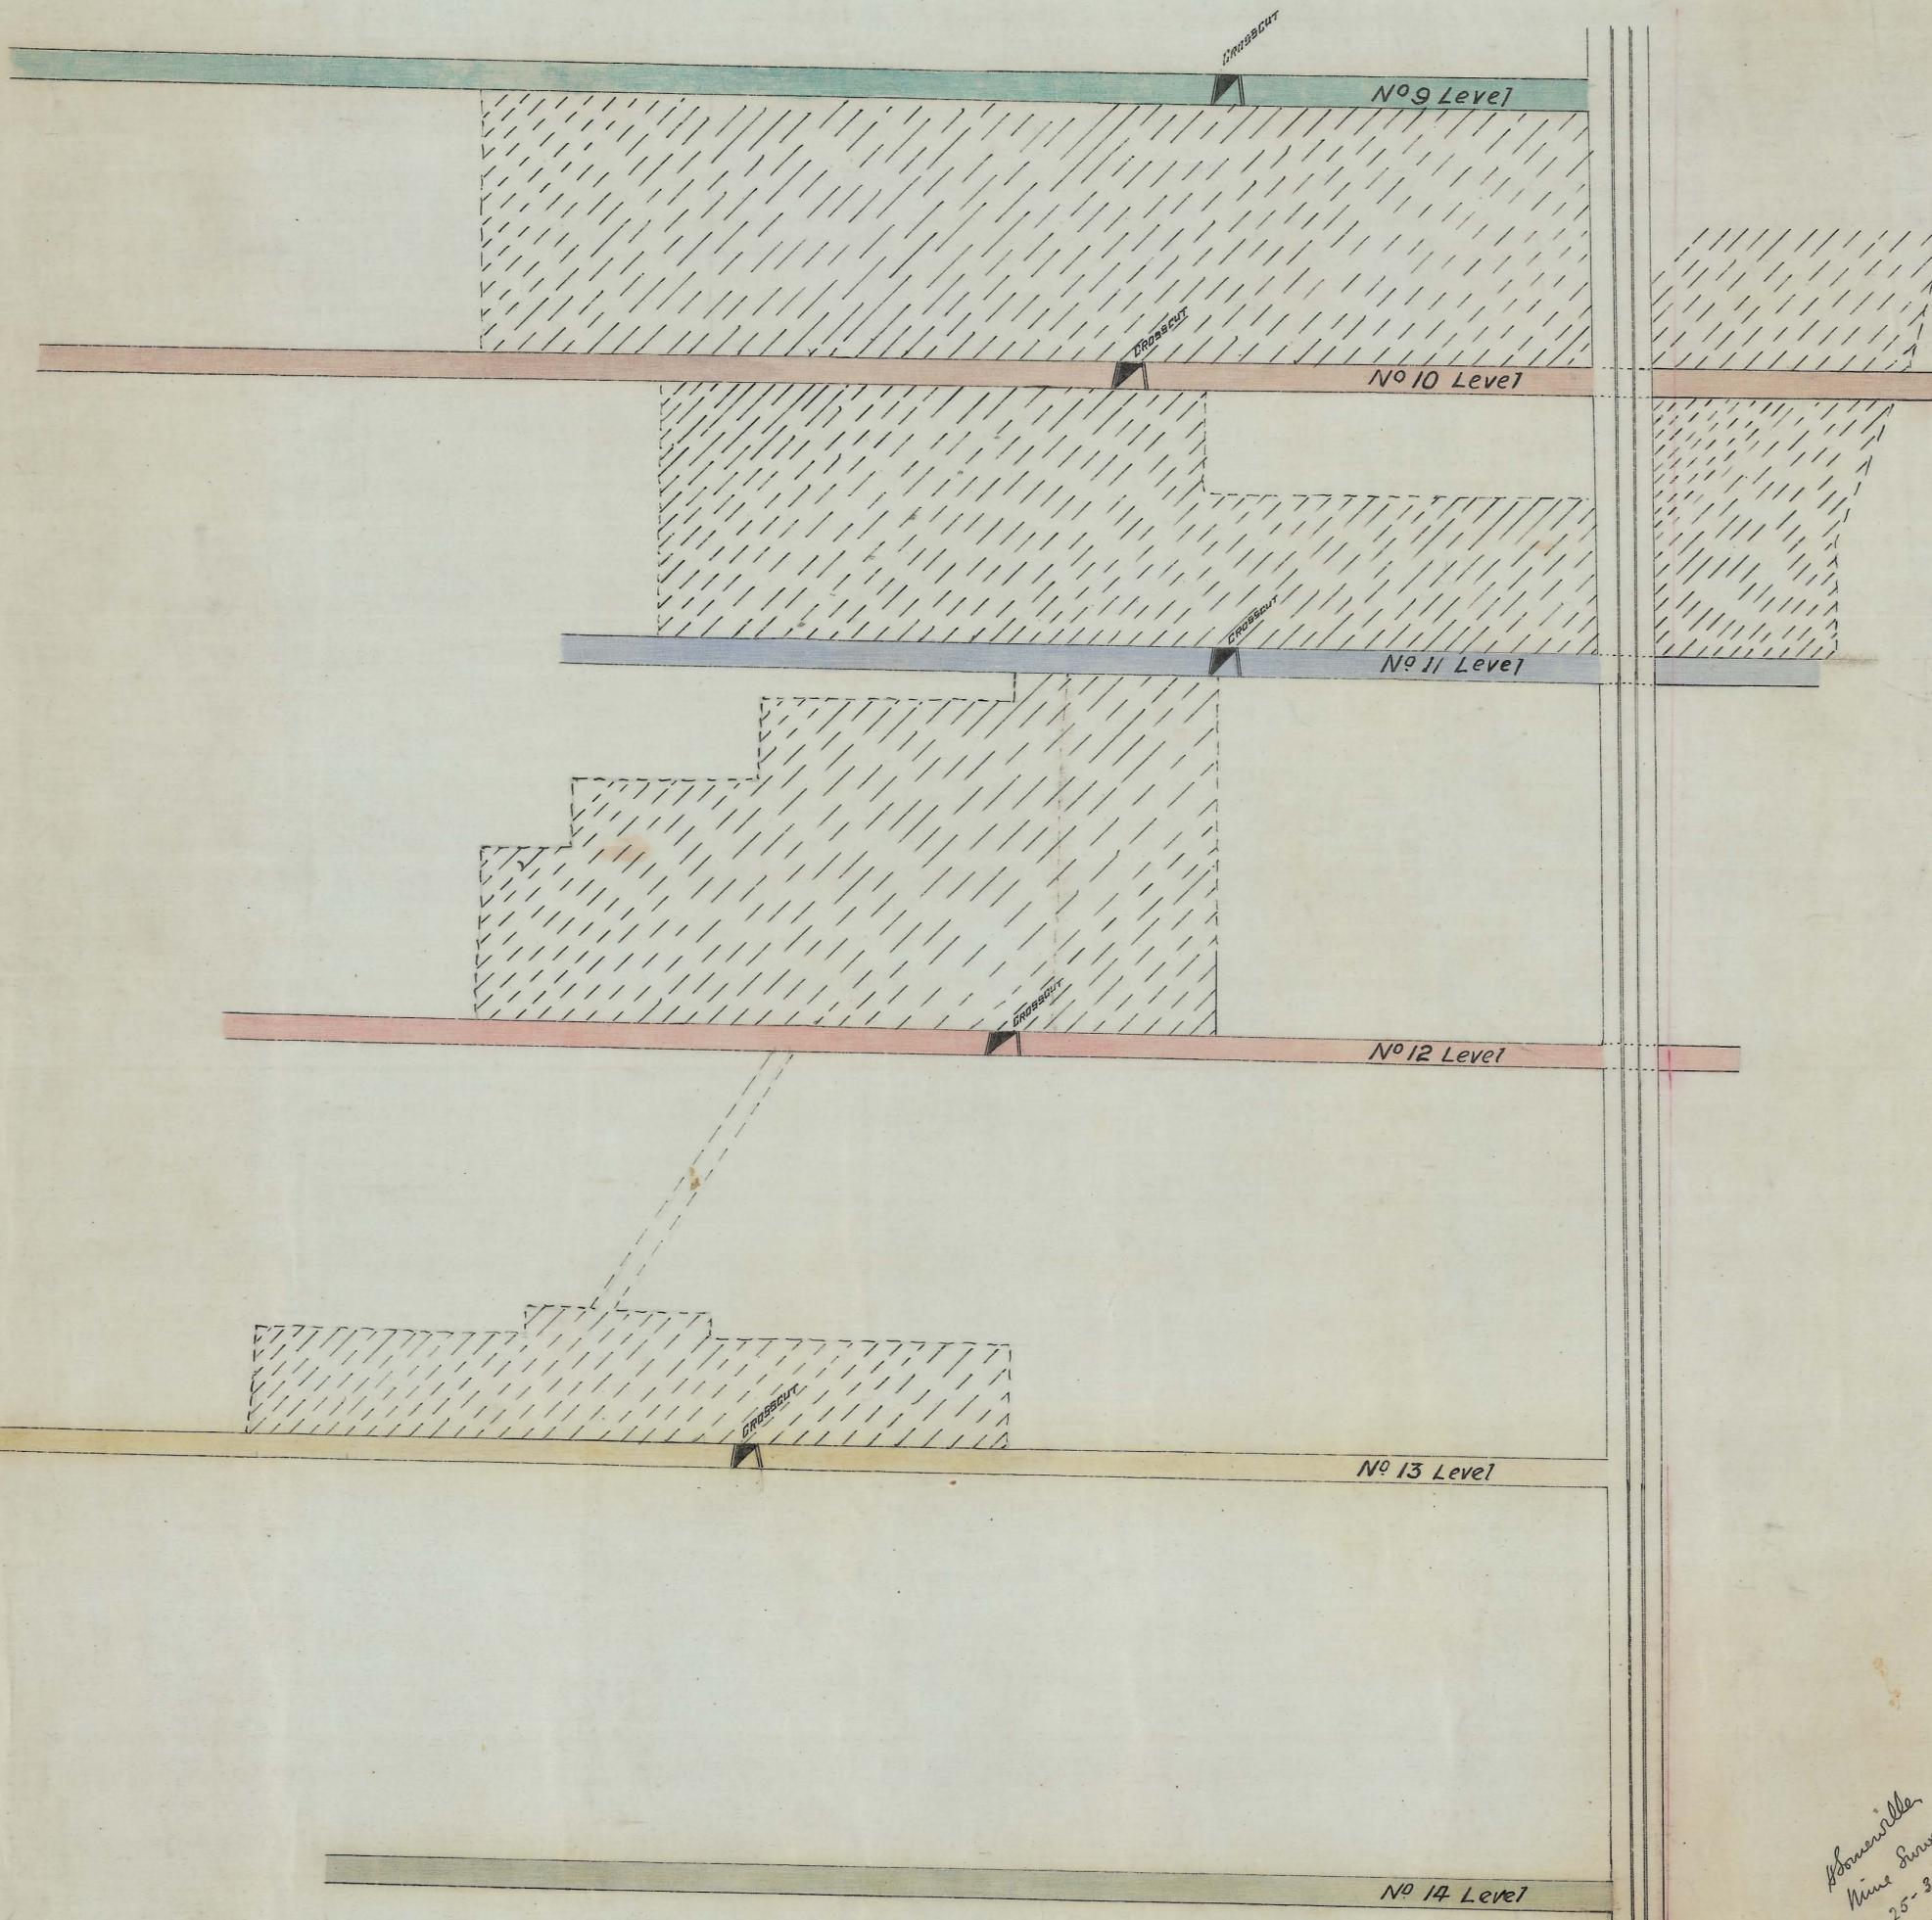

Bonerville  
Mine Surveyor  
25-3-22.  
R. J. Walsh  
General Manager  
28-3-22