


MAGNET SILVER MINING COY

LONGITUDINAL SECTION OF UNDERGROUND WORKINGS
Plane of projection perpendicular to line of N° 4 Crosscut.

Scale. 25 Feet to an Inch.

Edgar Brutchett
1/5/23.

R. G. Hales
General Manager

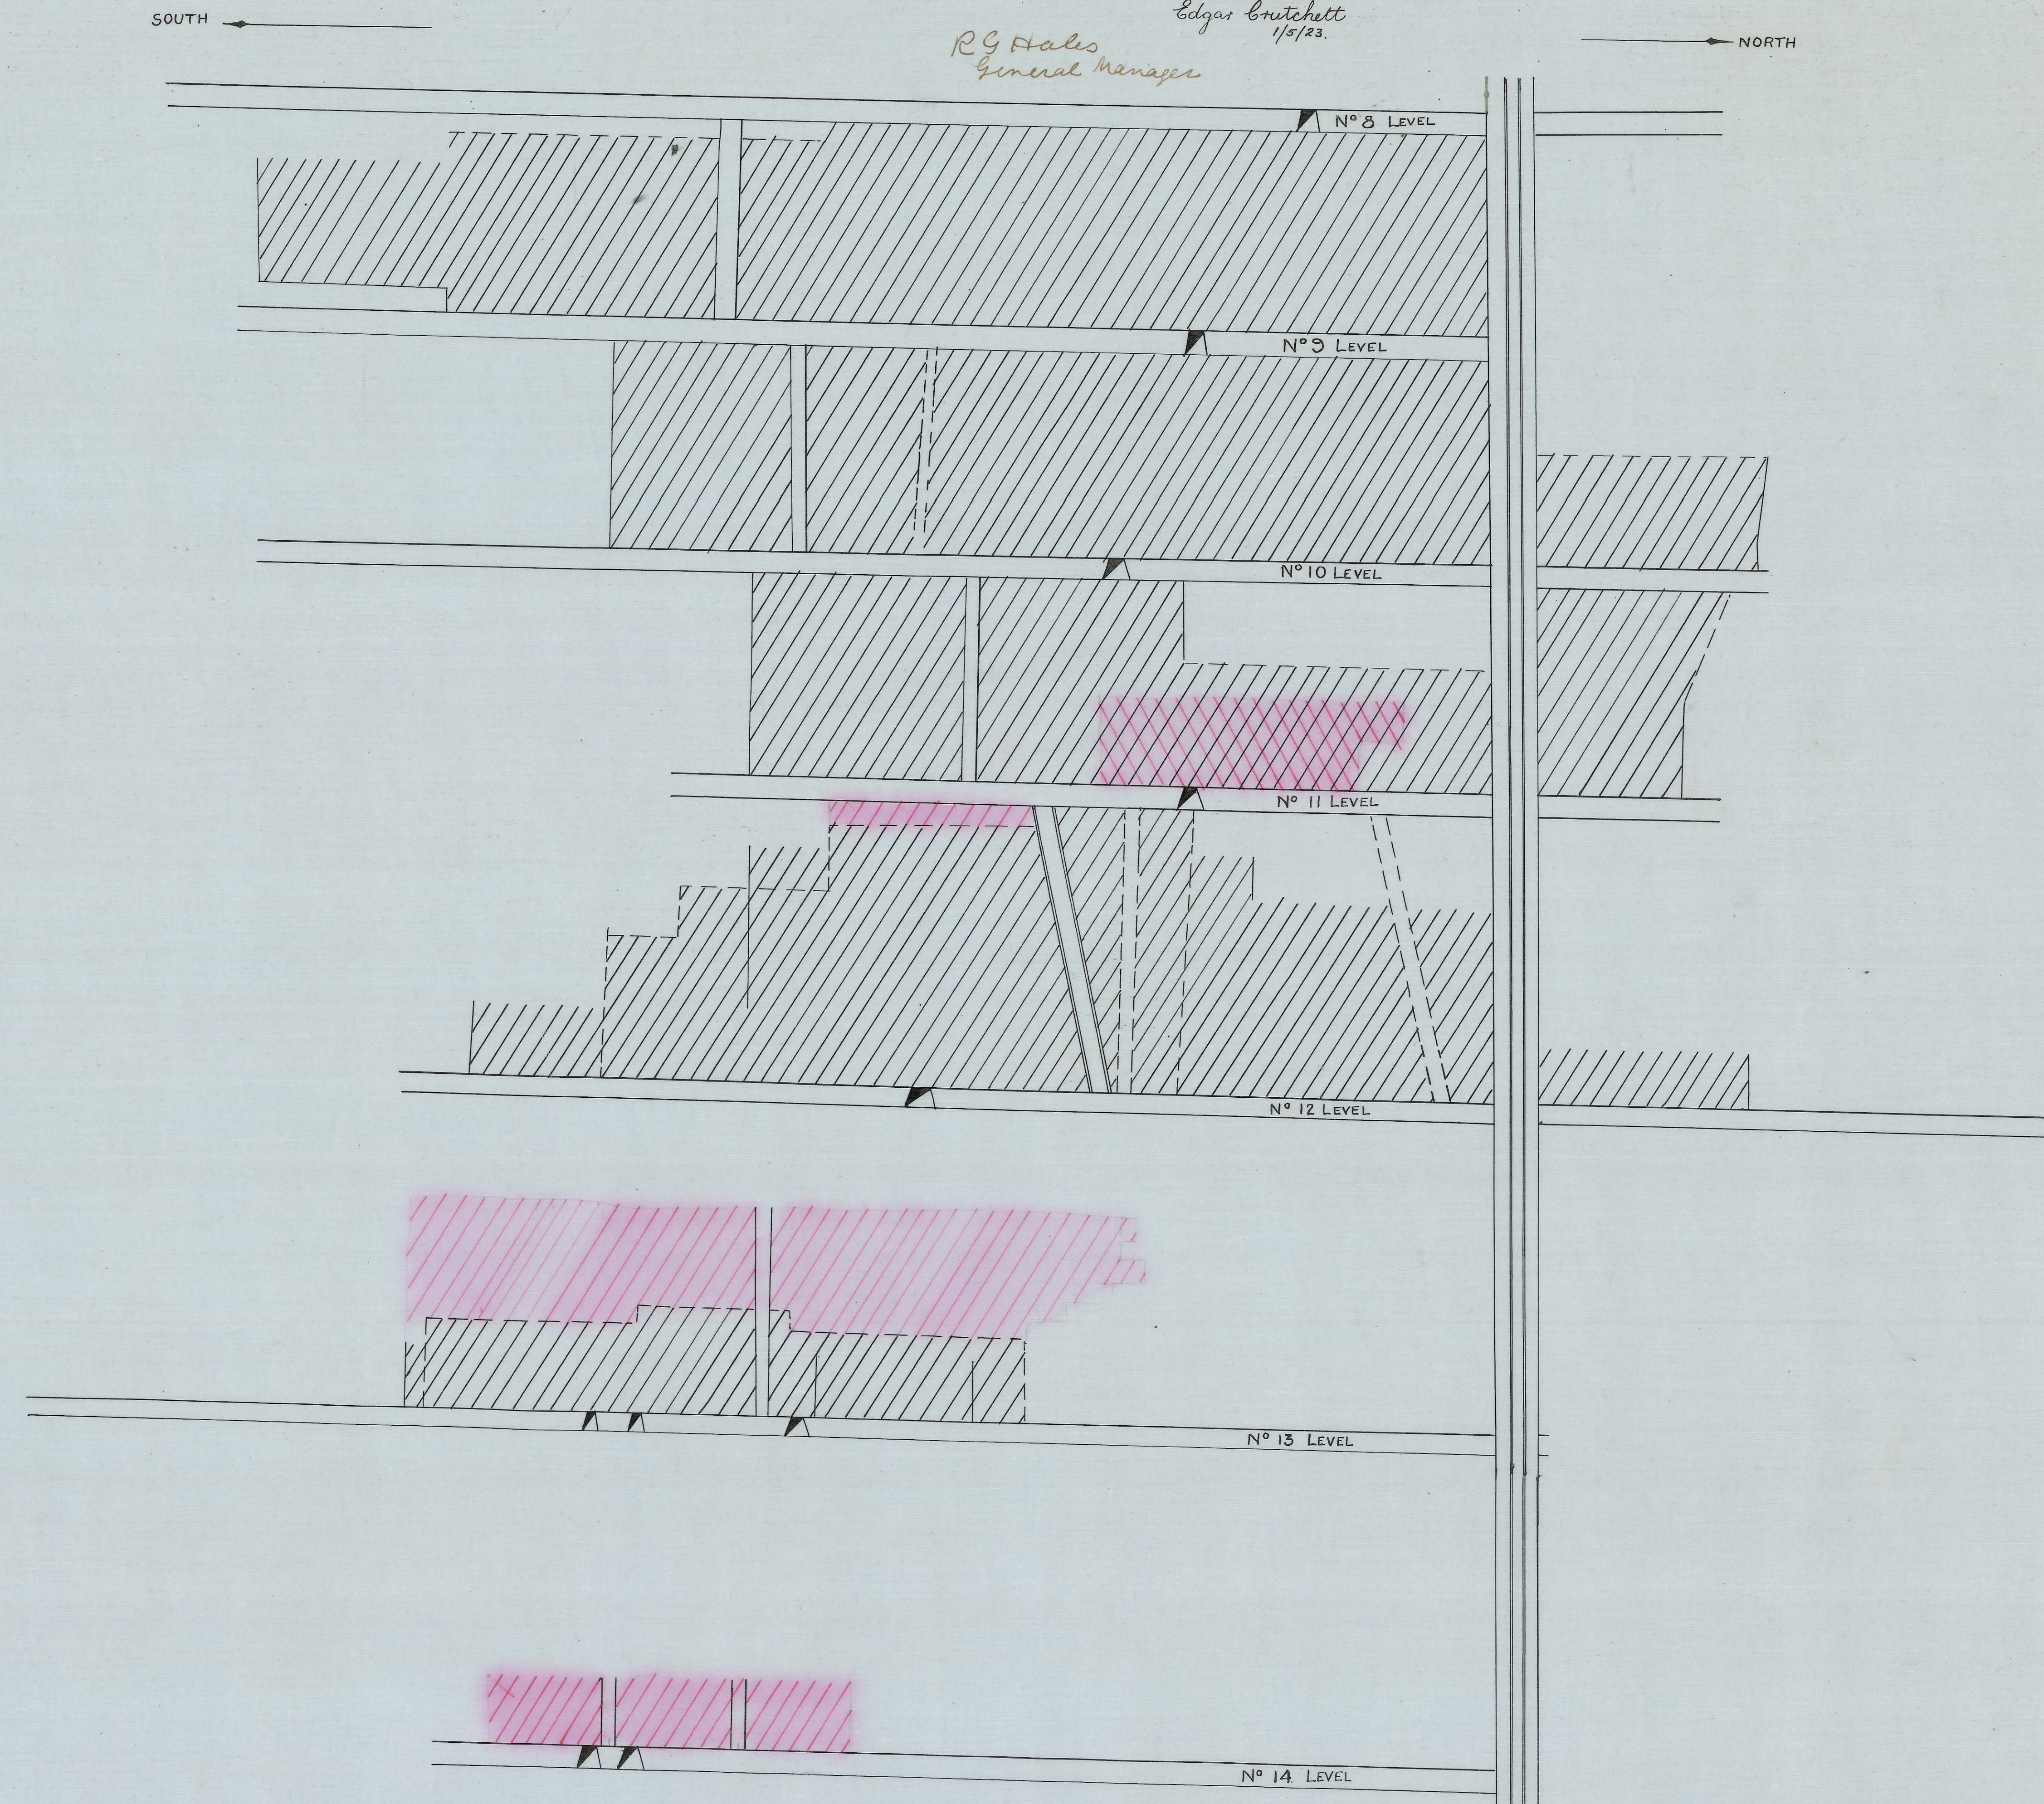

221-38

5 in

221-38