

221-44

MAGNET SILVER MINING CO. N.L.

TRANSVERSE SECTION.

Scale: 25 Feet to 1 Inch.



Plane of projection parallel to line of No 4 Crosscut

Section taken along Main Crosscut

Mine Surveyor
Edgar Brutchett

Date
May 1st 1923.

R G Hales
General Manager

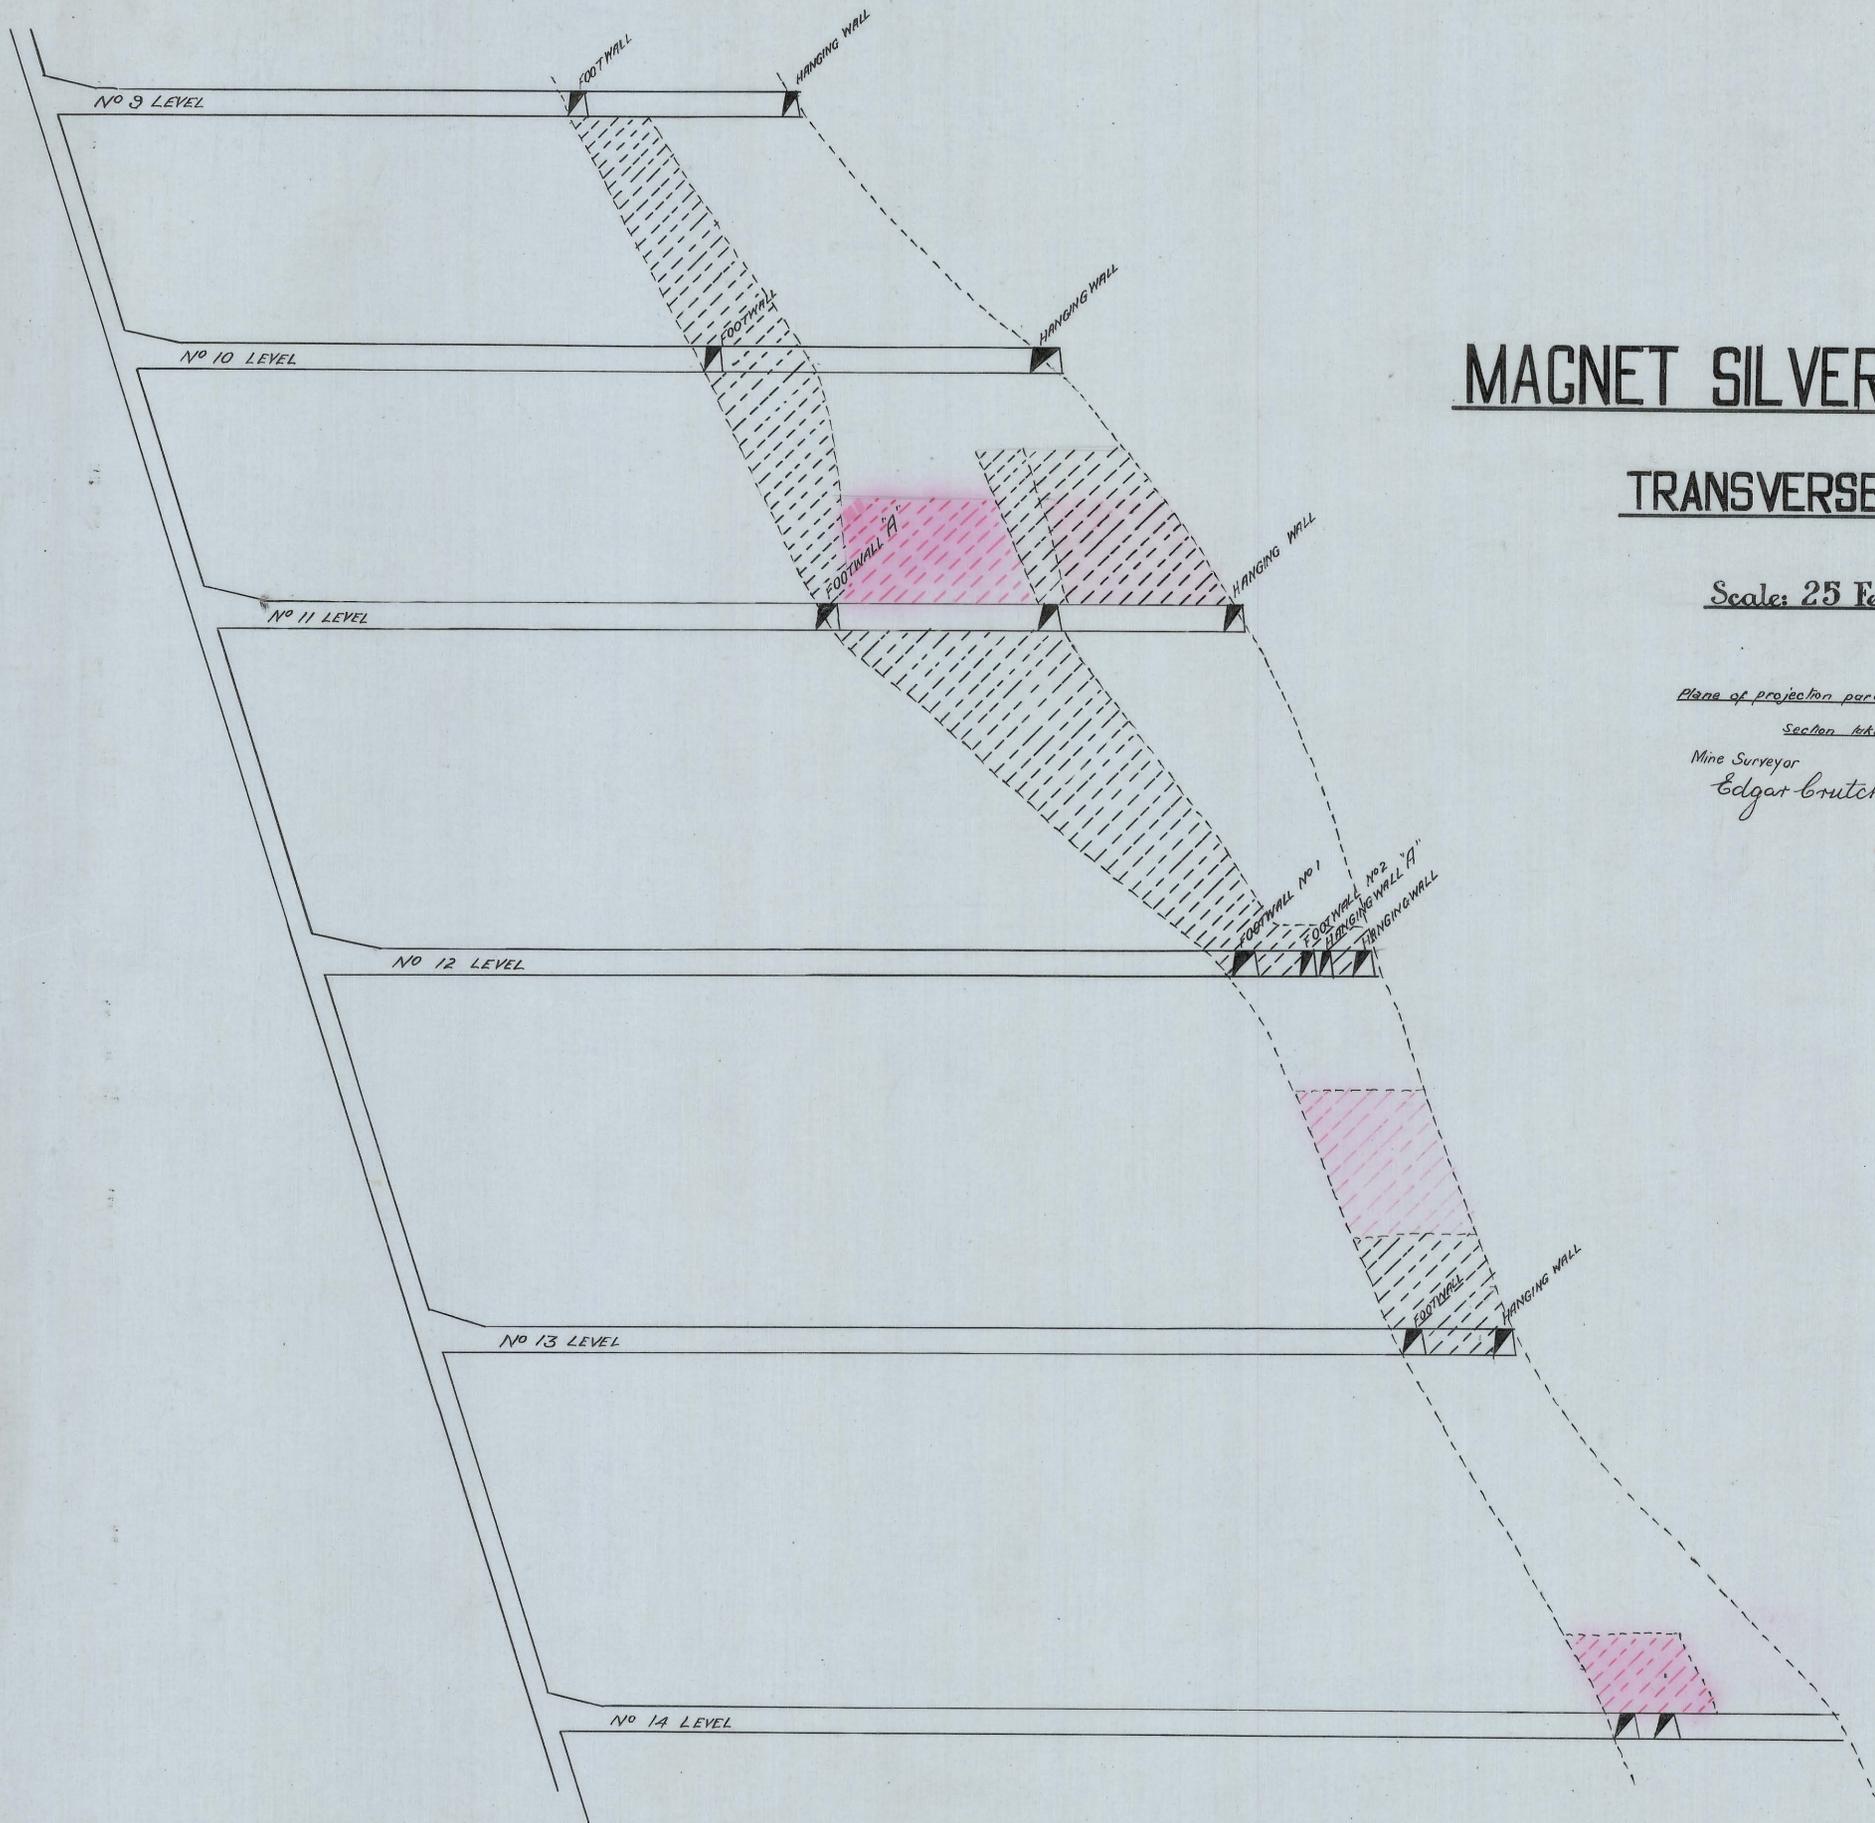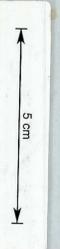

221-44