




MAGNET SILVER MINING CO. N. L.

PLAN OF NO. 8 AND NO. 10 LEVELS AND NO. 3 ADIT

— Scale 25 Feet to 1 Inch —

FOR YEAR ENDING DECEMBER 1923.

GENERAL MANAGER — R. G. Hails
 MINE SURVEYOR — Edgar Brutchett

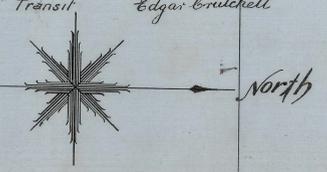

221-42

221-42