


*David Jones*  
*Asst Surveyor*  
*Narator, Tex.*  
*17. 2. 15*

9. 1. 15

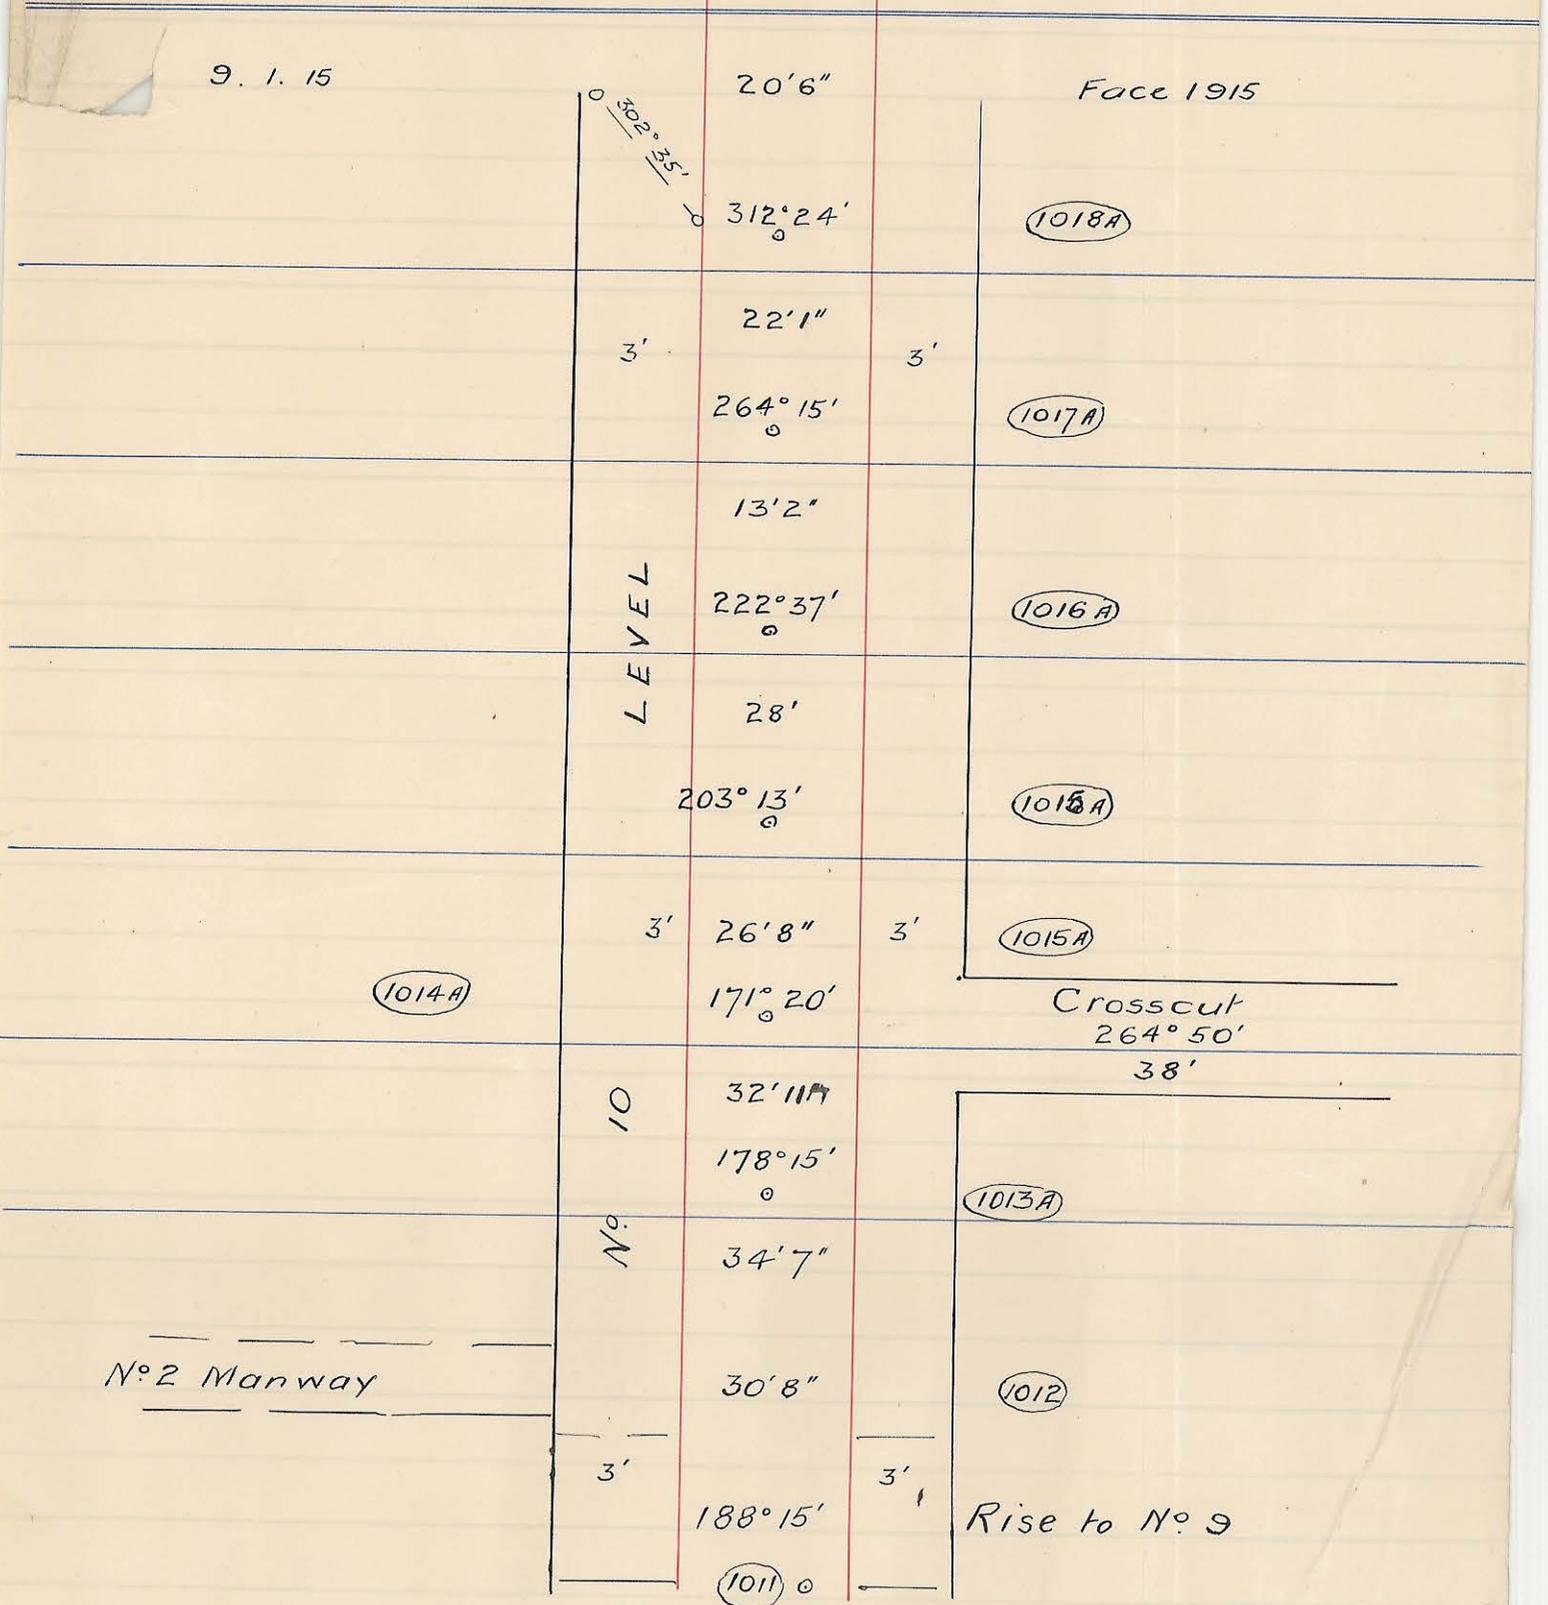

29'4"

bearing of last line 172°11' back bearing 352°11' distance continuation of N° 10 Level from St (1011) on Plan of mine Magnet Mine, Magnet, 9<sup>th</sup> January 1915 Survey of