



David Jones,
Dist Surveyor
Haratata, Tasmania.

March 14th 1916.

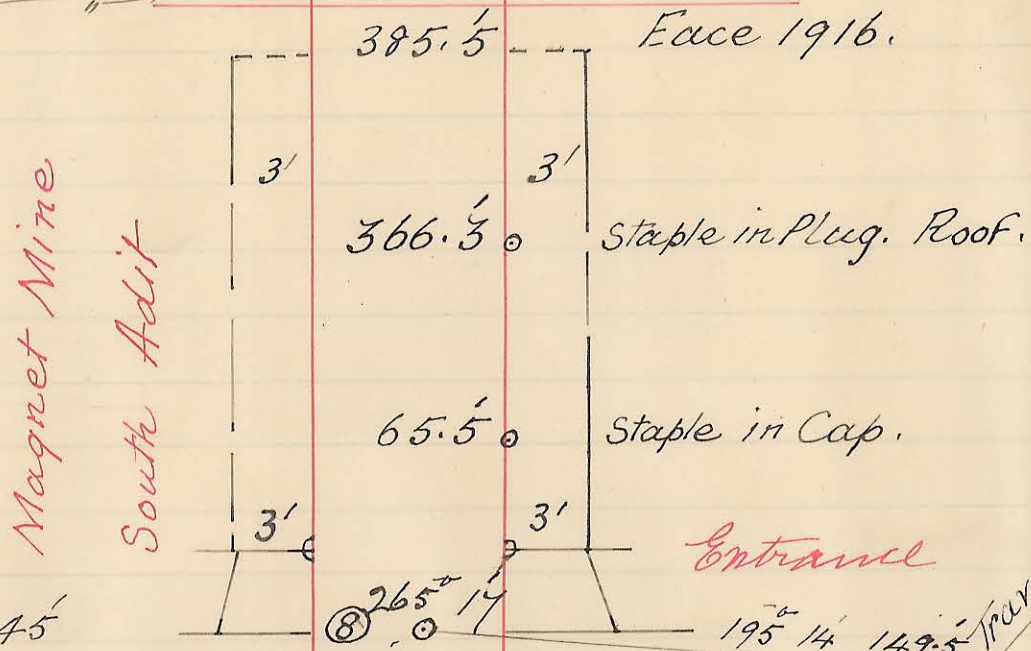


LE 0° 45'
Entrance of Adit H. 8 from No. 4 Tunnel.
Survey of South Adit from rail in cap piece first set
Magnet S. h. b. o. h. L. Magnet. 21. 2. 16.

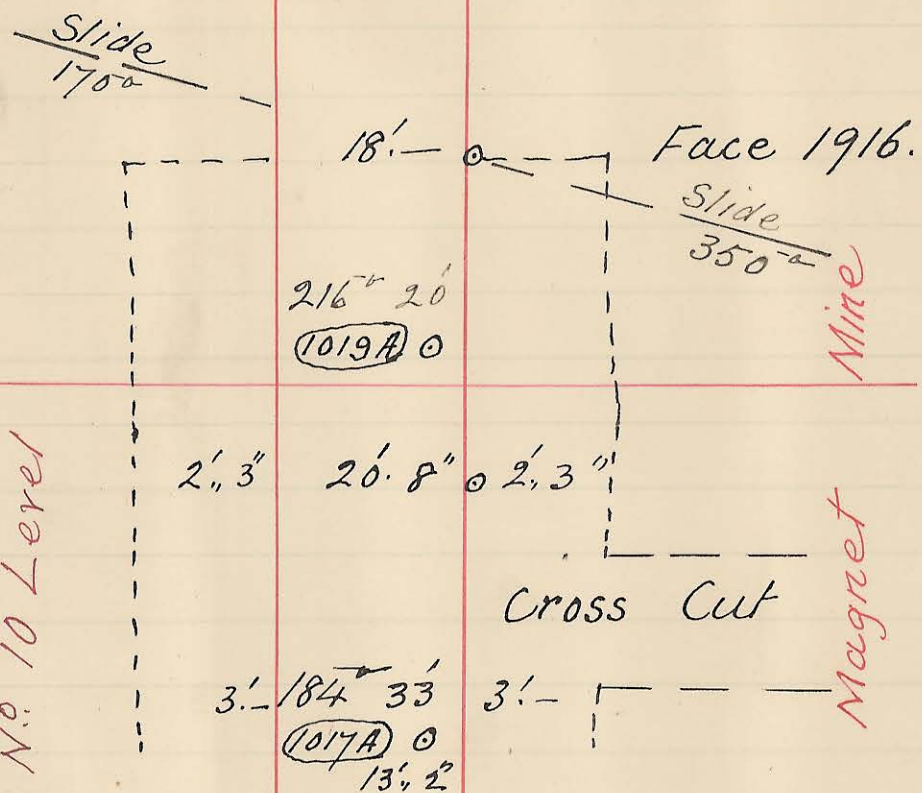

Station 1017A at end of distance 13' 2" on bearing of 222° 37'.
No. 10 Level. Continuation of Survey of No. 10 Level from
Magnet S. h. b. o. h. L. Magnet, Tasmania. 21. 2. 16.

David Jones,
Dist Surveyor, Haratata, Tasmania.
13. 3. 16.

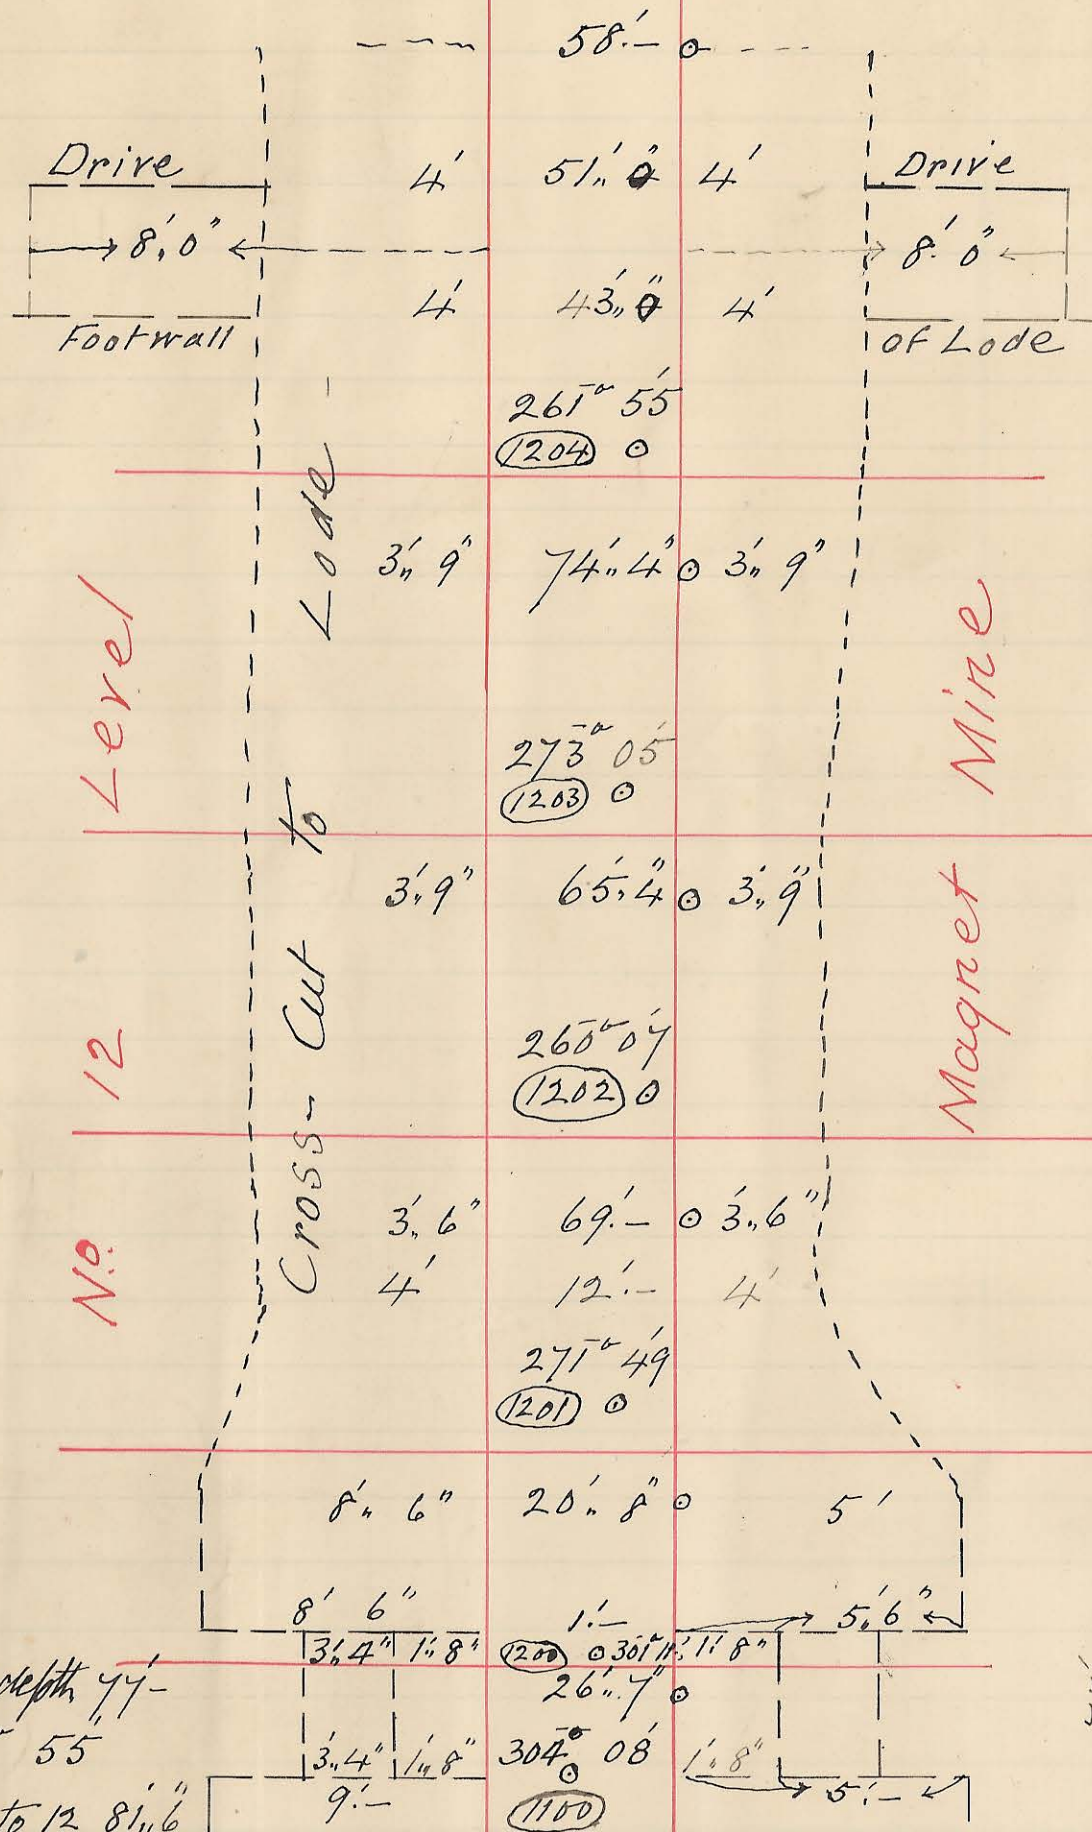

Vertical depth 44'

LD 70° 55'

his. No. 11 to 12 8' 6"

Level. Sunday.
Survey from No. 11 Level down Incline Shaft to No. 12
Magnet S. h. b. o. h. L. Magnet Tasmania. 20. 2. 16.

