
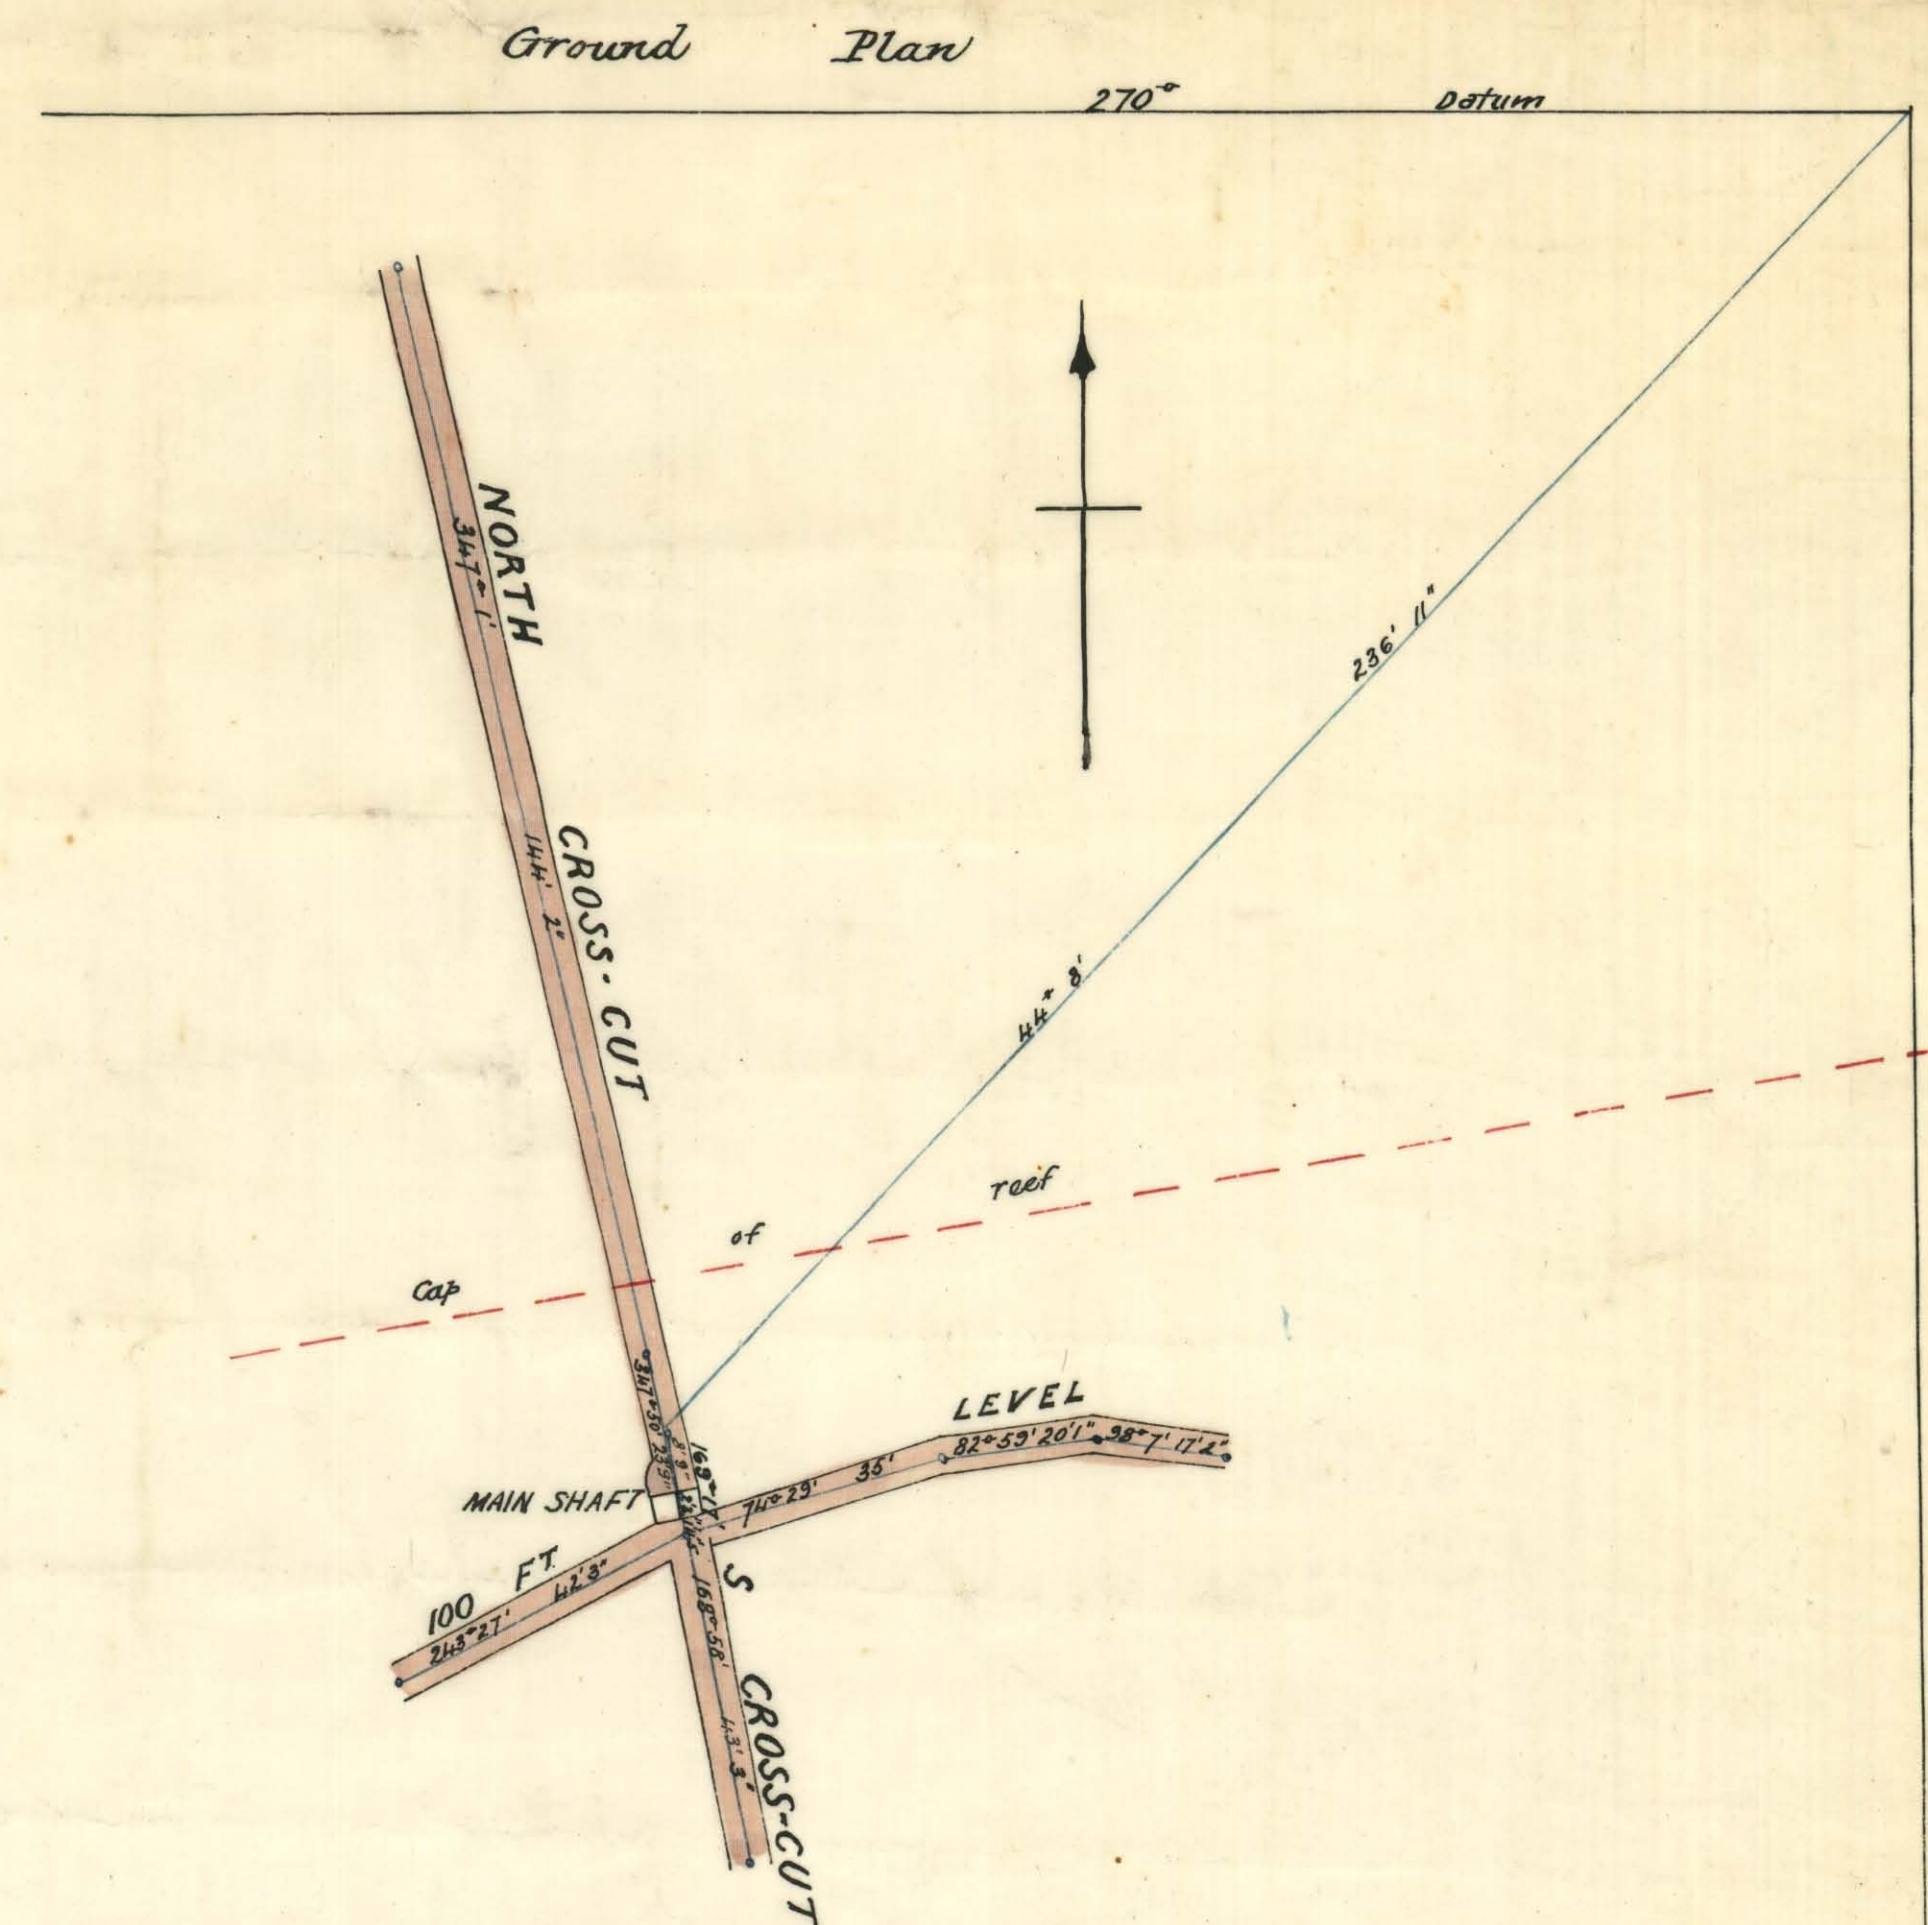


222-01

Lefroy

Scale 25 f^t to an inch

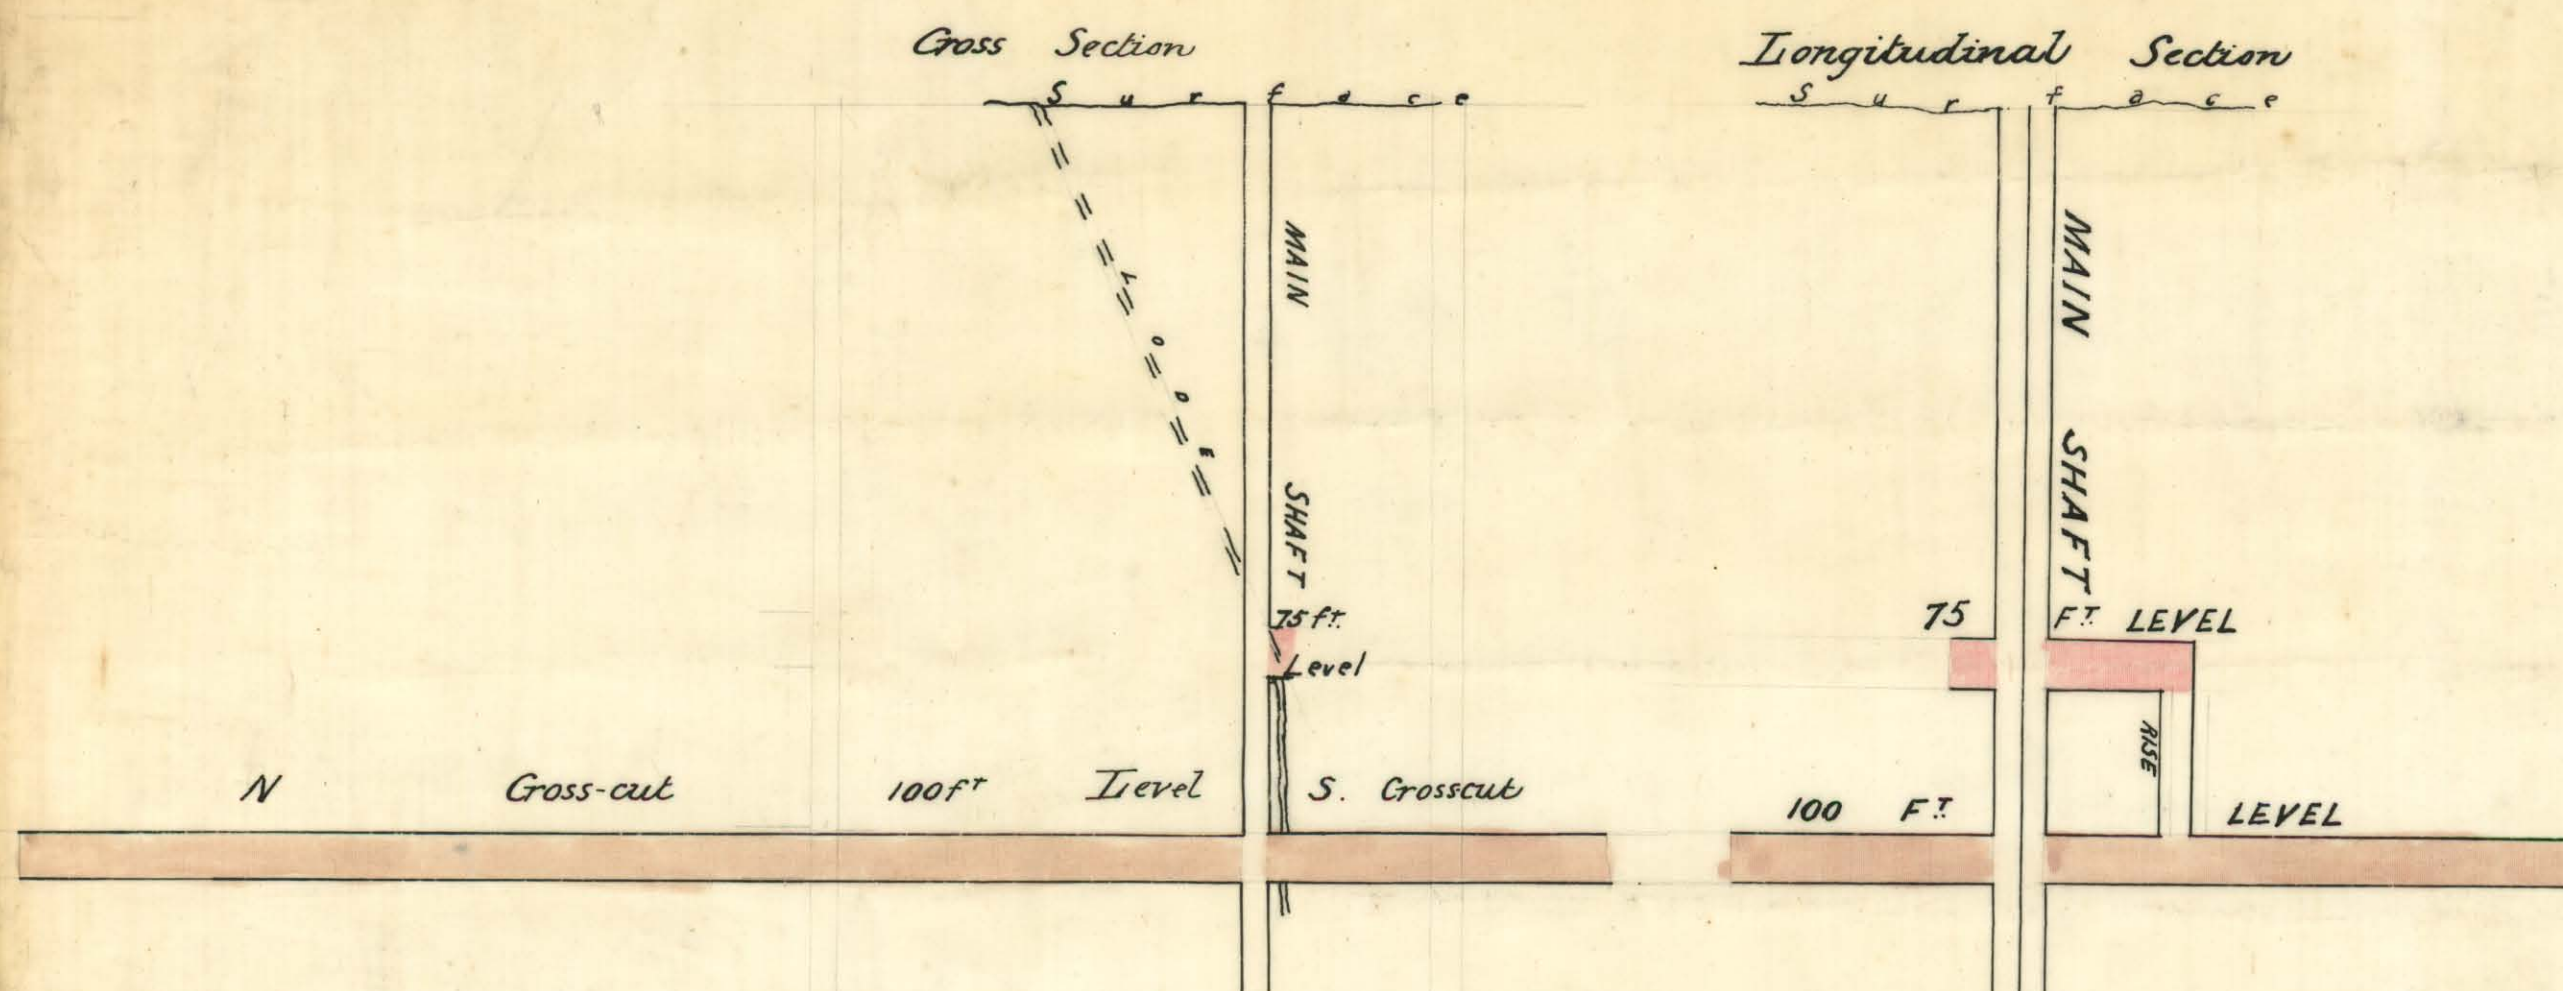

H. J. Mills
Authorized Purveyor
Liverpool
Jan'y '94.