

223-01


223-01

5 cm

DIAGRAM FROM ACTUAL SURVEY

COUNTY OF
MOUNT ZEEHAN
PARISH OF

Scale 50 ¹¹/₁₆ chains to an inch.
Under Ground Workings Silver Queen

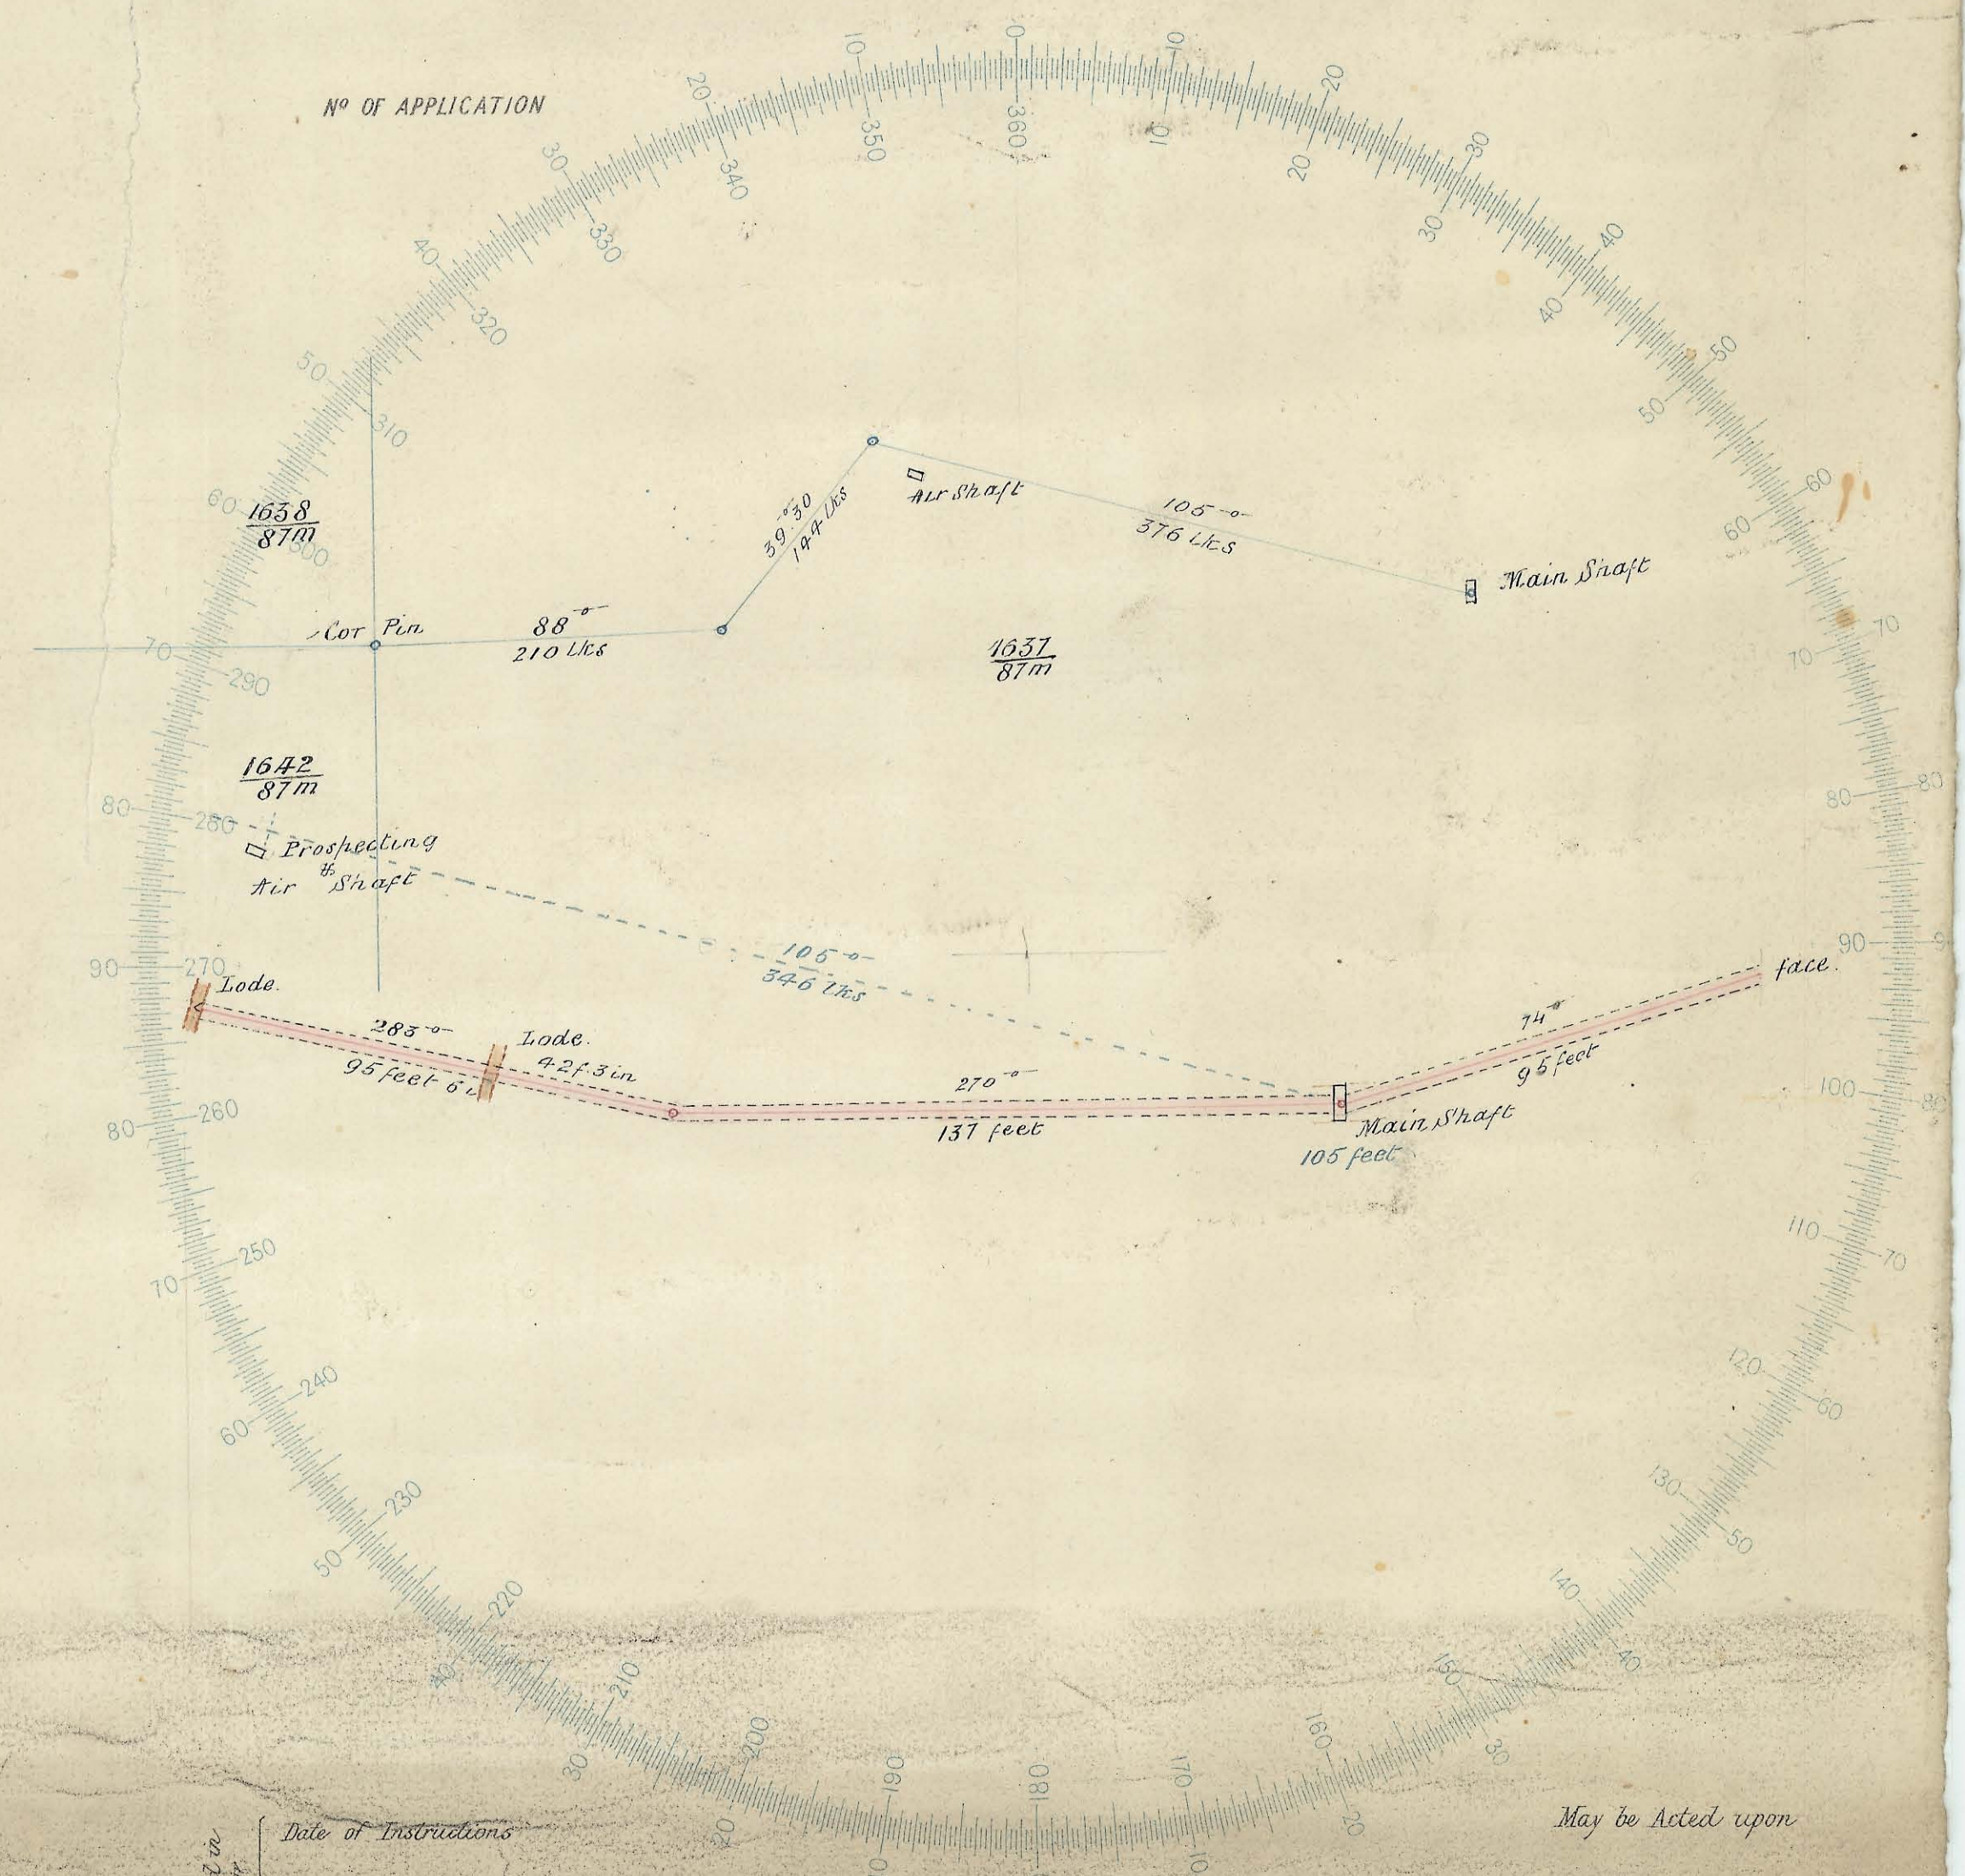

To be filled in by Surveyor	Date of Instructions	May be acted upon	
	Survey commenced		Acted upon
	Survey finished		
	Error of close 1 in		
	Office examination		
Finally examined by			
Entered on General Plan by			

John Brown
Surveyor
March 6 1890