
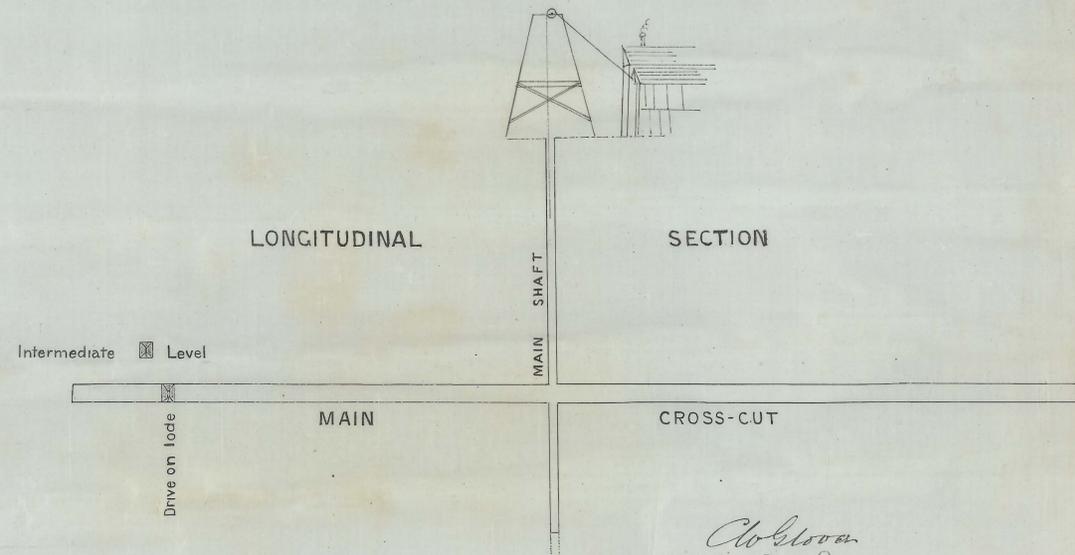
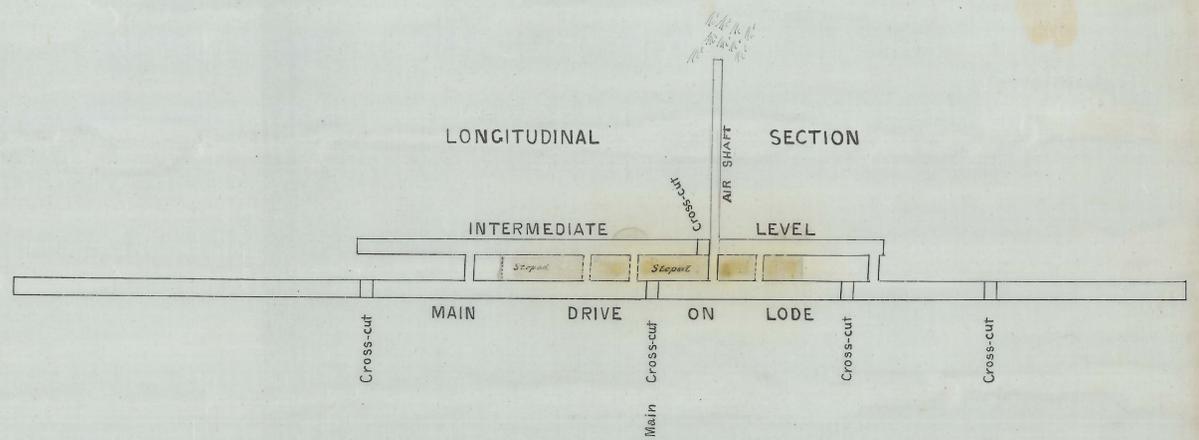


PLAN
OF
UNDERGROUND WORKS
SILVER QUEEN P A.

Scale 30 feet to 1 inch

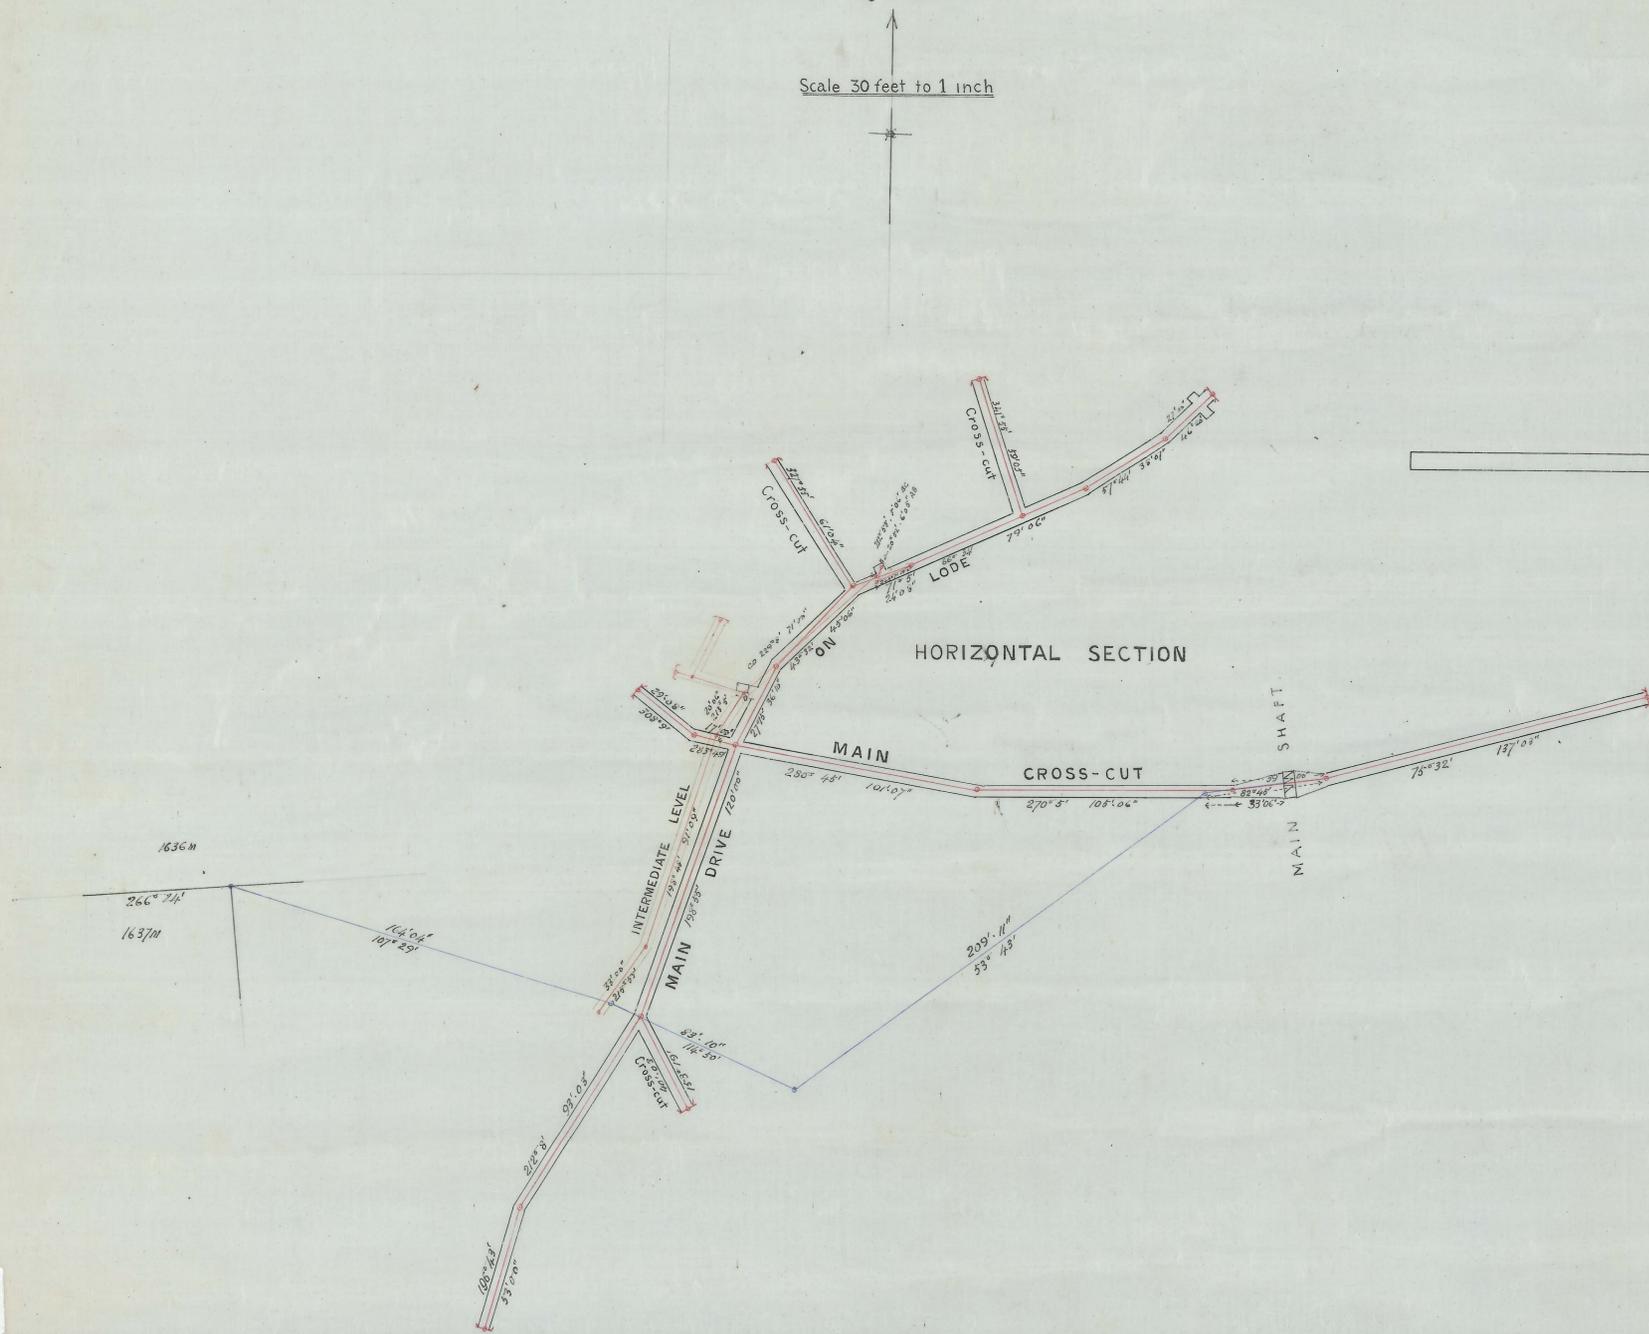

Chas. Glover
Auto Surveyor
Mt. Lachan
June, 1891

223-03

223-03



51

51

5