
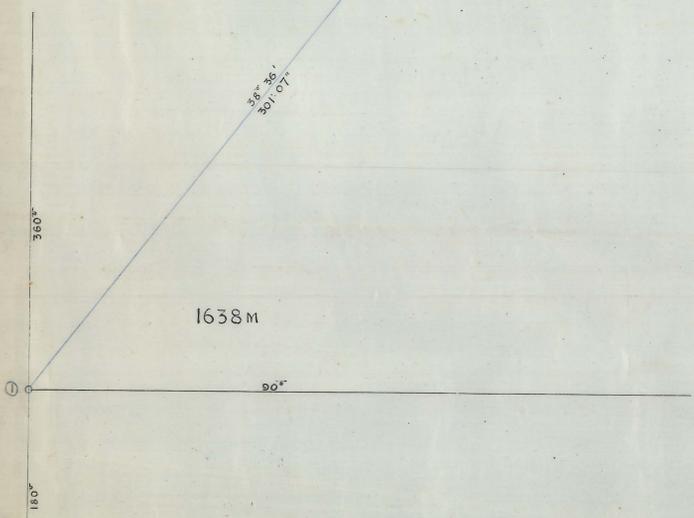
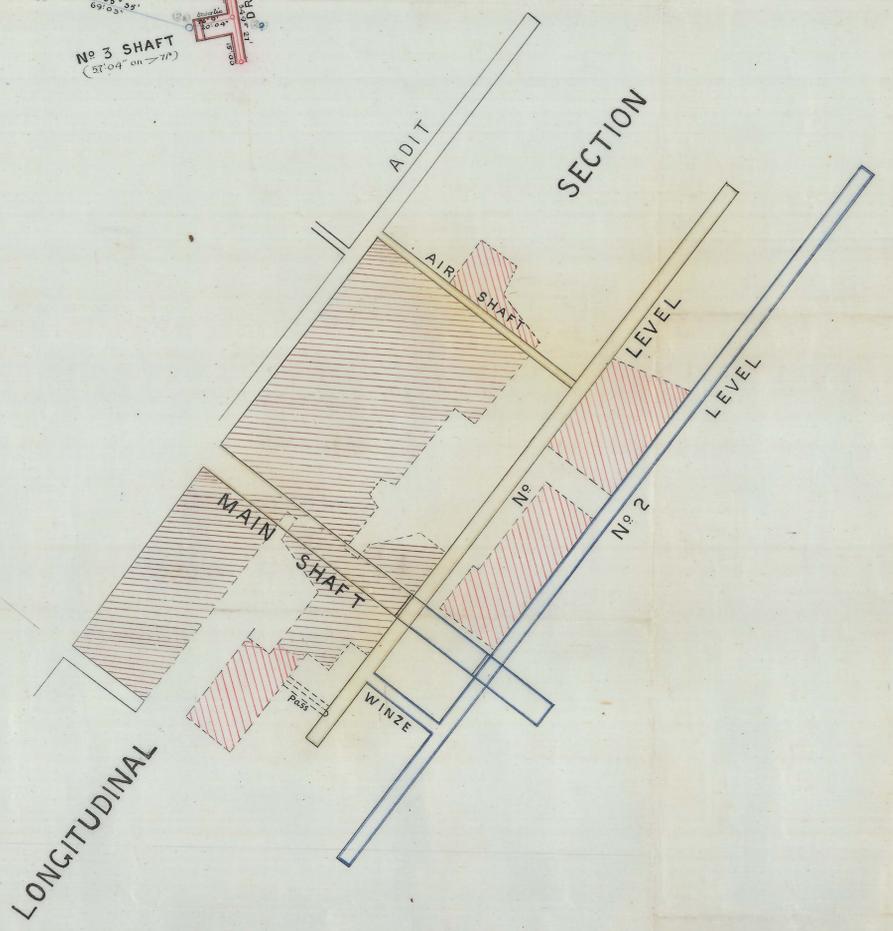
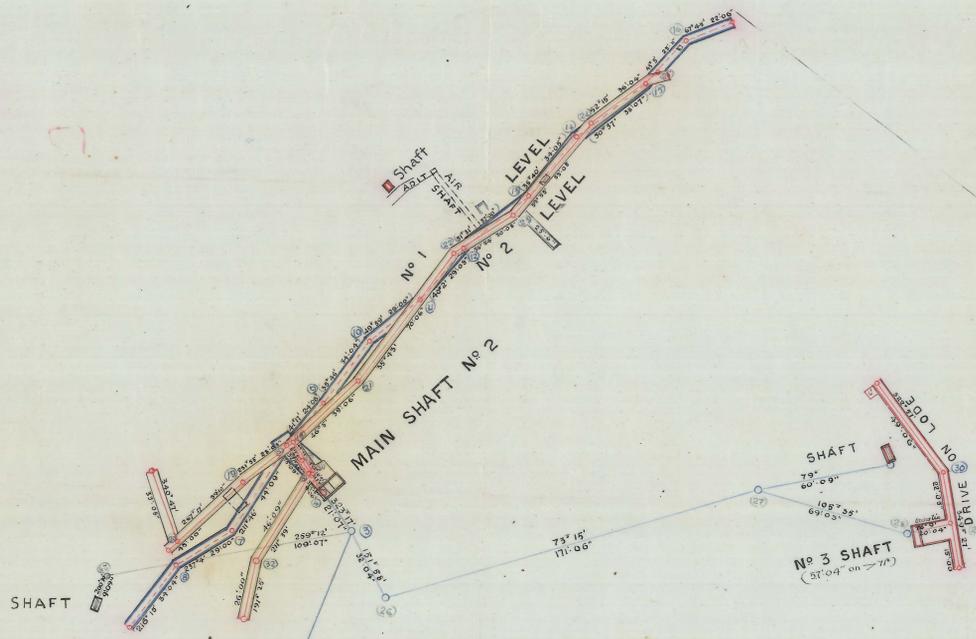
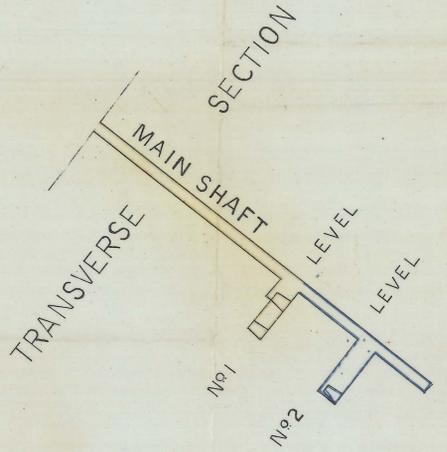


# SILVER QUEEN S.M.

## MINING WORKS

Scale 30 feet to an inch

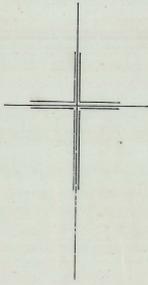

*Charles  
Ad. Surveyor  
Jackson Jan 24/94*

223-05

223-05



51