

223-09

5 cm

223-09


SILVER QUEEN.P.A.

LONGITUDINAL SECTION

N° 4 WORKINGS

MAIN LOSE LOOKING WEST

Scale 30 Feet to One Inch.

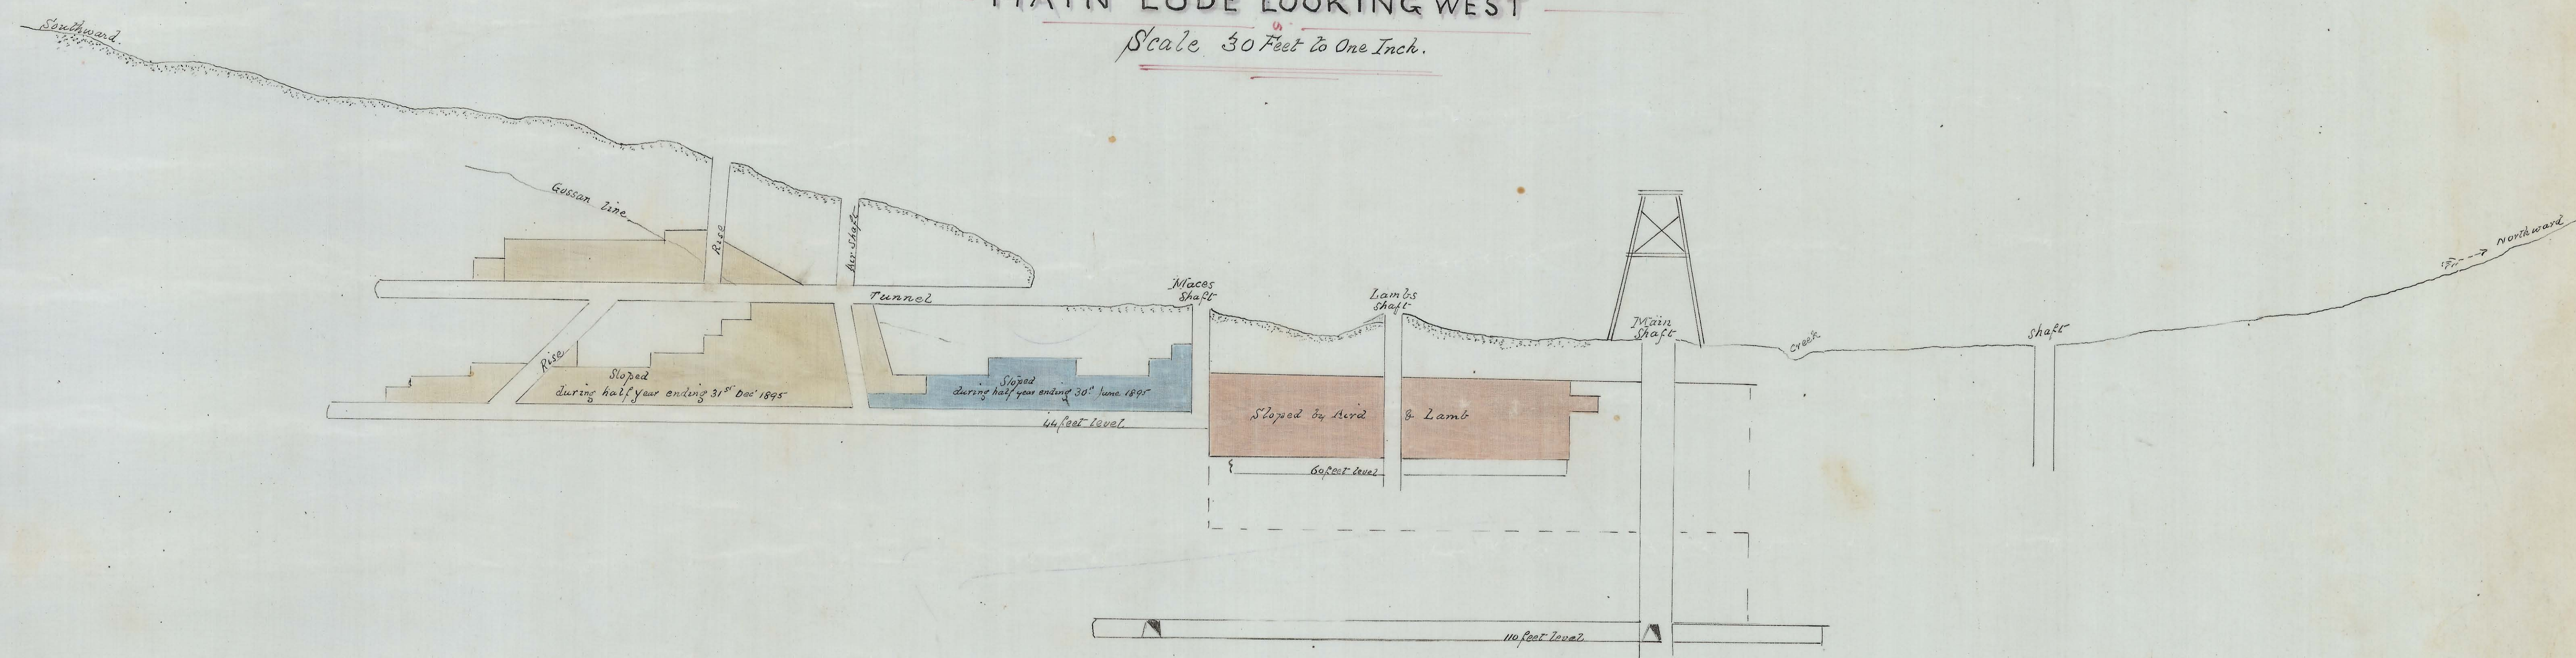

RECEIVED BY MILES BELL
March 20th
1896
LAWSON

for 1895

By Stephen Richardson
mine manager