

223-10


5 cm

223-10

Silver Queen. P. A. no Lia.

Cross Section of Lodes on plane A.B. in N<sup>o</sup> 4 Workings

Scale 30 feet to 1 Inch

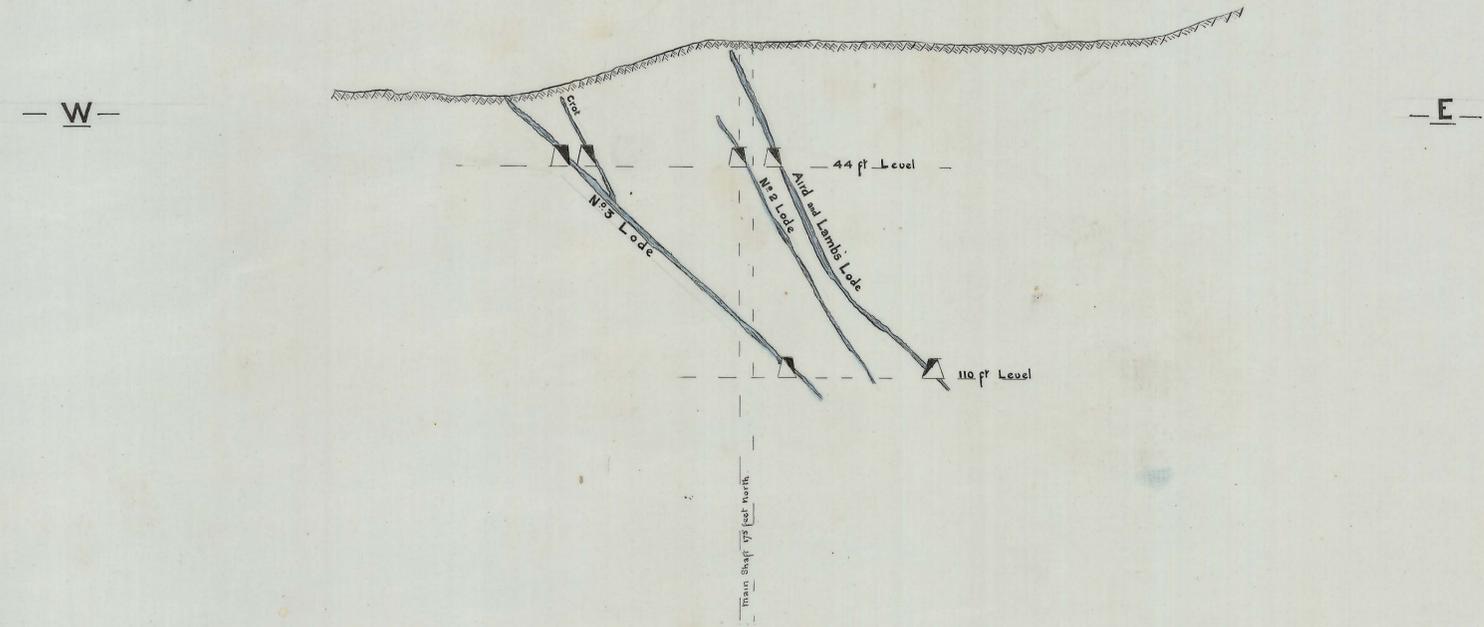

I certify this  
 Section to be correct  
 Stephen Richards  
 Mining Manager

