

223-11

# SILVER QUEEN P A N L


## N° 3 WORKINGS

— Longitudinal Section —  
— of —  
— James N° 3 Lode —

— Scale 30 ft to 1 Inch —

N

S

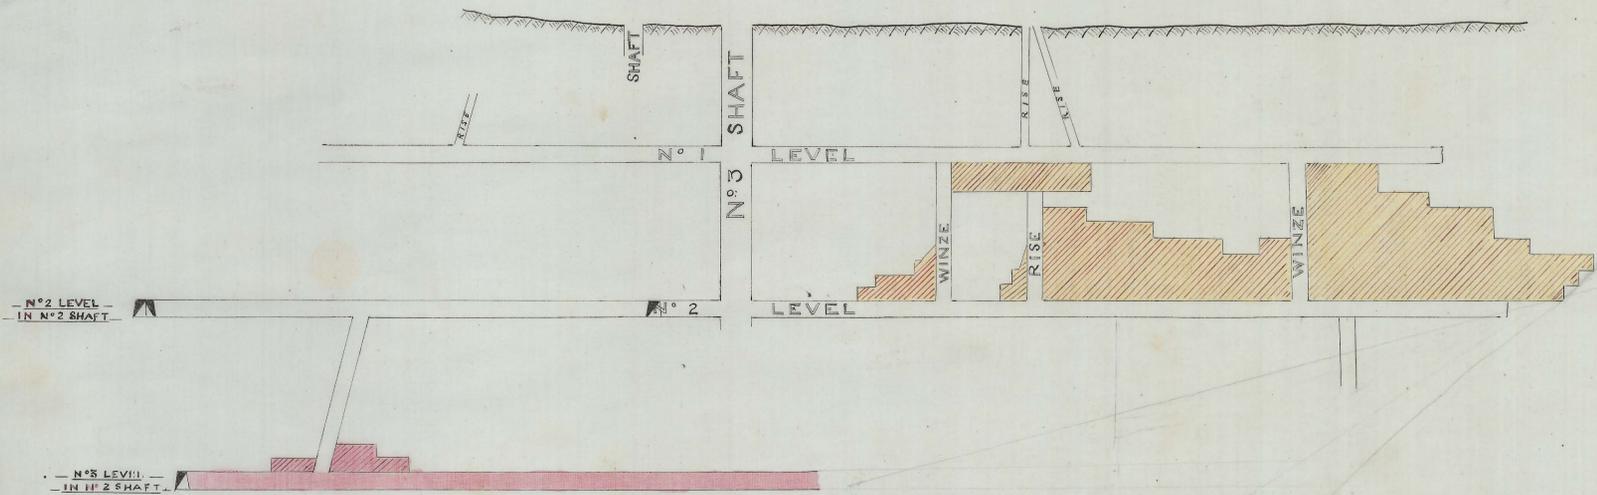

*Reference* —

 Dipping down to October 1896 —

 Ditto " during half year ending December 1896 —



I certify this Section  
to be correct —

*Stephen Richard*  
Mining Manager