

223-12

SILVER QUEEN. P. A. N. L.

Nº 2 WORKINGS


Scale 30 ft to 1 Inch

Longitudinal Section
of
Sinclair's Nº 2 Lode

SW

NE

for 1896

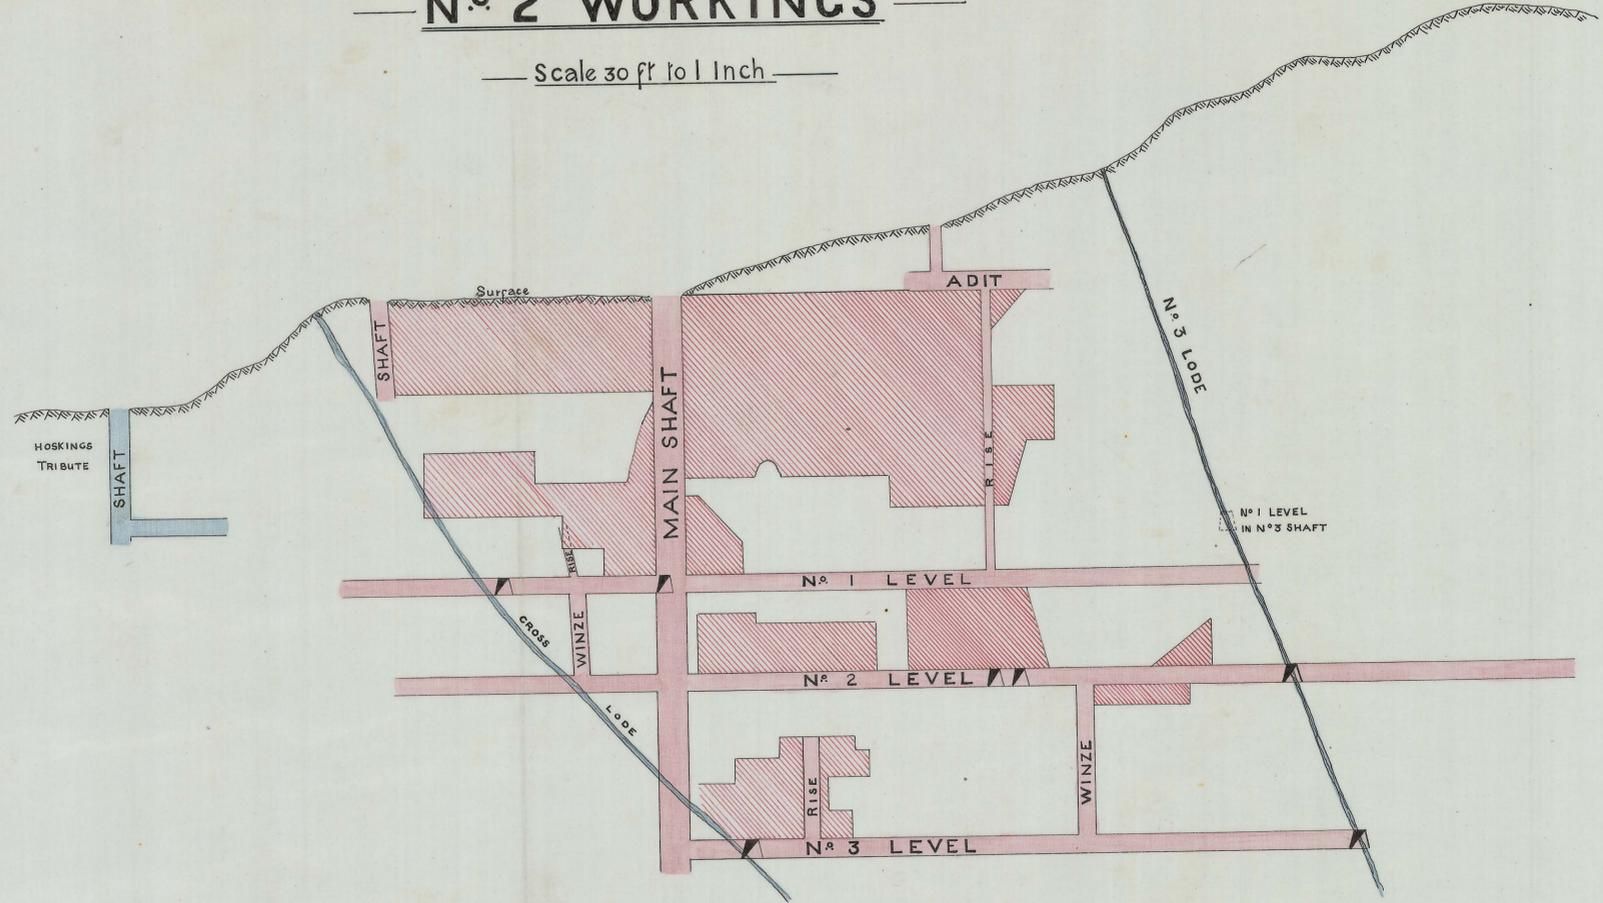

Reference
 Dipping down to Cadwin 1895



I certify this Section
 to be correct -
 Stephen Richards
 Mining Manager