

223-13


SILVER QUEEN P A N L

N° 4 WORKINGS

Scale 30 ft to 1 inch

Longitudinal Section

N° 4 Main Lode

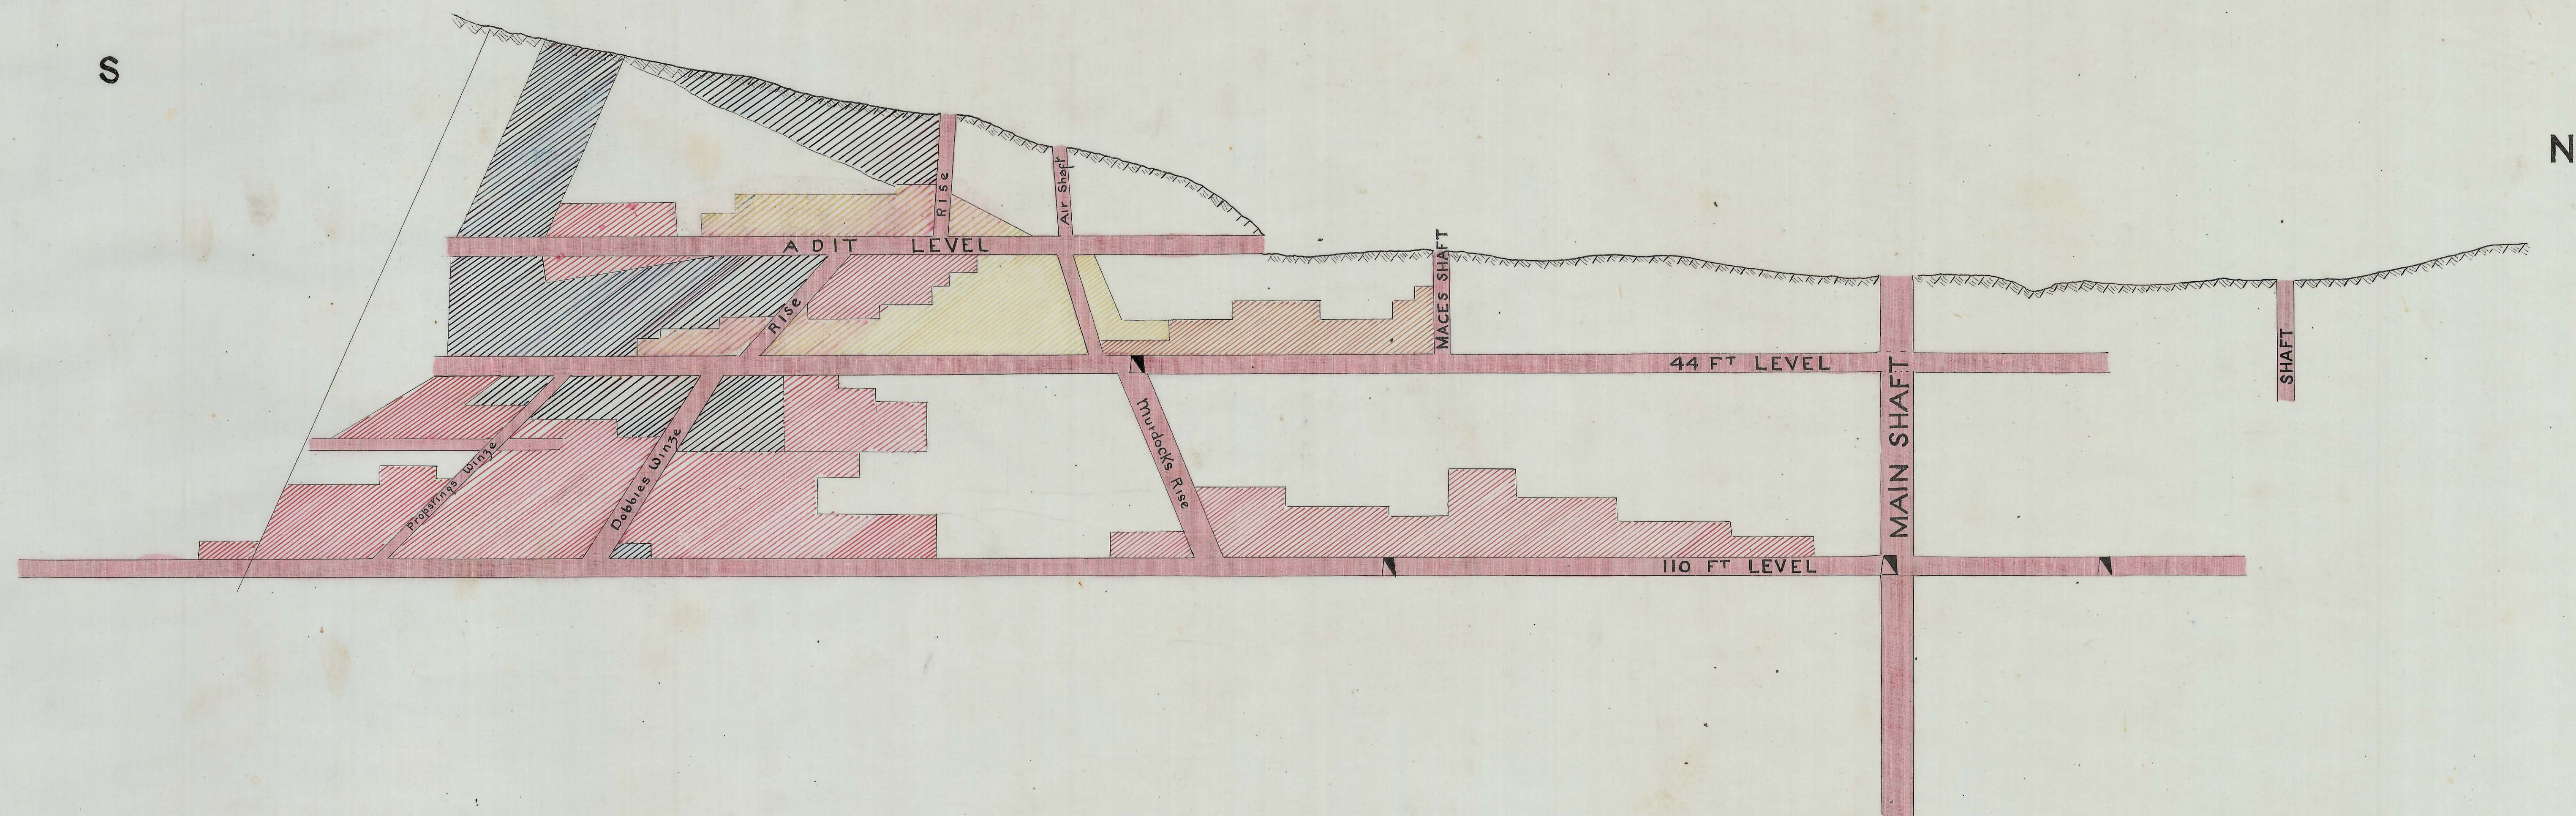

Reference

	Stoping done to June 30 th 1895
	December 31 st 1895
	June 30 th 1896
	December 31 st 1896



I certify this Section
to be correct
Steph. Richards
Mining Manager