

15

15

SILVER QUEEN P.A.N.L.





Longitudinal Section
on
— Clarkes Lode —

— N^o 4 WORKINGS —

— Scale 30 ft to 1 Inch —

N

S

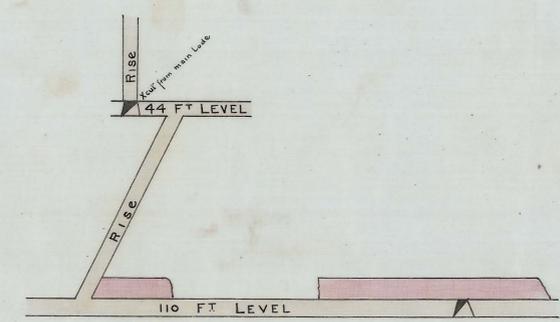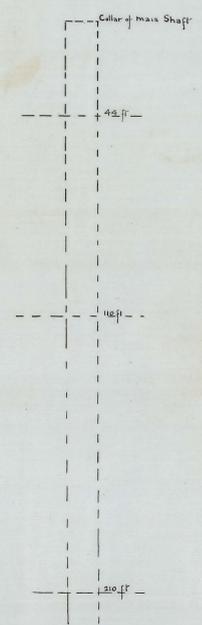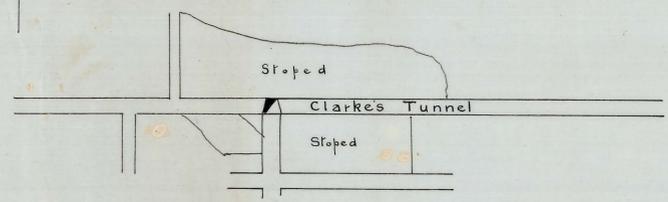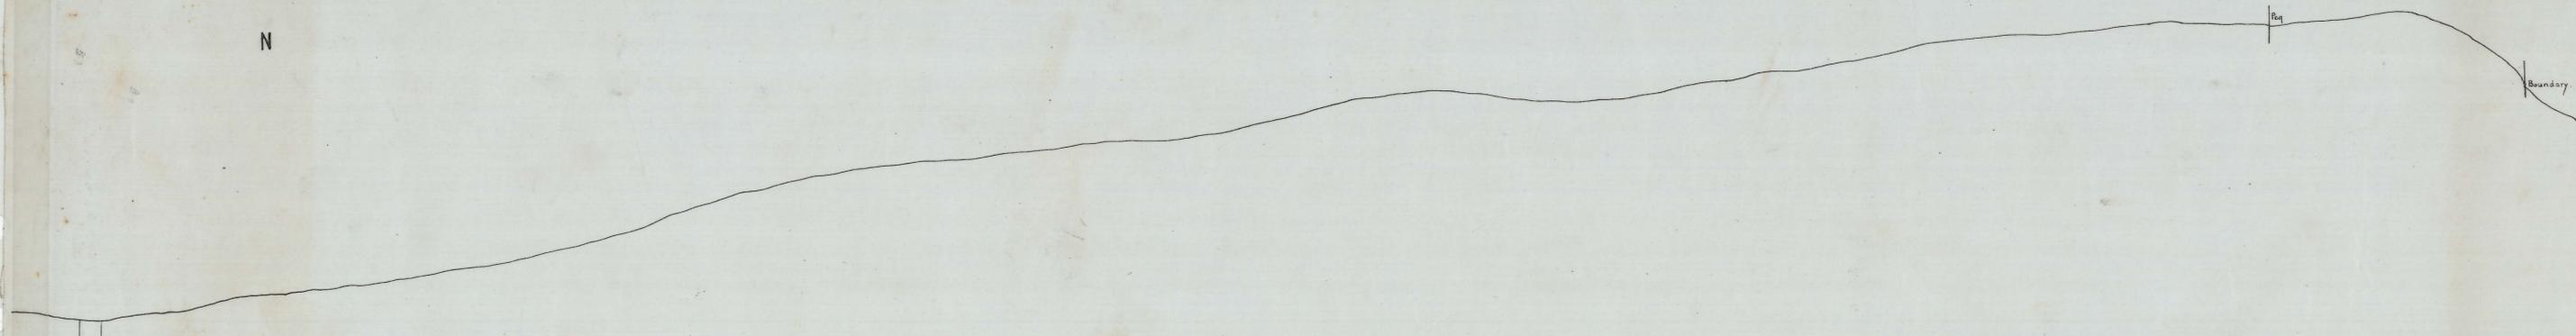

223-15

223-15



Mark colors yellow and red showing rising & falling for year 1891
 " " Red " Sloping
 J.B.

51

51