

— SILVER QUEEN P.A.M.L. —
— N^o 3 WORKINGS —

— Longitudinal Section —
of
— James N^o 3 Lode —


— Scale 30 ft to an Inch —



223-16

N

S

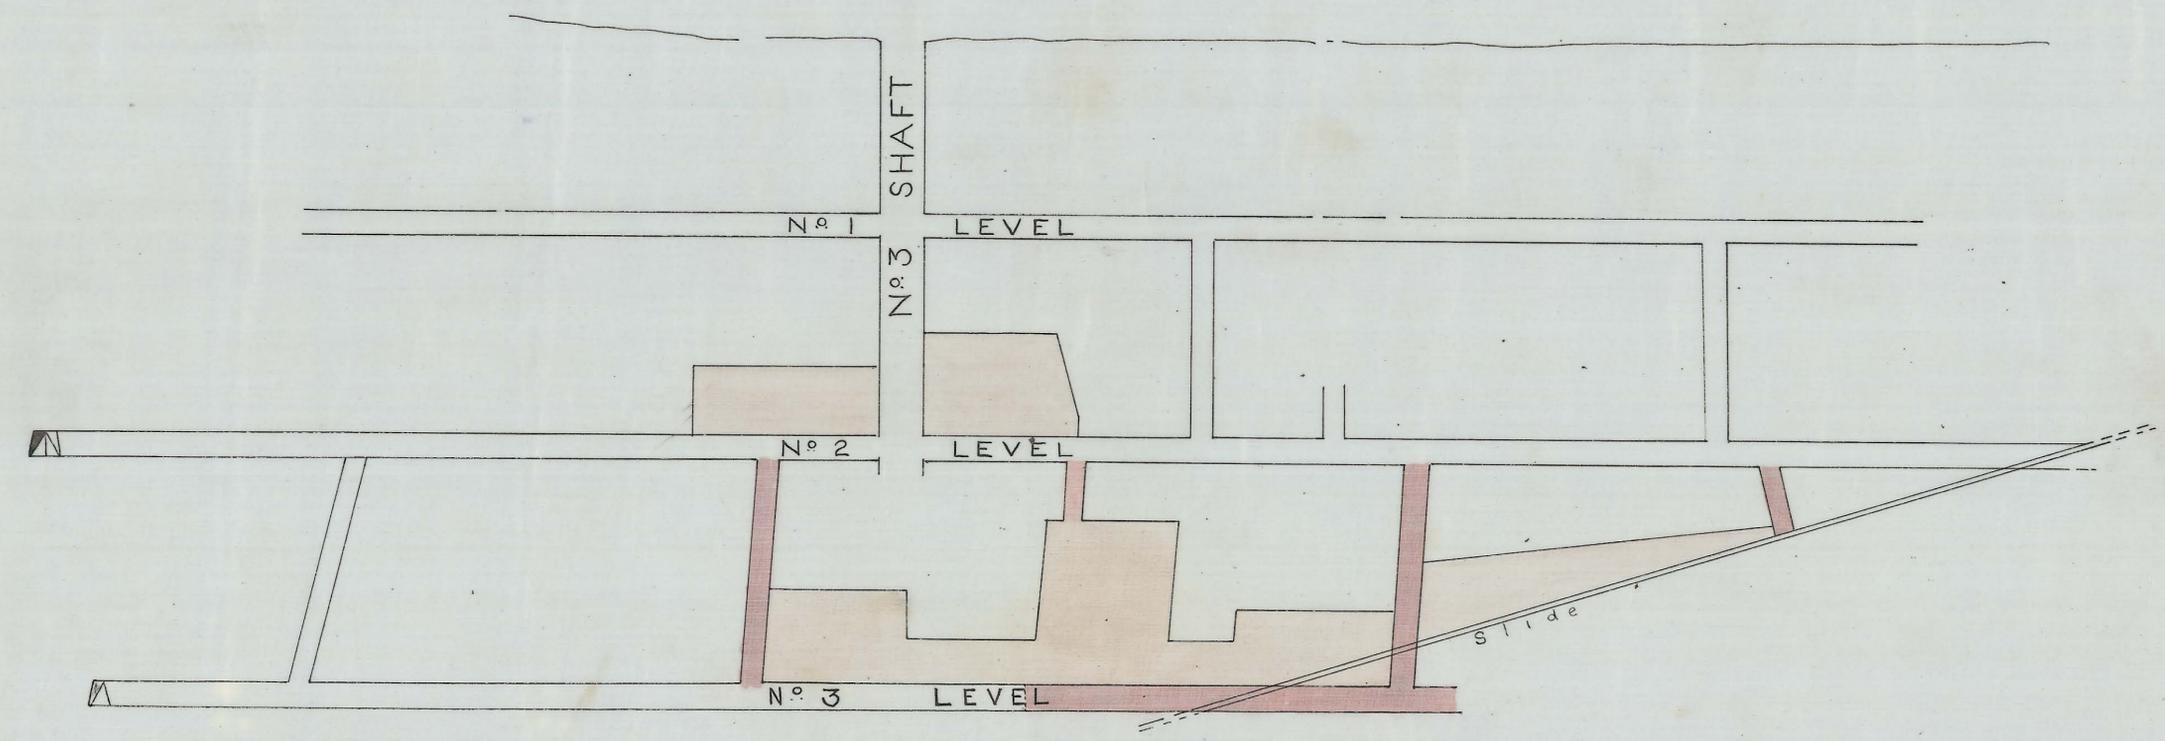

Portions colored Red made during + rising for 1897
" Yellow " Slipping " " " 1897.

S.R.



223-16

51

51