

223-18

5 cm

223-18

# SILVER QUEEN P A N L

## Nº 4 WORKINGS


Scale 30 ft to 1 inch

— Longitudinal Section —  
— on —  
— Nº 4 Main Lode —



S

N

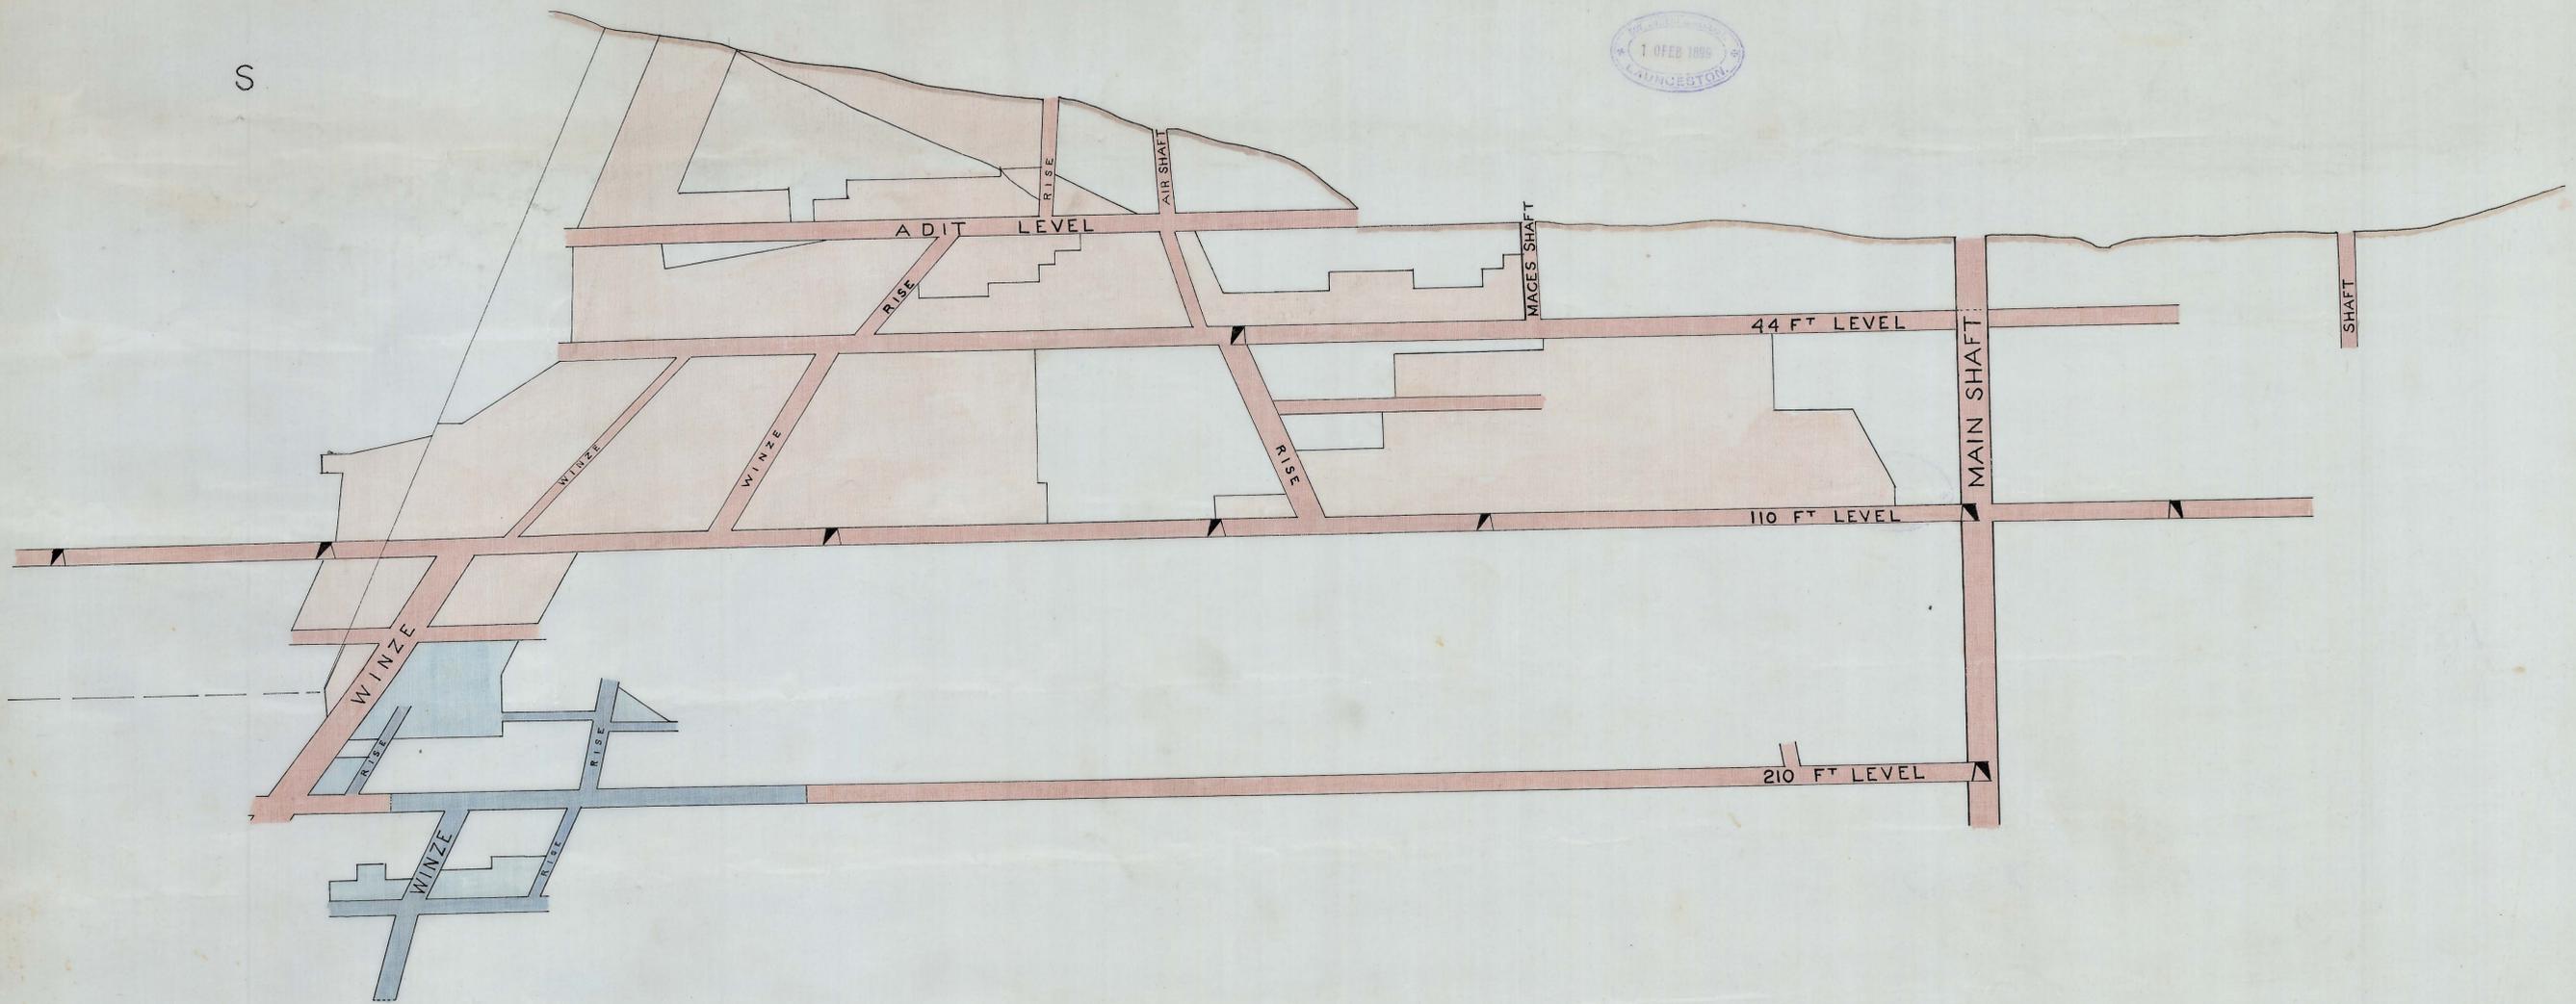

Work done to December 31<sup>st</sup> 1897.  
 " " during Year ending Dec 31<sup>st</sup> 1898.

I certify this Section to be correct  
 Steph Richard  
 Mining Manager  
 14.1.1899